



IRA
CURVE #5
 $\Delta = 04^{\circ} 37' 28''$
 $D = 01^{\circ} 33' 15''$
 $R = 3683.61'$
 $T = 148.85'$
 $L = 297.55'$
 $E = 3.00'$

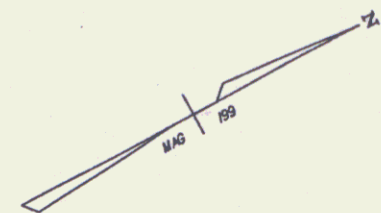

IRA
CURVE 6
 $\Delta = 28^{\circ} 25' 43''$
 $D = 05^{\circ} 10' 06''$
 $R = 1108.57'$
 $T = 280.81'$
 $L = 550.05'$
 $E = 35.01'$

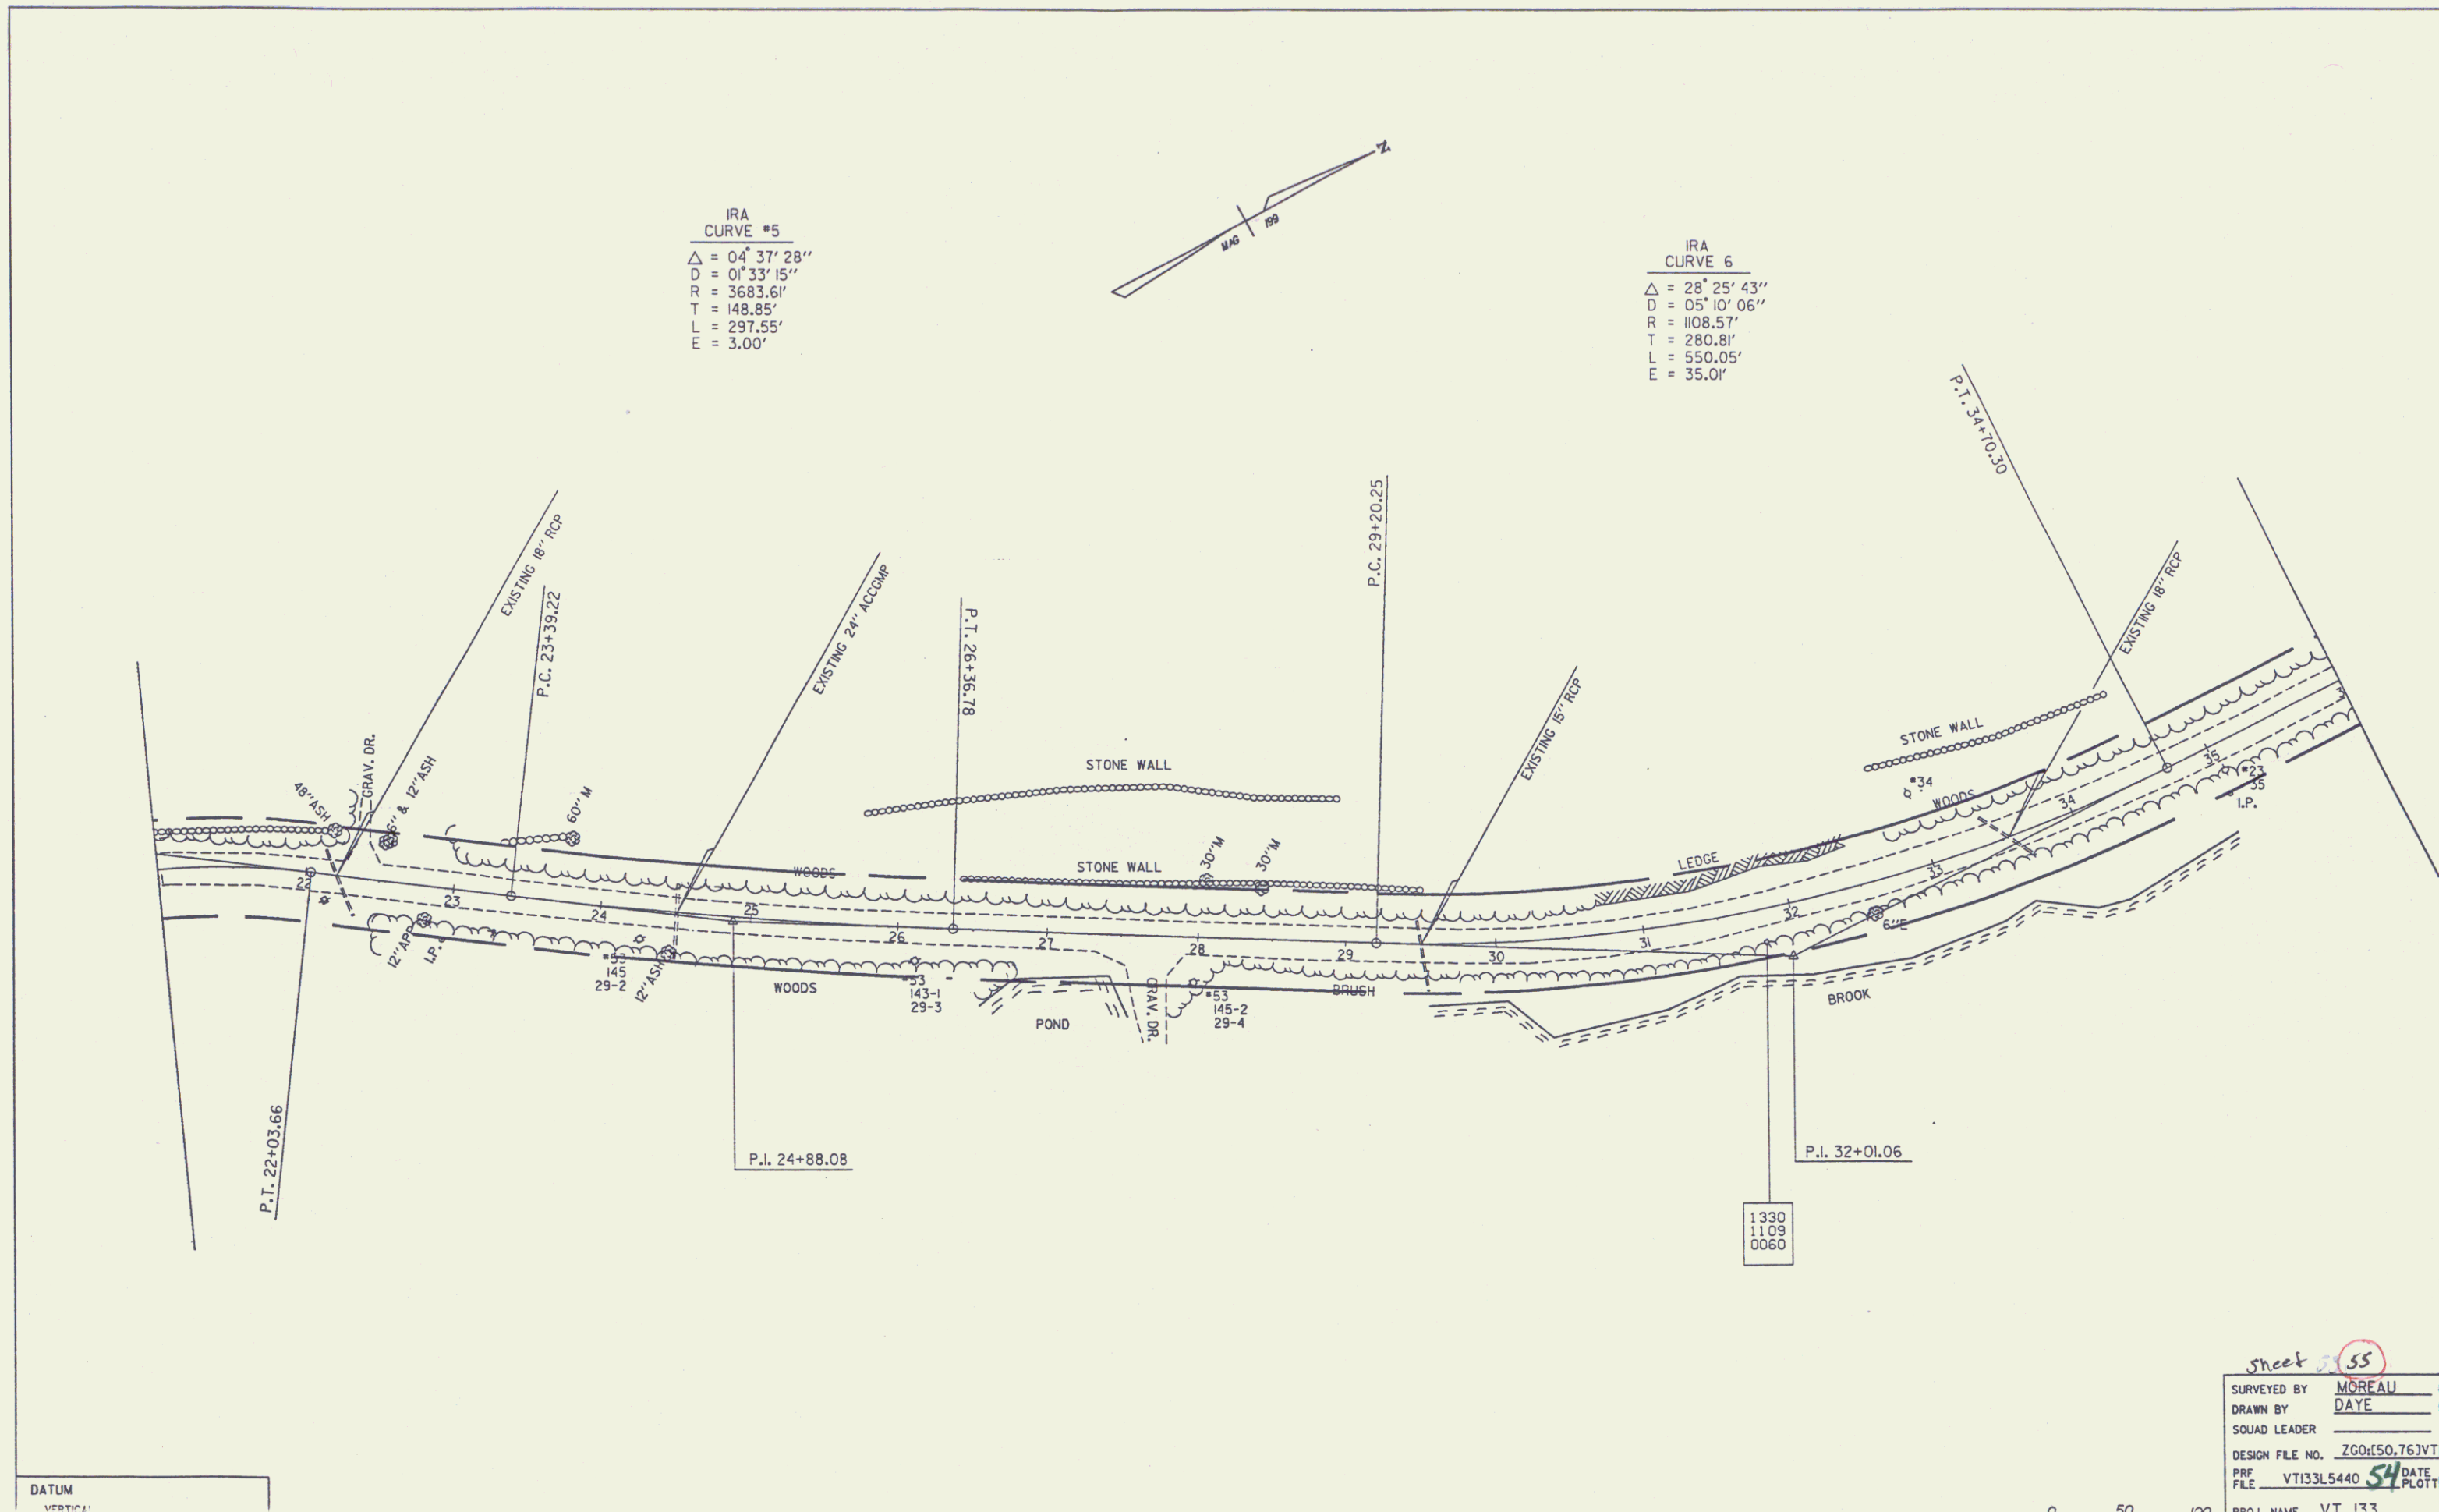

DATUM
VERTICAL

1330
1109
0060

Sheet 55
 SURVEYED BY MOREAU
 DRAWN BY DAYE
 SQUAD LEADER
 DESIGN FILE NO. ZG0K50.T6JVT
 PRF VT133L5440 DATE 5/14/04
 FILE DATE PLOT
 PROJ. NAME VT 133