
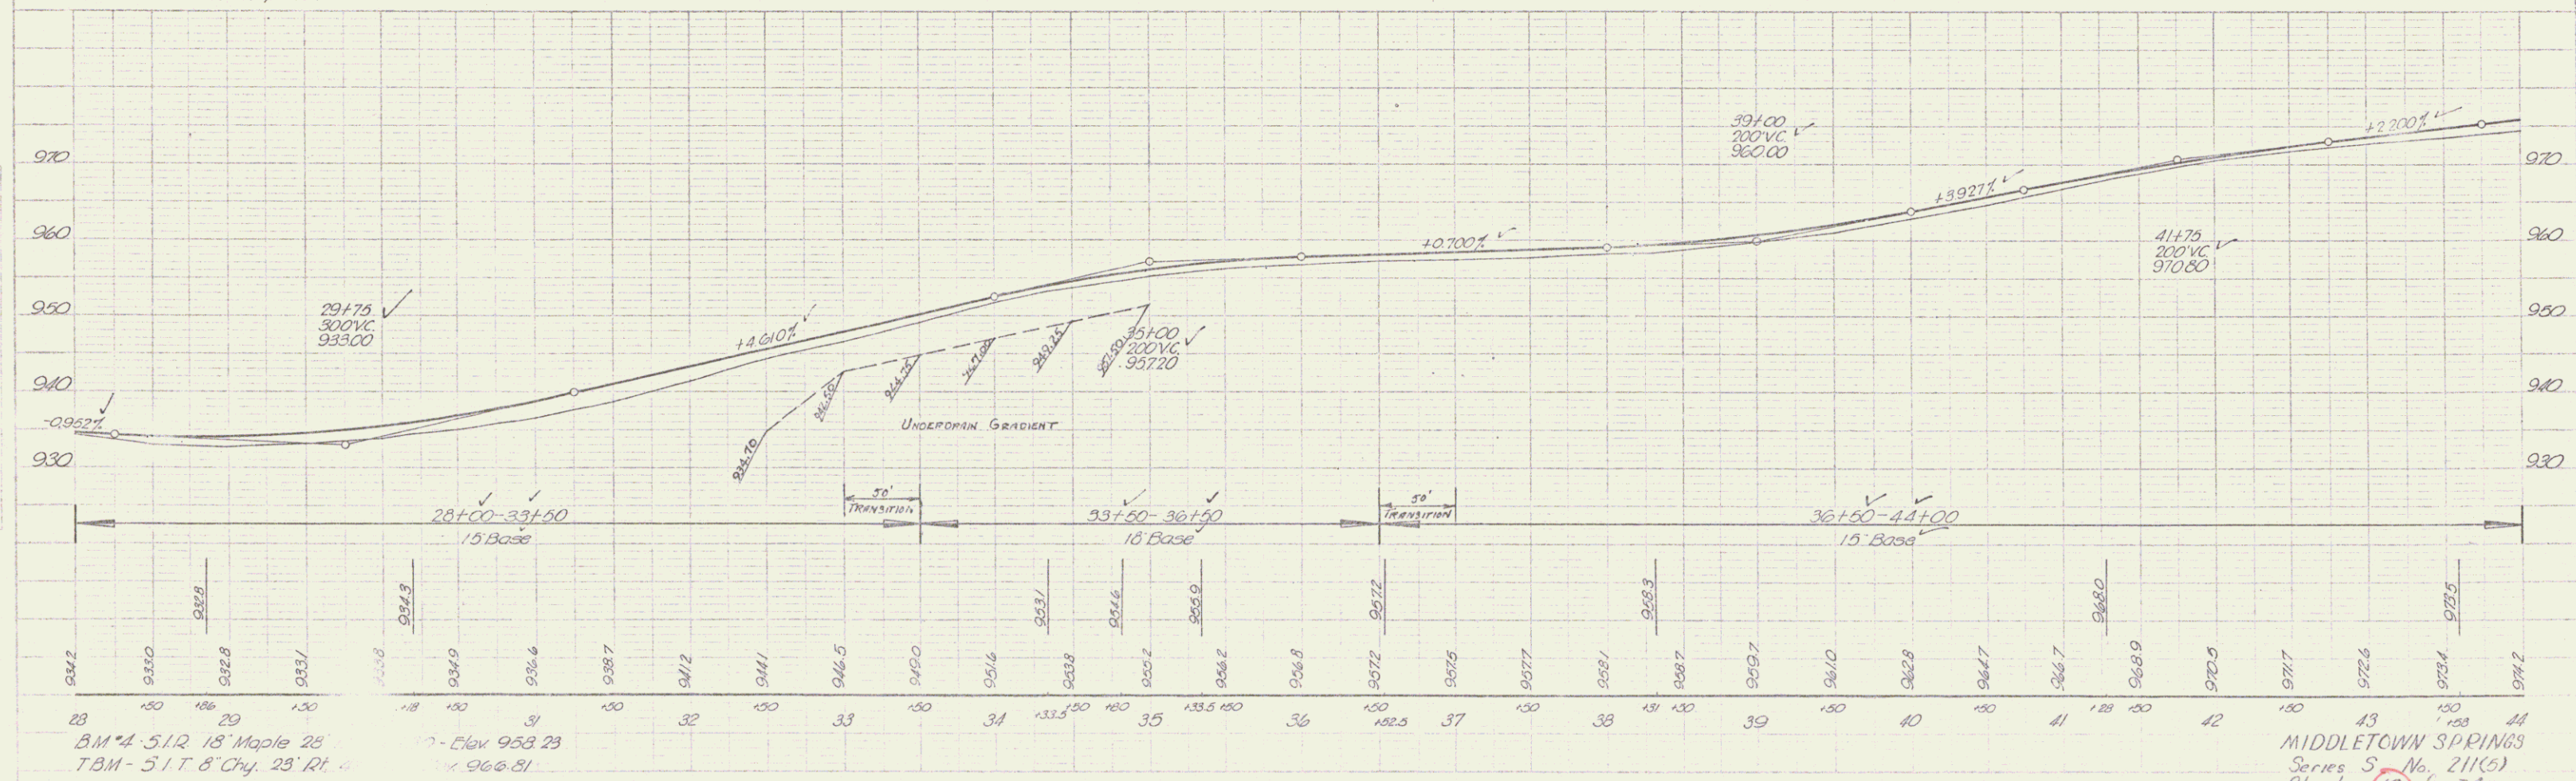


PLAN	Profile	Shells	167
Sheet	Surface		
Traced			

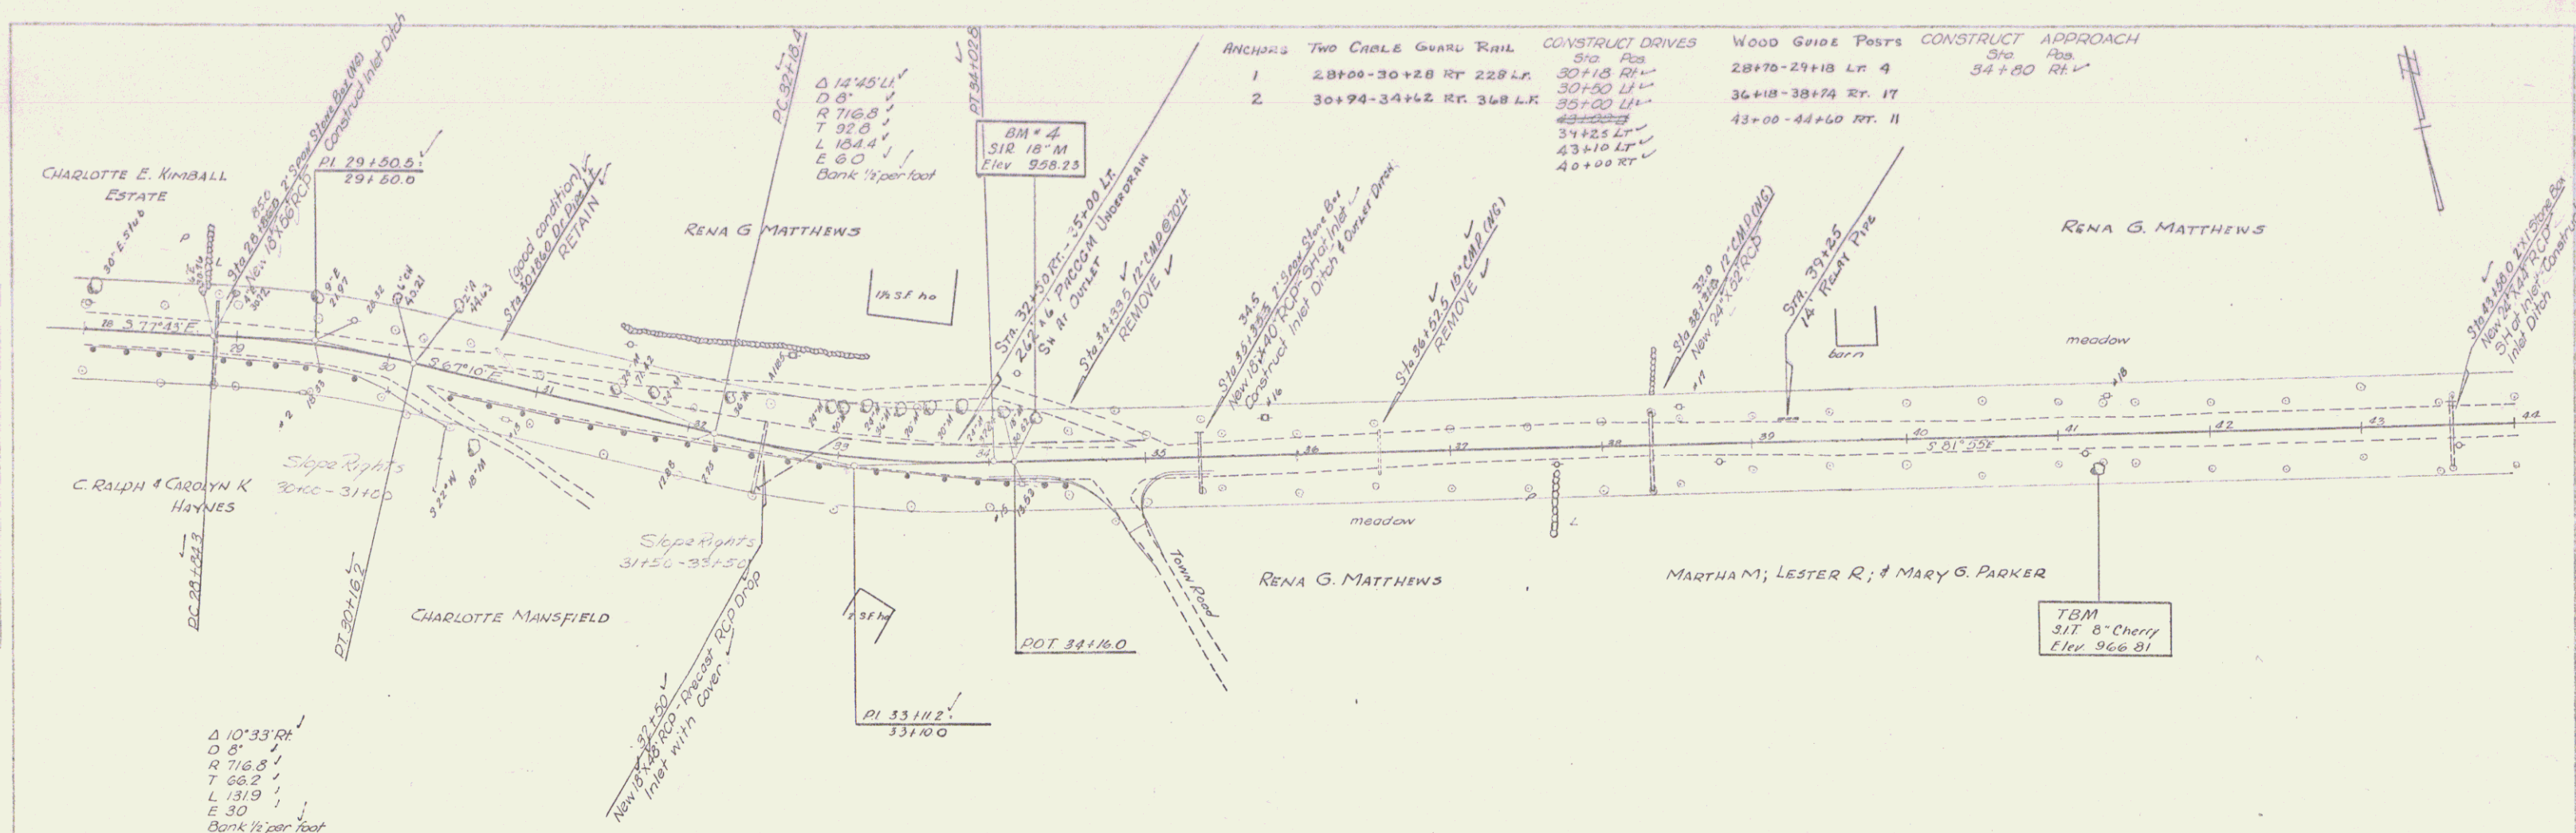

BM # 4 S.I.R. 18" Maple 28' Elev 958.23
 TBM - S.I.T. 8" Chy. 28' Rt. Elev 966.81
 MIDDLETOWN SPRINGS
 Series S No. 211(5)
 Sheet 12 of 34