


PLAN
 12/24/23
 2:35
 Appor Hurley
 #23

PROFILE
 12/24/23
 2:35
 Appor Hurley
 #23

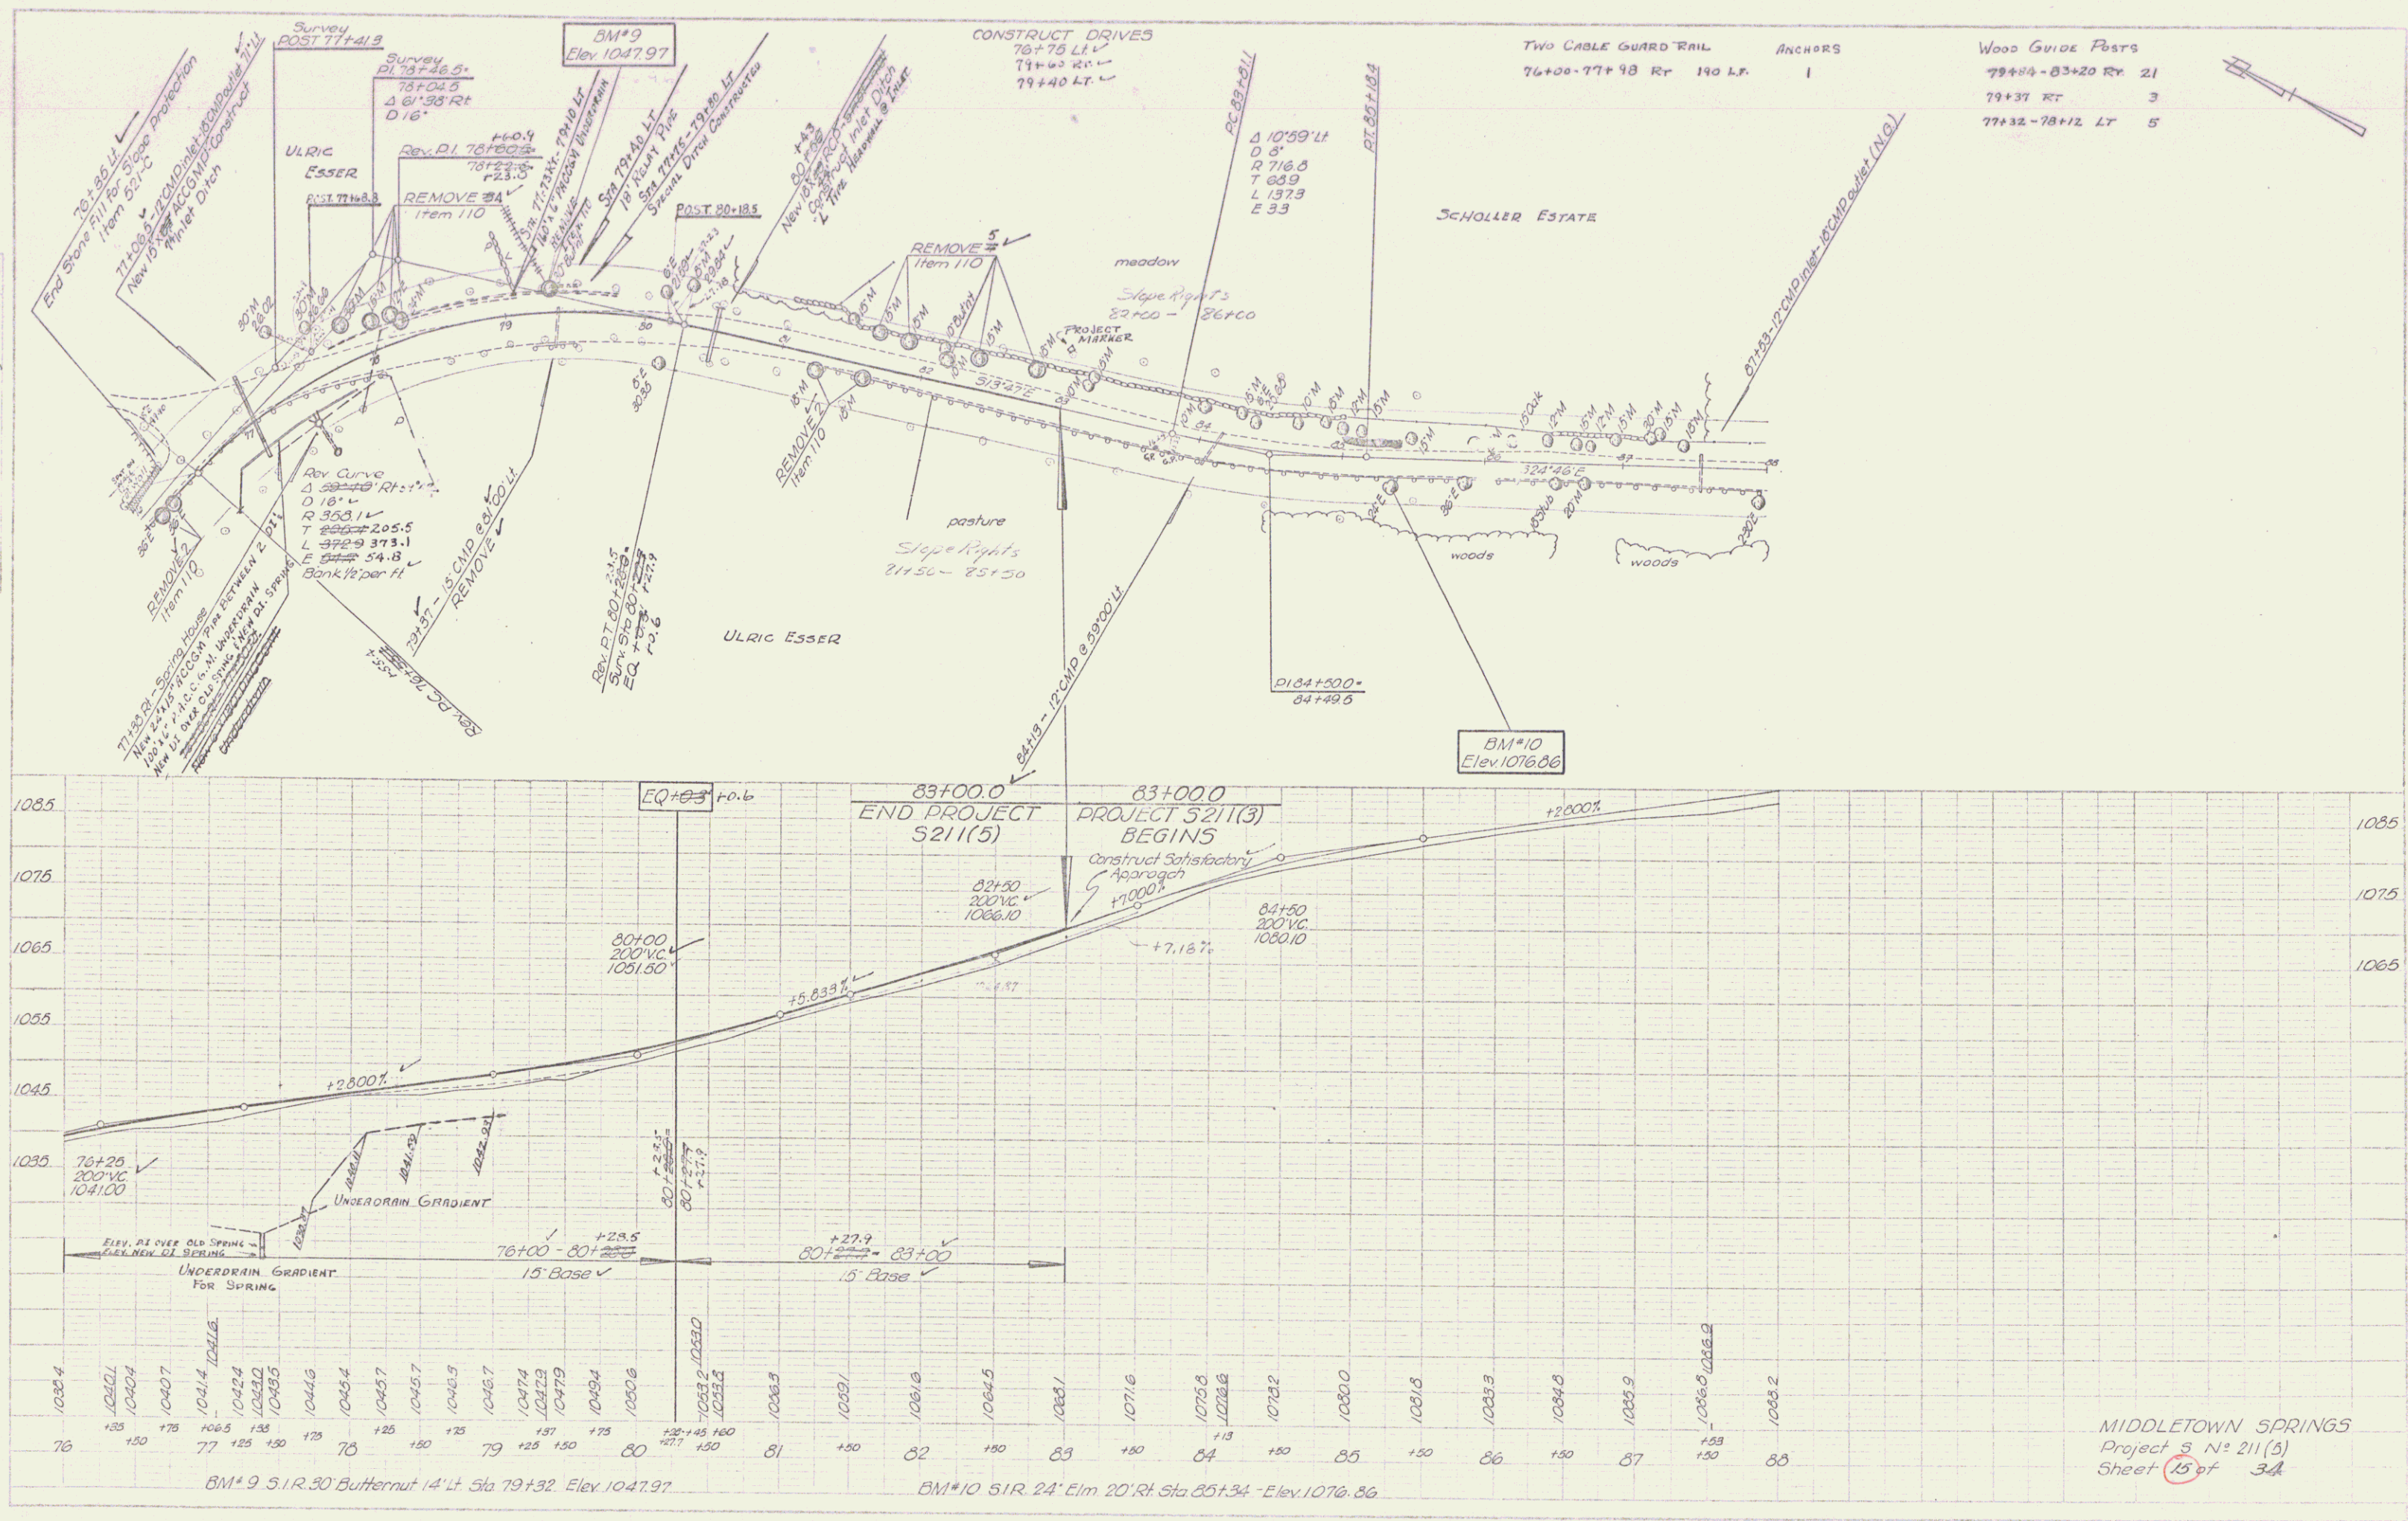

MIDDLETOWN SPRINGS
 Project S N° 211(5)
 Sheet 15 of 3A