
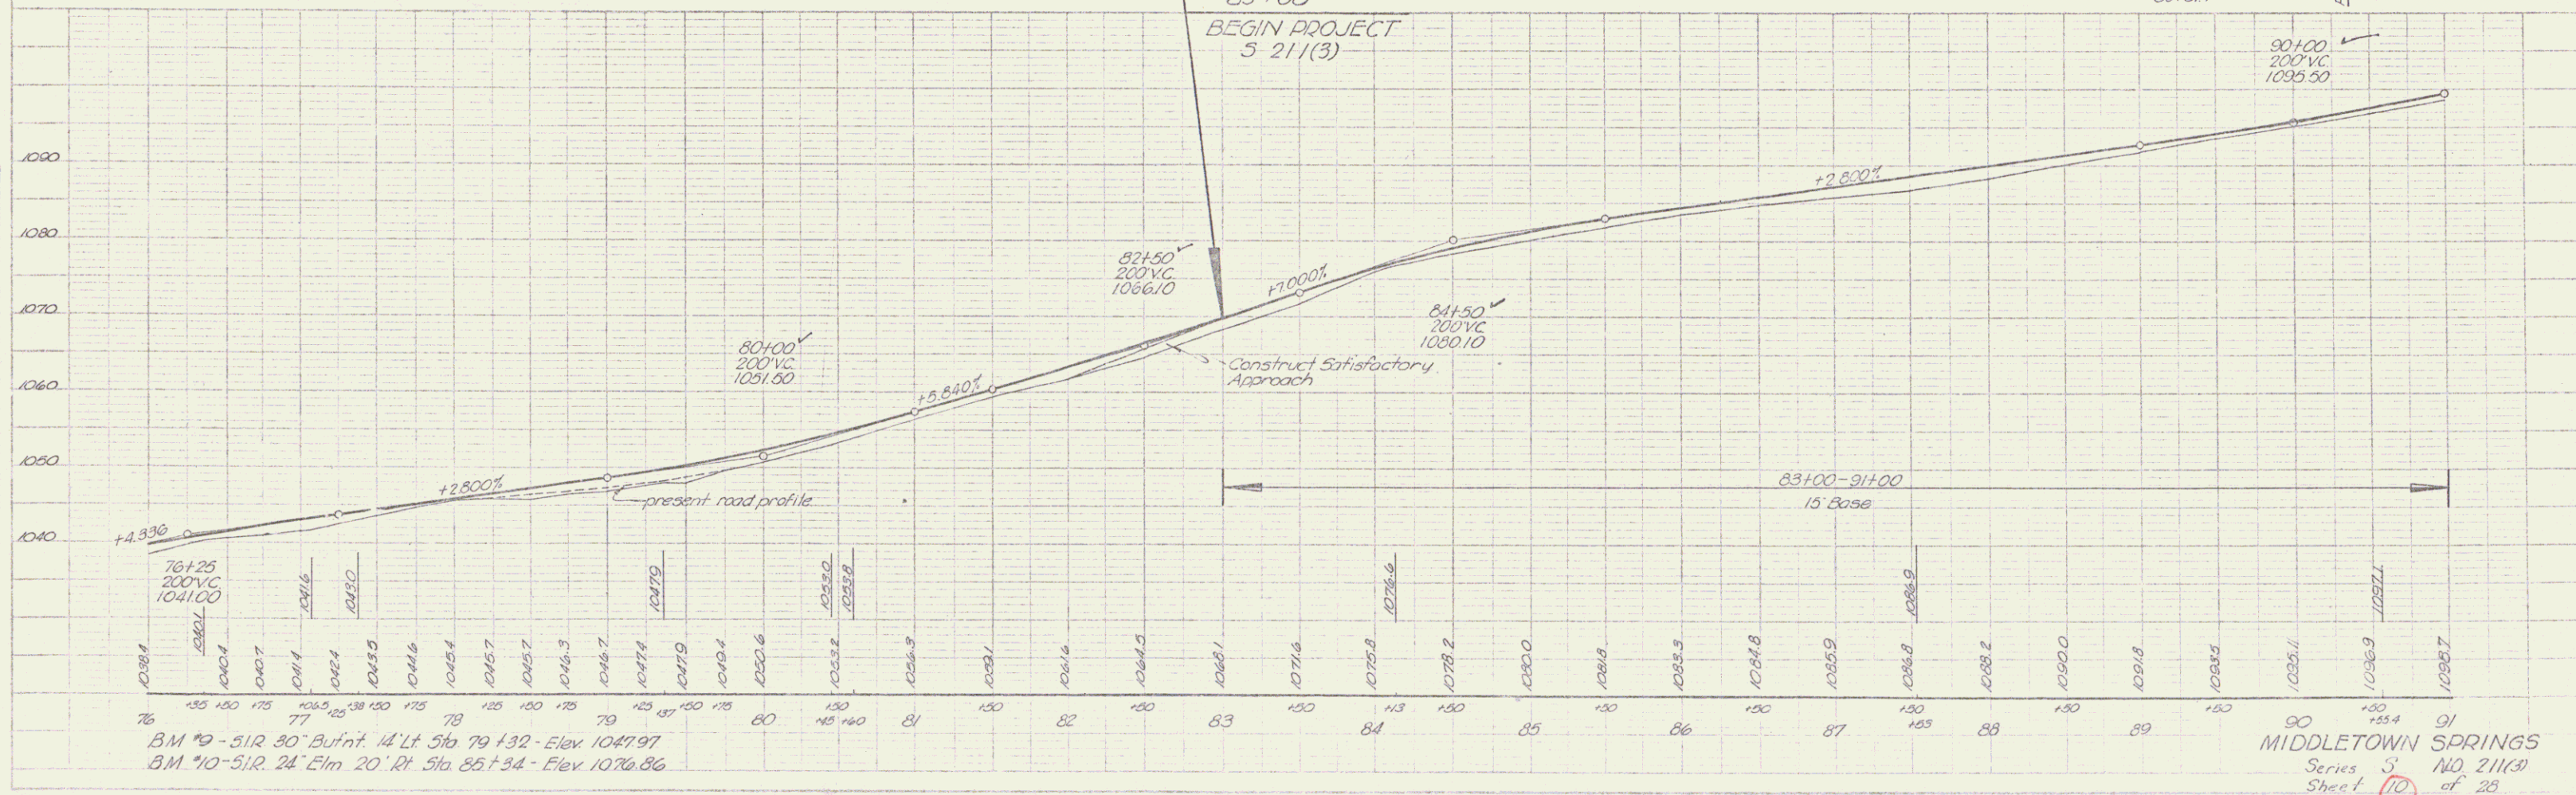


|       |       |
|-------|-------|
| 17-88 | Major |
| 17-89 | Sub   |
| 17-90 | Sub   |
| 17-91 | Sub   |
| 17-92 | Sub   |
| 17-93 | Sub   |
| 17-94 | Sub   |
| 17-95 | Sub   |
| 17-96 | Sub   |
| 17-97 | Sub   |
| 17-98 | Sub   |
| 17-99 | Sub   |
| 18-00 | Sub   |
| 18-01 | Sub   |
| 18-02 | Sub   |
| 18-99 | Sub   |
| 19-00 | Sub   |

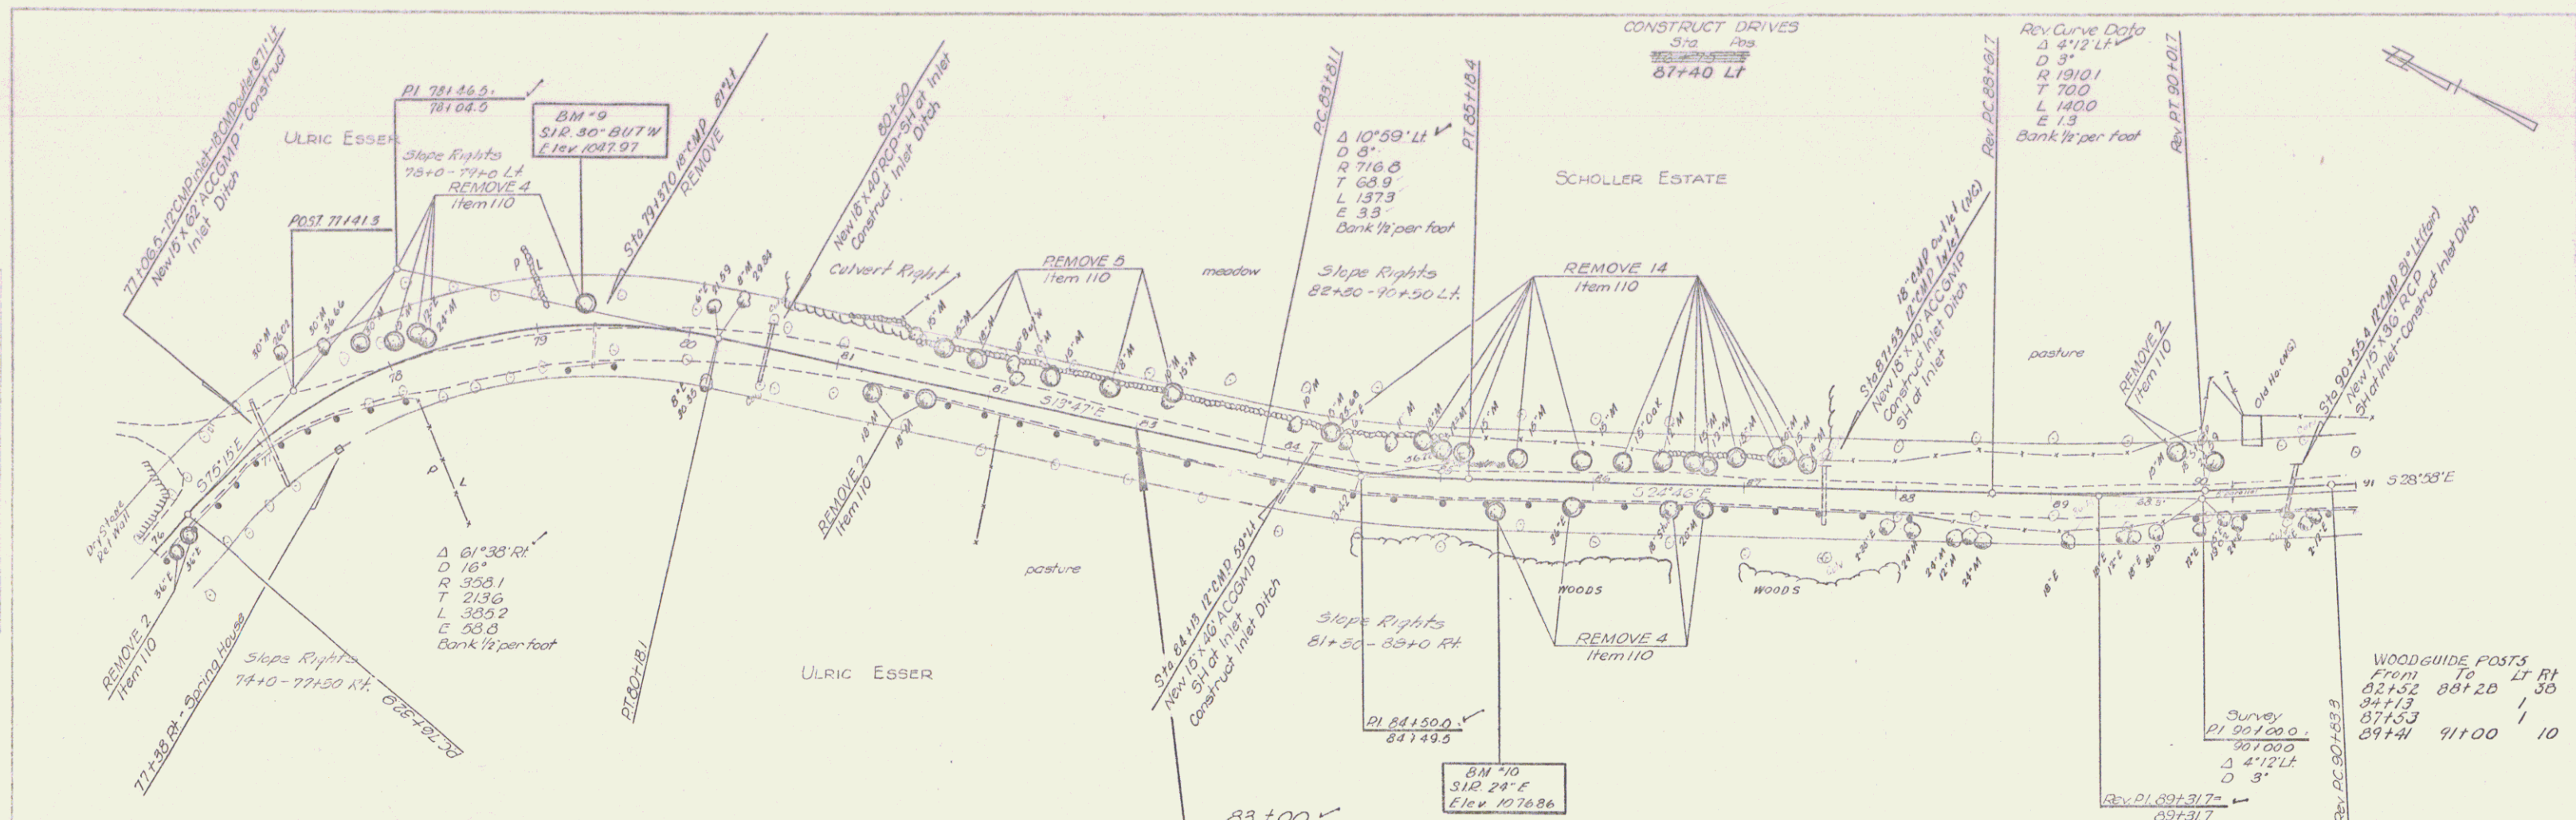

BM #9 - S1R 30' BUTW Elev. 1047.97  
 BM #10 - S1R 24' Elm 20' Rt Sta 85+34 - Elev. 1076.86

MIDDLETOWN SPRINGS  
 Series S NO. 211(3)  
 Sheet 10 of 23