

INDEX OF SHEETS

SHEET NO.	TITLE PAGE
1	TITLE PAGE
2	TYPICAL CROSS SECTION OF IMPROVEMENT
3	QUANTITY SHEET (ITEM & DRAINAGE)
4-5	EARTHWORK SHEETS
6-11	PLAN & PROFILE SHEETS
12	ROADWAY STANDARD SHEET
13	RS 66-1 (BANKING TABLES)
14	RS 66-31 (MARKERS)
15	RS 66-41 (DRAINAGE)
16	RS 66-6 (TURNOUTS)
17	RS 66-10 (TWO CABLE GUARD RAIL)
18	RS 66-12 (BARRICADES, SIGNS & LIGHTS)
19-37	CROSS SECTIONS

PROJECT NAME & NUMBER	TYPE	PAVEMENT AREA
MIDDLETOWN SPRINGS DS 0139(2)	DOUBLE TACK COAT OF BITUMINOUS MATERIAL WITH PEA STONE AND STONE GRITS SEAL, PRIME COAT OF REFINED TAR & DOUBLE SEAL COAT OF CUTBACK ASPHALT.	18,944 sq.

RECORD PLANS	
SUBBASE OF GRAVEL - HAYNES	PIT - MIDDLETOWN SPRINGS, VERMONT.
REINFORCED CONCRETE PIPE - VERMONT CONCRETE CO.	WINDSOR, VERMONT.
CUTBACK ASPHALT - SOCONY	E. PROVIDENCE, RHODE ISLAND.
REFINED TAR - KOPPERT PRODUCTS CO.	EVERETT, MASS.
ACCC. METAL PIPE - NEW ENGLAND METAL PIPE CO.	WHITE R. JCT., VERMONT.
STANDARD STEEL BEAM & TWO CABLE GUARD RAIL - S.T. GRISWOLD CO.	ESSEX JUNCTION, VERMONT.
CONTRACTOR - L.C. ROGERS	CONTRACT DATED JULY 21, 1958.
RES. ENGINEER - ROBERT M. ARONSON	CONTRACT STARTED JULY 23, 1958.
RECORD PLANS - A.G. SPIDLE	CONTRACT COMPLETED AUGUST 6, 1959.
	CONTRACT ACCEPTED AUGUST 5, 1959.

STATE OF VERMONT  
DEPARTMENT OF HIGHWAYS

PROPOSED IMPROVEMENT


TOWN OF MIDDLETOWN SPRINGS

COUNTY OF RUTLAND  
VERMONT ROUTE #3

MIDDLETOWN SPRINGS - PAWLET ROAD

BEGINNING AT A POINT APPROXIMATELY 2.082 MILES SOUTHERLY FROM THE INTERSECTION OF VT. ROUTE 140 & VT. ROUTE 3 AND EXTENDING NORTHERLY 1.622 MILES

LENGTH OF PROJECT 8,564.3 FT. = 1.622 MILES

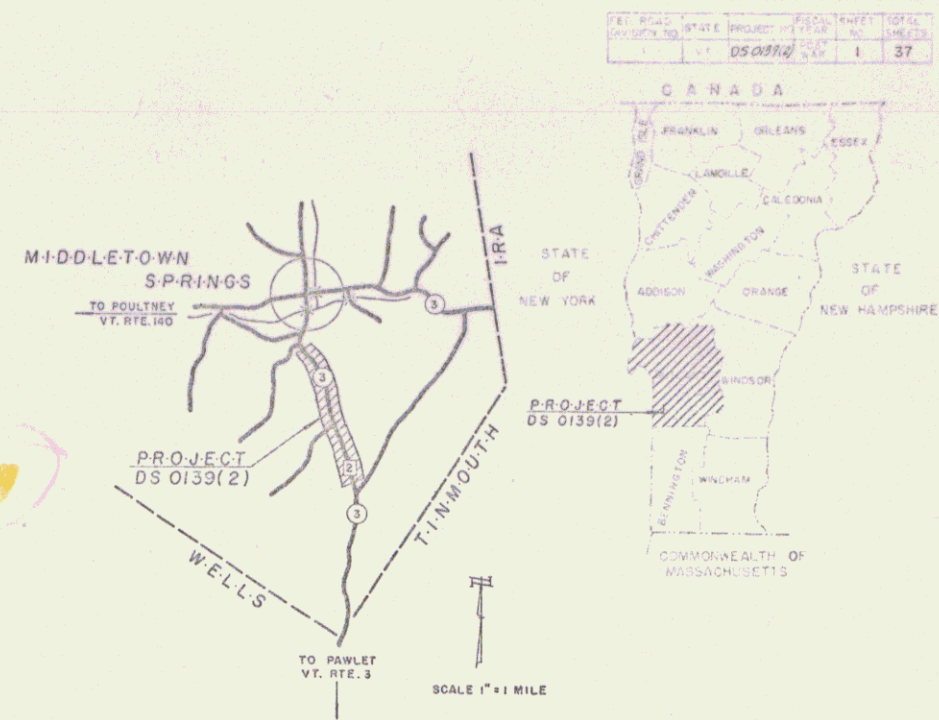


RIGHT-OF-WAY DIVISION  
TOWN FILE

PERPETUAL

Pin# 99R661  
Town of VT#3

(To Be Returned To R.O.W. Division)

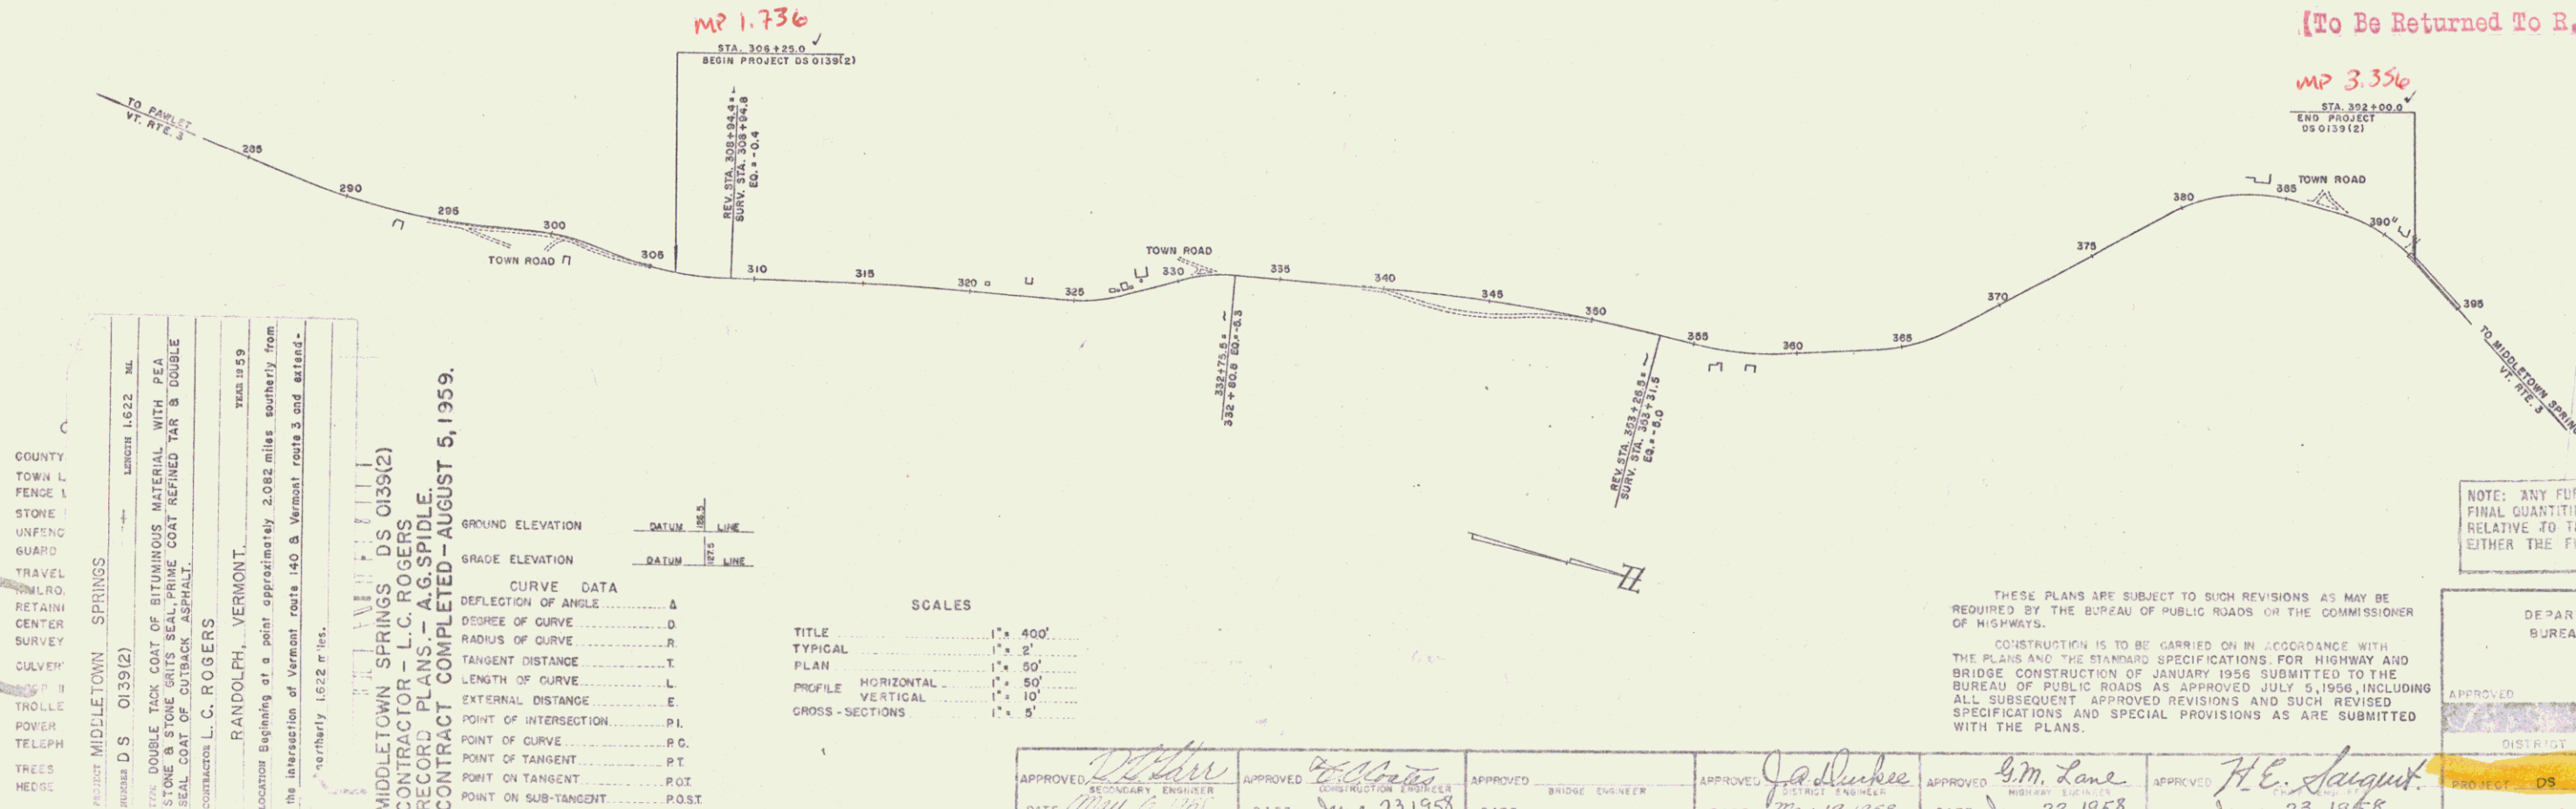

NOTE: ANY FURTHER INFORMATION CONCERNING FINAL QUANTITIES, AMOUNTS OR OTHER DETAILS RELATIVE TO THIS PROJECT MAY BE FOUND IN EITHER THE FIELD BOOKS OR THE ESTIMATE FILE.

THESE PLANS ARE SUBJECT TO SUCH REVISIONS AS MAY BE REQUIRED BY THE BUREAU OF PUBLIC ROADS OR THE COMMISSIONER OF HIGHWAYS.

CONSTRUCTION IS TO BE CARRIED ON IN ACCORDANCE WITH THE PLANS AND THE STANDARD SPECIFICATIONS FOR HIGHWAY AND BRIDGE CONSTRUCTION OF JANUARY 1956 SUBMITTED TO THE BUREAU OF PUBLIC ROADS AS APPROVED JULY 5, 1956, INCLUDING ALL SUBSEQUENT APPROVED REVISIONS AND SUCH REVISED SPECIFICATIONS AND SPECIAL PROVISIONS AS ARE SUBMITTED WITH THE PLANS.

DEPARTMENT OF COMMERCE  
BUREAU OF PUBLIC ROADS

APPROVED: [Signature] DATE: May 6, 1959  
 APPROVED: [Signature] DATE: June 23, 1958  
 APPROVED: [Signature] DATE: May 19, 1958  
 APPROVED: [Signature] DATE: June 23, 1958  
 APPROVED: [Signature] DATE: June 23, 1958

PROJECT DS 0139(2)  
SHEET 1 OF 37 SHEETS