
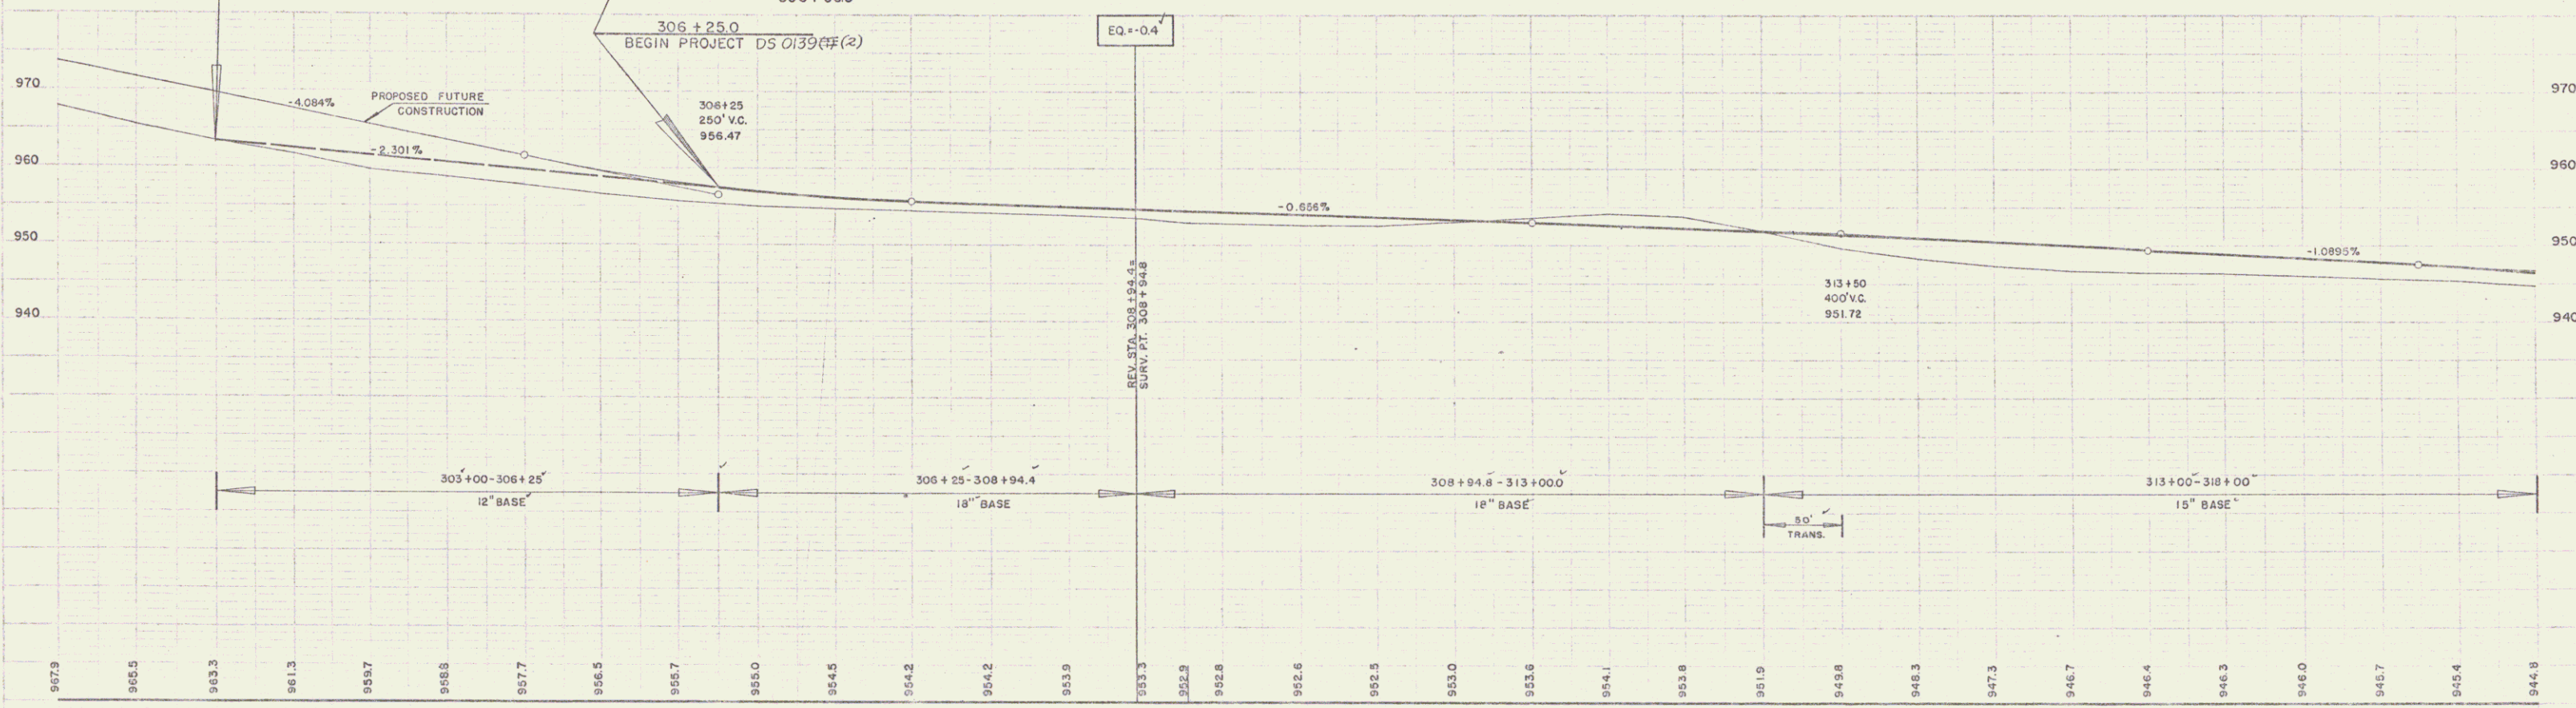


CONSTRUCT DATES
 LT RT
 307+40 310+80

WOOD GUIDE POSTS AT 16' %
 LT RT
 305+99-306+53
 308+90-310+50

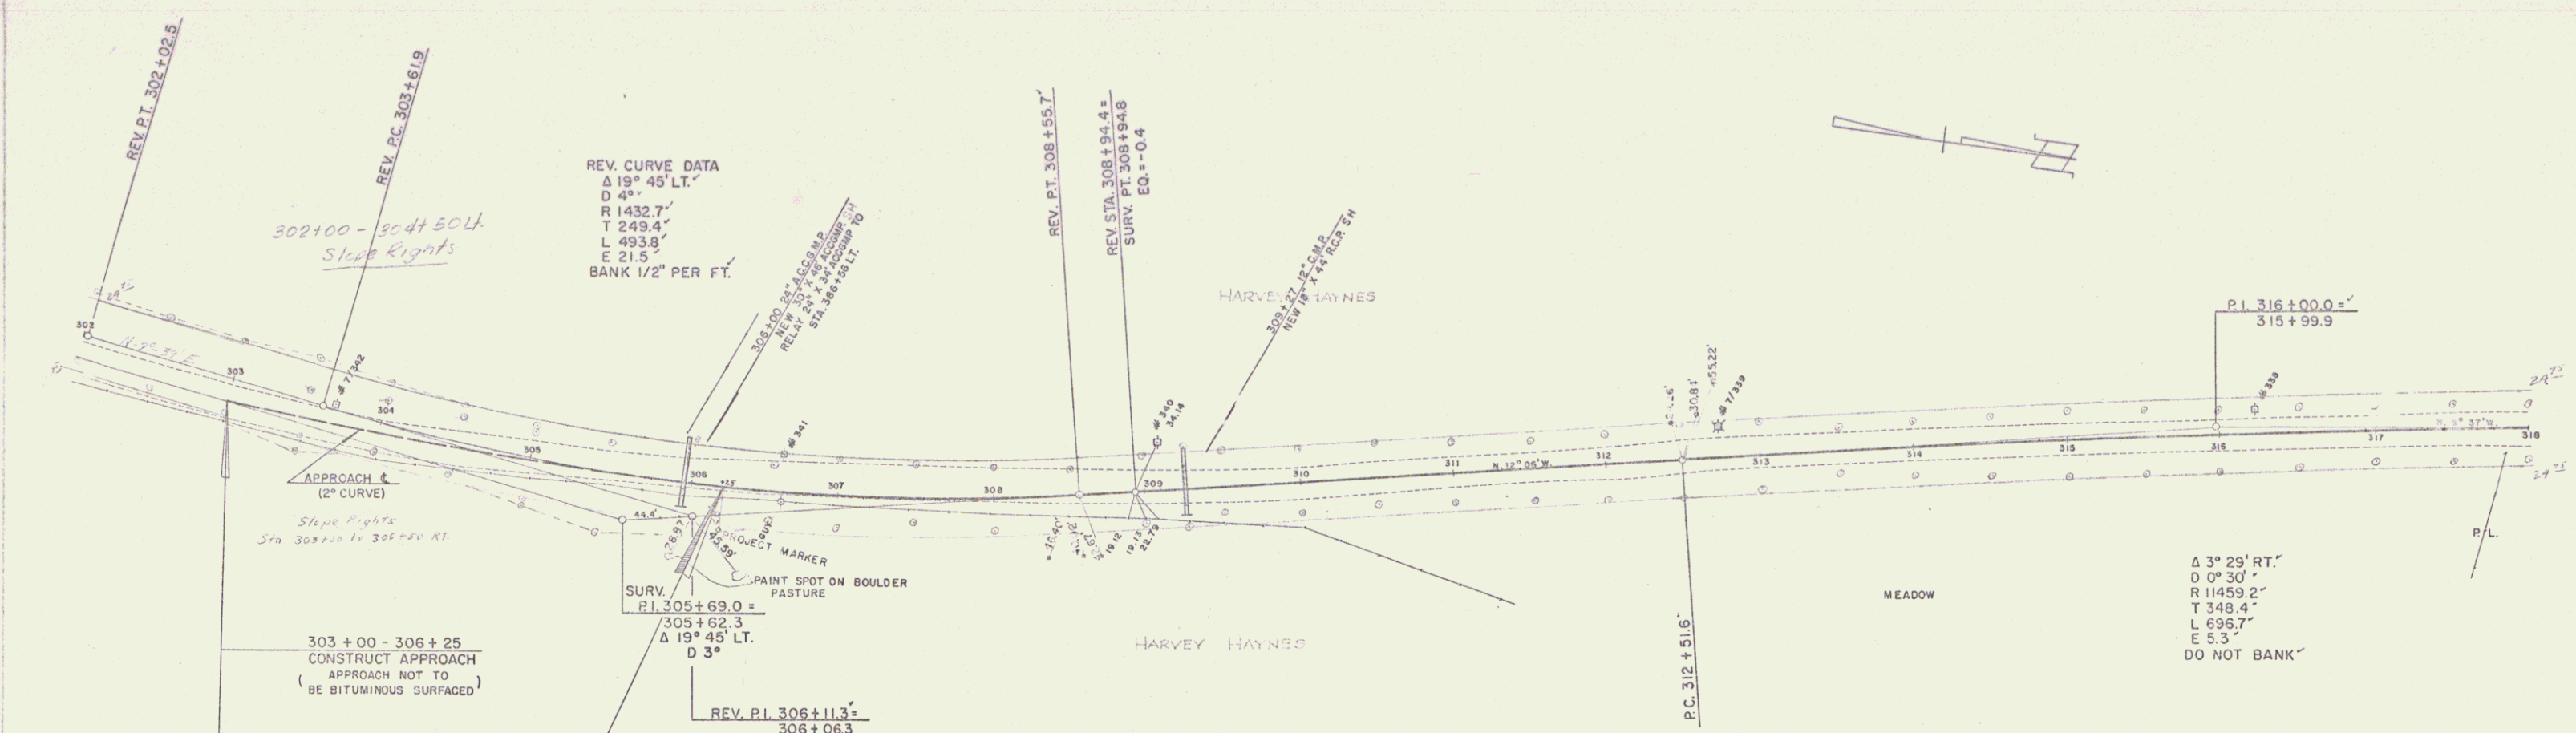

302 +50 303 +50 304 +50 305 +50 306 +50 307 +50 308 +50 309 +27 +50 310 +50 311 +50 312 +50 313 +50 314 +50 315 +50 316 +50 317 +50 318

303+00-306+25
12" BASE

306+25-308+94.4
18" BASE

308+94.8-313+00.0
18" BASE

313+00-318+00
15" BASE

MIDDLETOWN SPRINGS
 PROJECT DS NO. 0139(2)
 SHEET 5 OF 37