
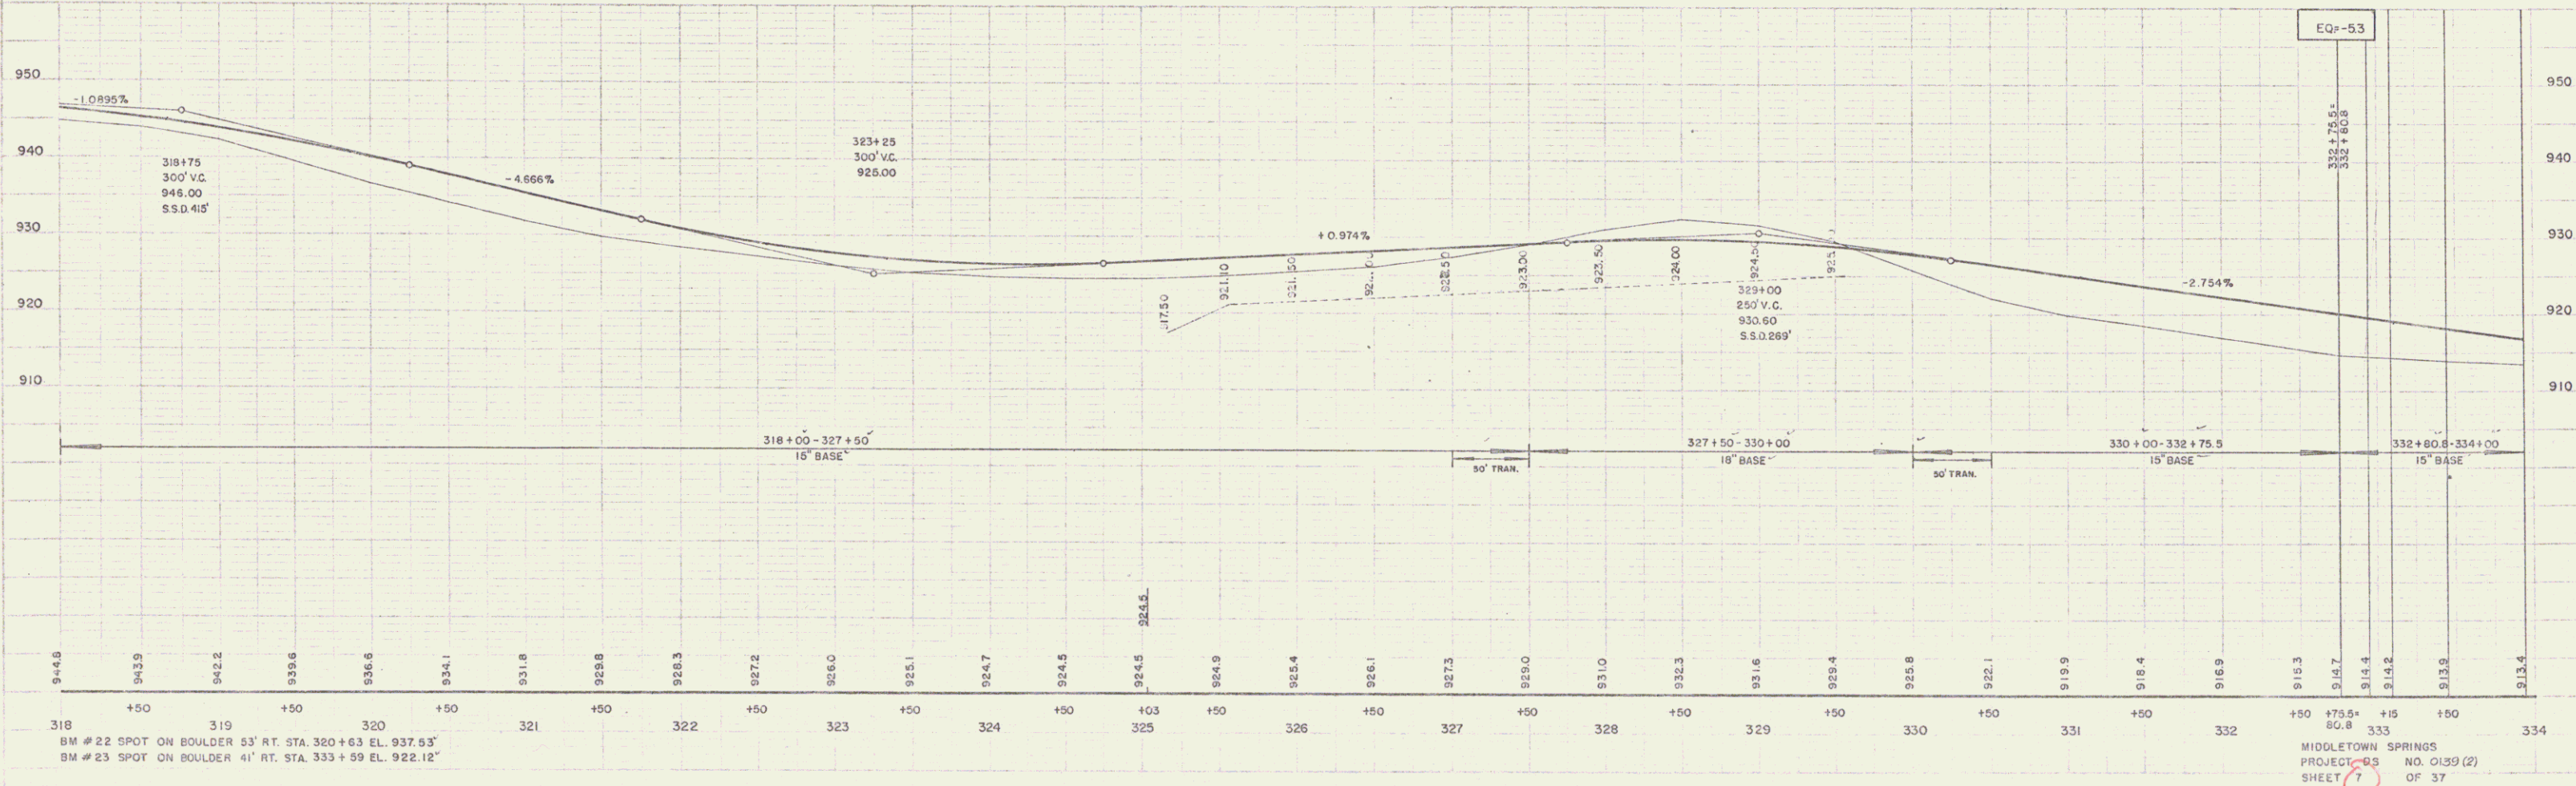


REMOVAL & DISPOSAL OF PRESENT GUARD RAIL		CONSTRUCT DRIVES		CONSTRUCT APPROACH		TWO CABLE GUARD RAIL		WOOD GUIDE POSTS AT 16' %	
LT.	RT.	LT.	RT.	LT.	RT.	LT.	RT.	LT.	RT.
324+64	326+12	323+00	330+50	330+00	331+00	330+00	334+00	324+92	325+05
324+64	326+12	323+00	326+75	331+00		331+00	334+00	324+92	325+05
		331+00	322+75			331+00	334+00	324+92	325+05
		330+25						325+05	325+08

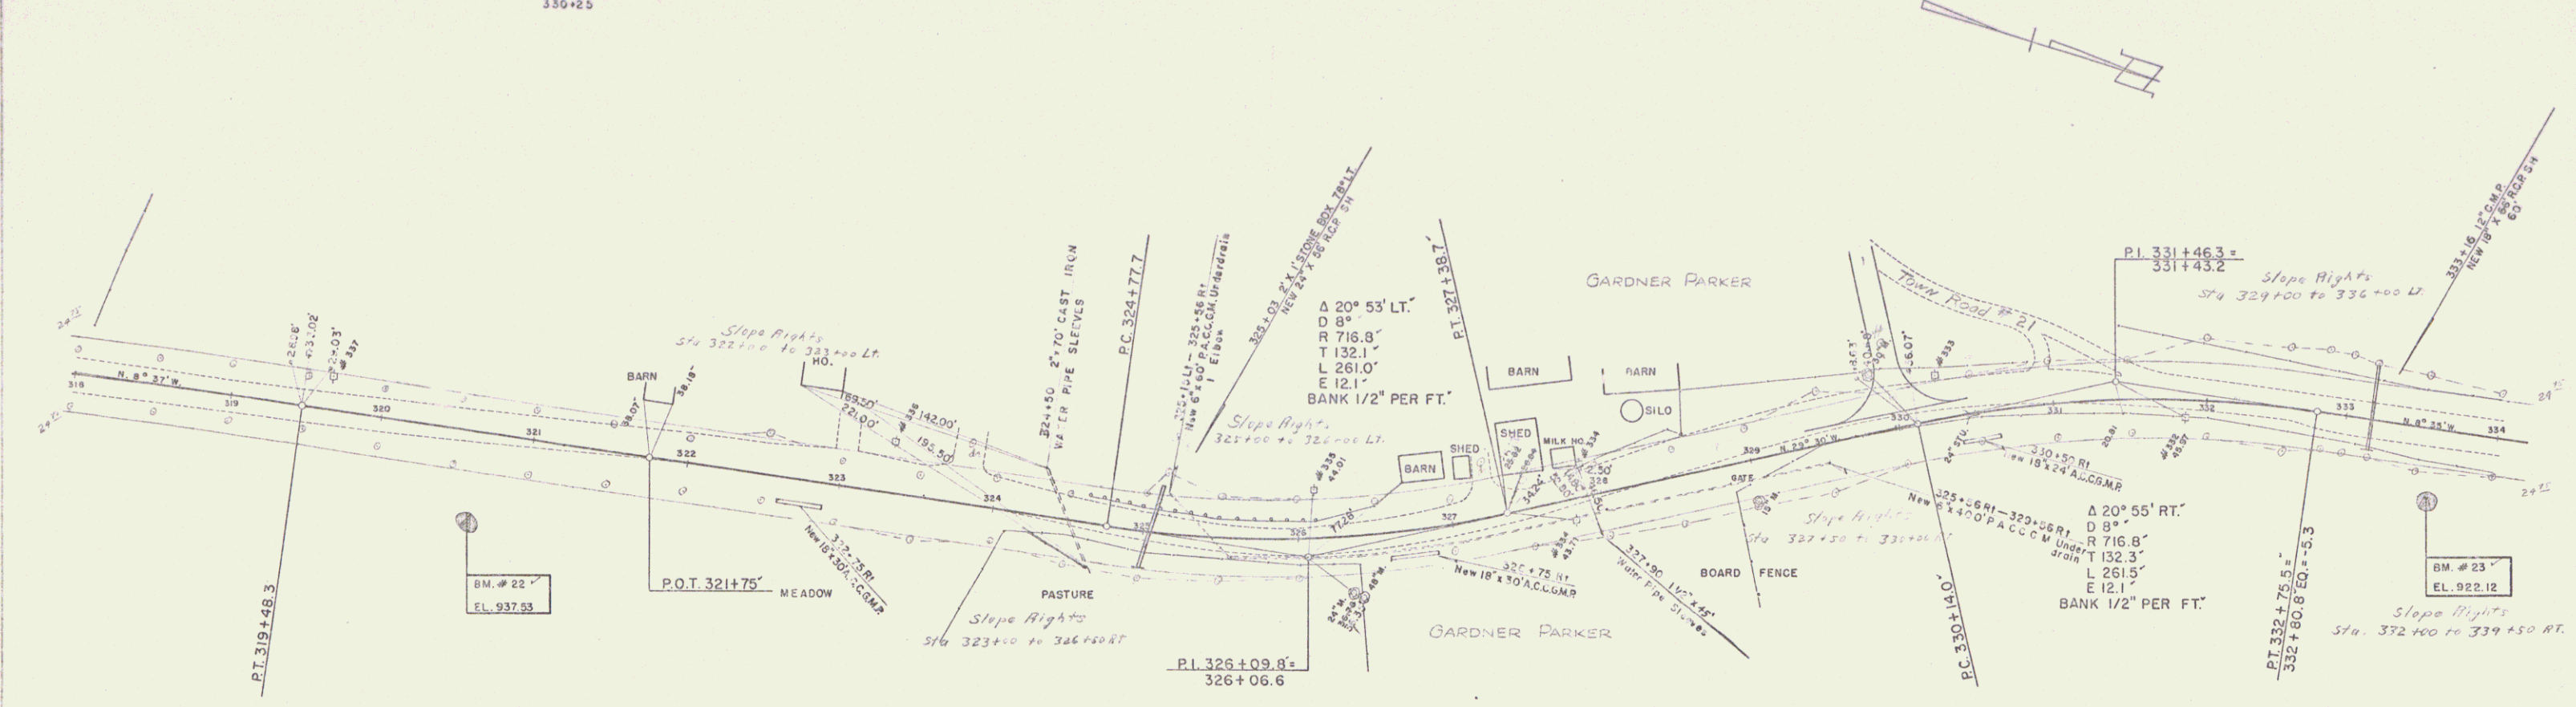

318 BM # 22 SPOT ON BOULDER 53' RT. STA. 360+63 EL. 937.53'
 318 BM # 23 SPOT ON BOULDER 41' RT. STA. 333+59 EL. 922.12'
 MIDDLETOWN SPRINGS
 PROJECT NO. 0139 (2)
 SHEET 7 OF 37

4