
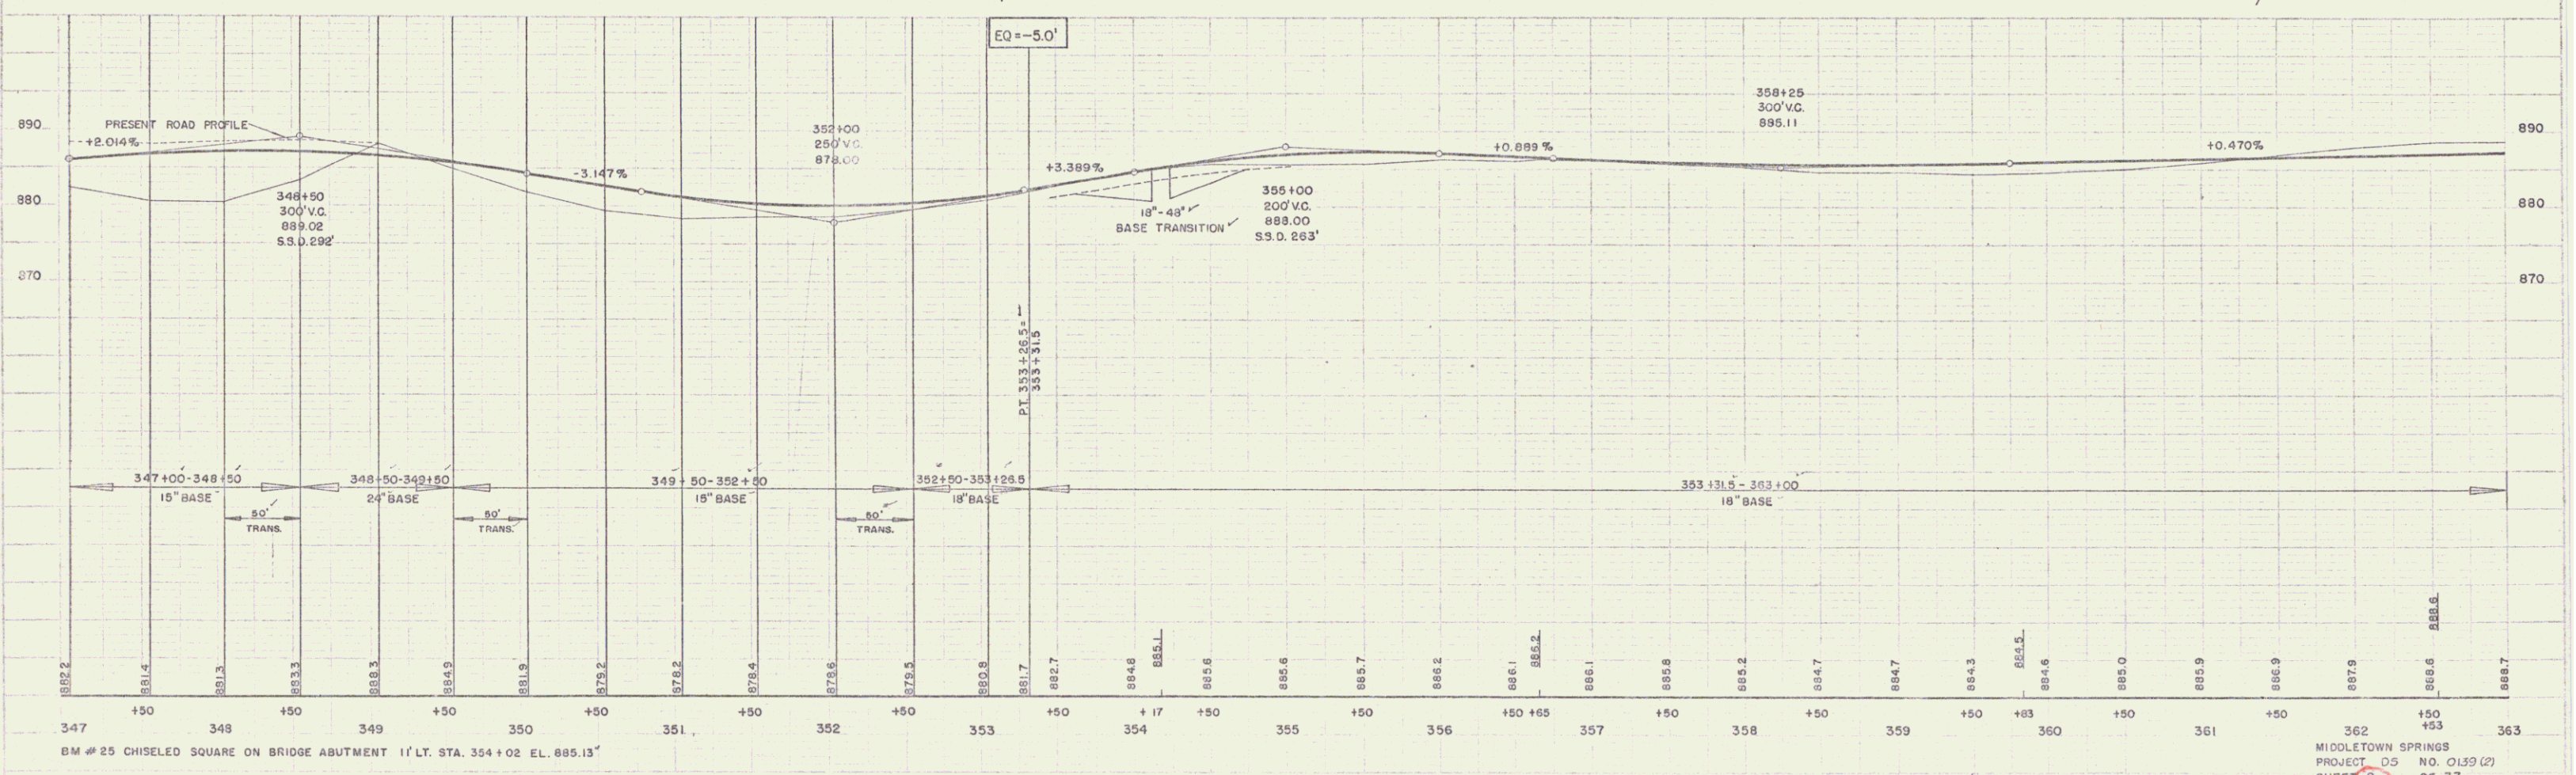


WOOD GUIDE POSTS  
 LT RT  
 347+00-350+52

CONSTRUCT DRIVES  
 LT RT  
 355+00 356+59.99  
 354+00 347+75

TWO CABLE GUARD RAIL  
 LT RT  
 347+00-351+06 353+48-354+50  
 353+06-354+50 354+06-354+33  
 354+00-354+26

REMOVAL & DISPOSAL OF  
 PRESENT GUARD RAIL  
 LT RT  
 353+89-354+04 354+00-354+16  
 354+17-354+53 354+29-354+53

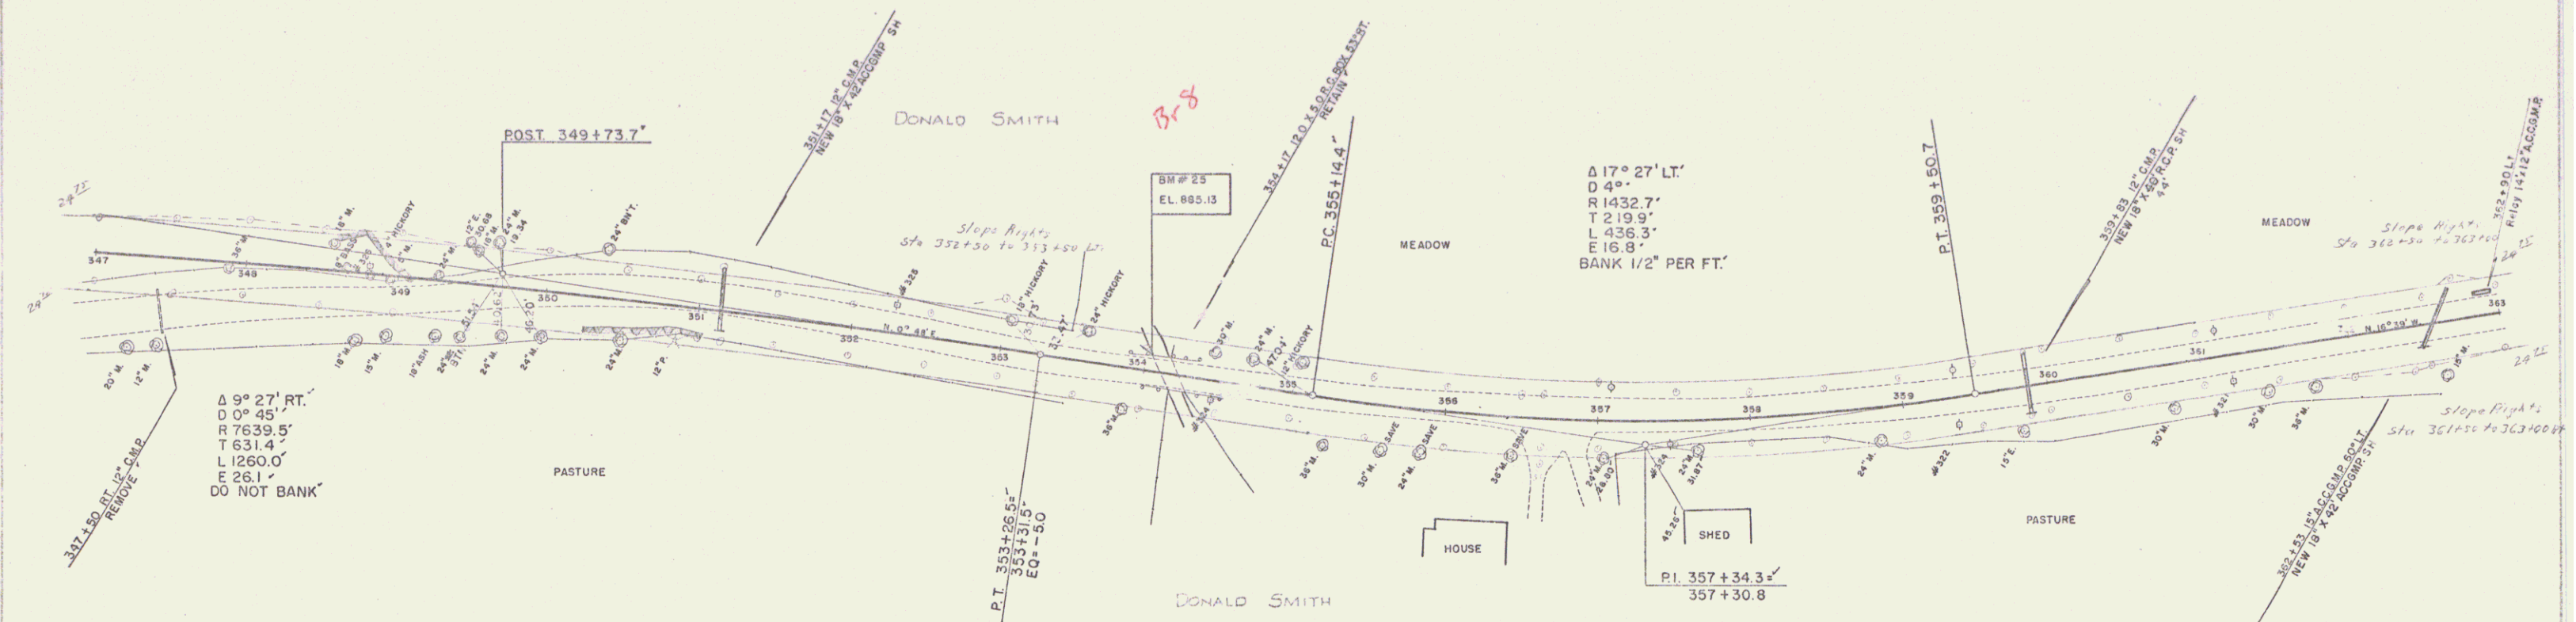

BM # 25 CHISELED SQUARE ON BRIDGE ABUTMENT 1' LT. STA. 354+02 EL. 885.13  
 MIDDLETOWN SPRINGS PROJECT D5 NO. 0139 (2) SHEET 6 OF 37