
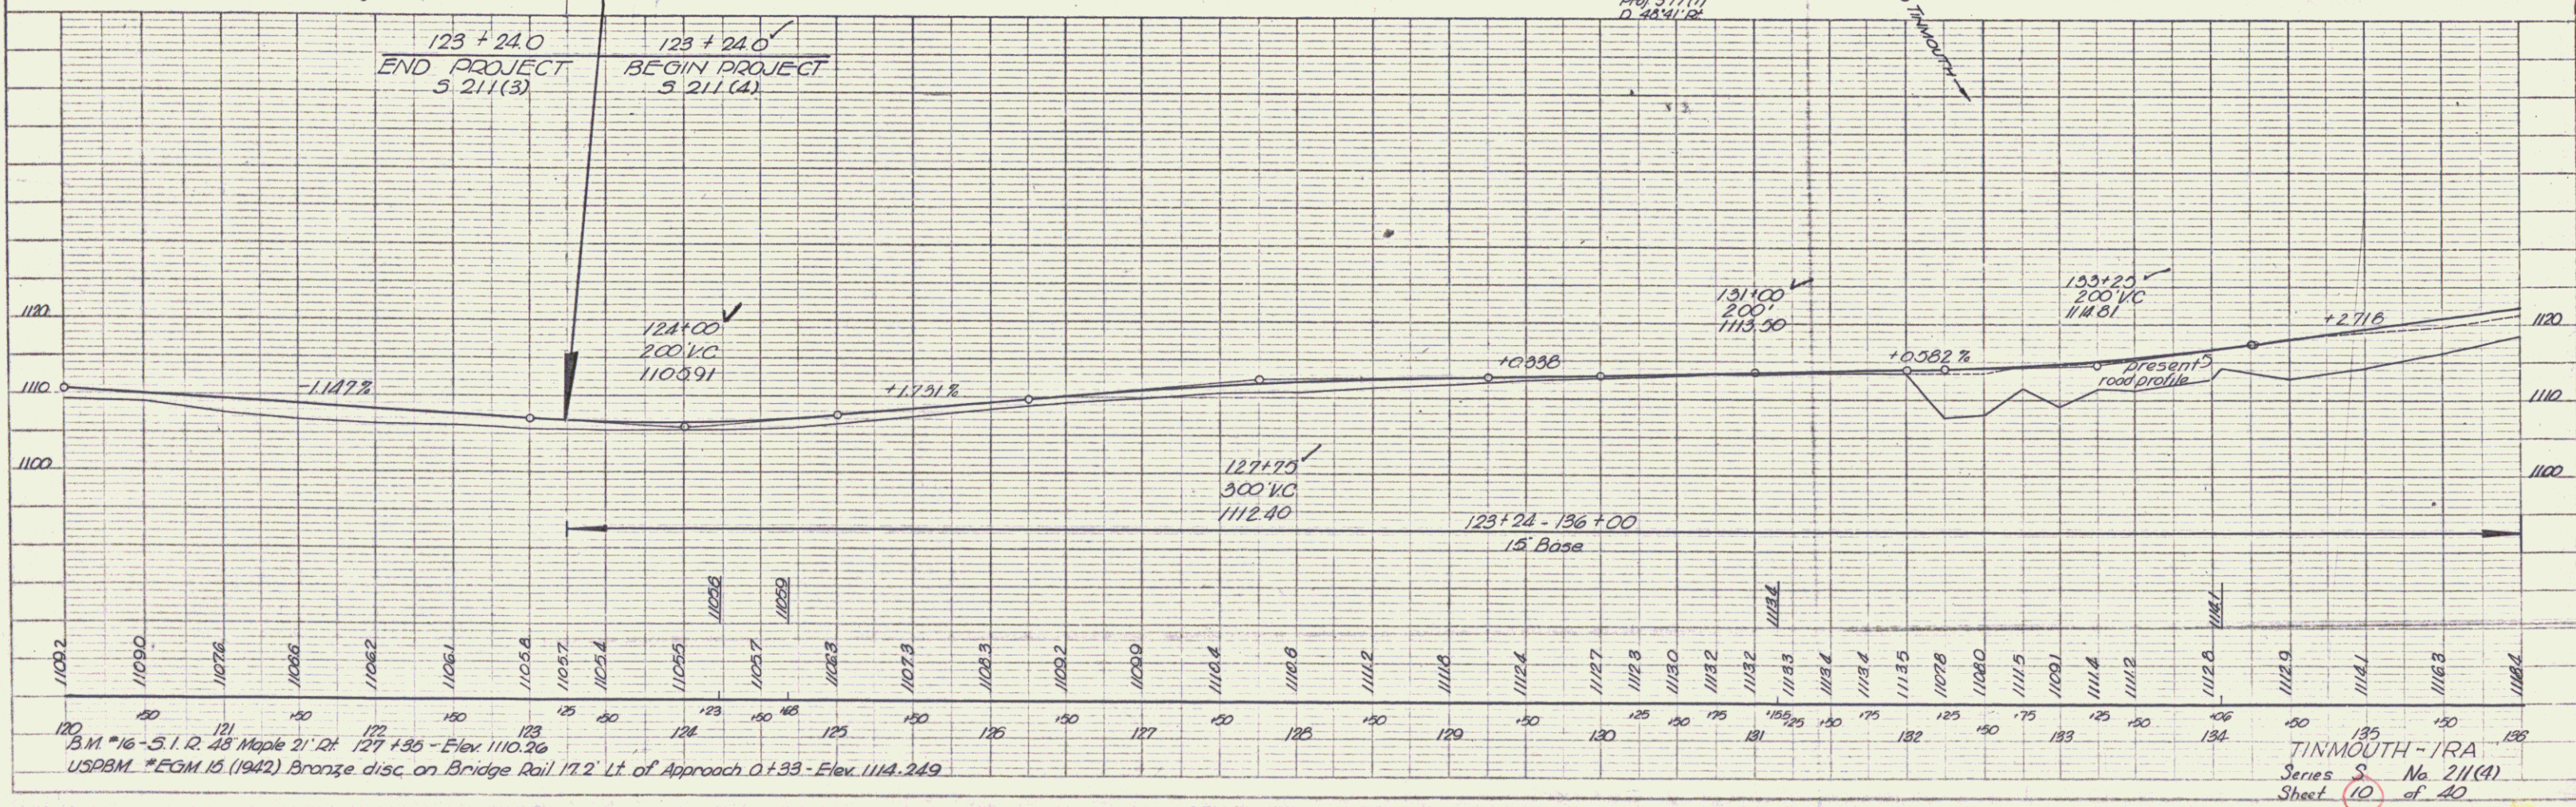


PLAN	DATE	BY	CHK	SCALE
12/15/42	12/15/42	W.C.C.	W.C.C.	1" = 40'
REVISIONS	DATE	BY	CHK	REASON

PROFILE	DATE	BY	CHK	SCALE
12/15/42	12/15/42	W.C.C.	W.C.C.	1" = 40'
REVISIONS	DATE	BY	CHK	REASON

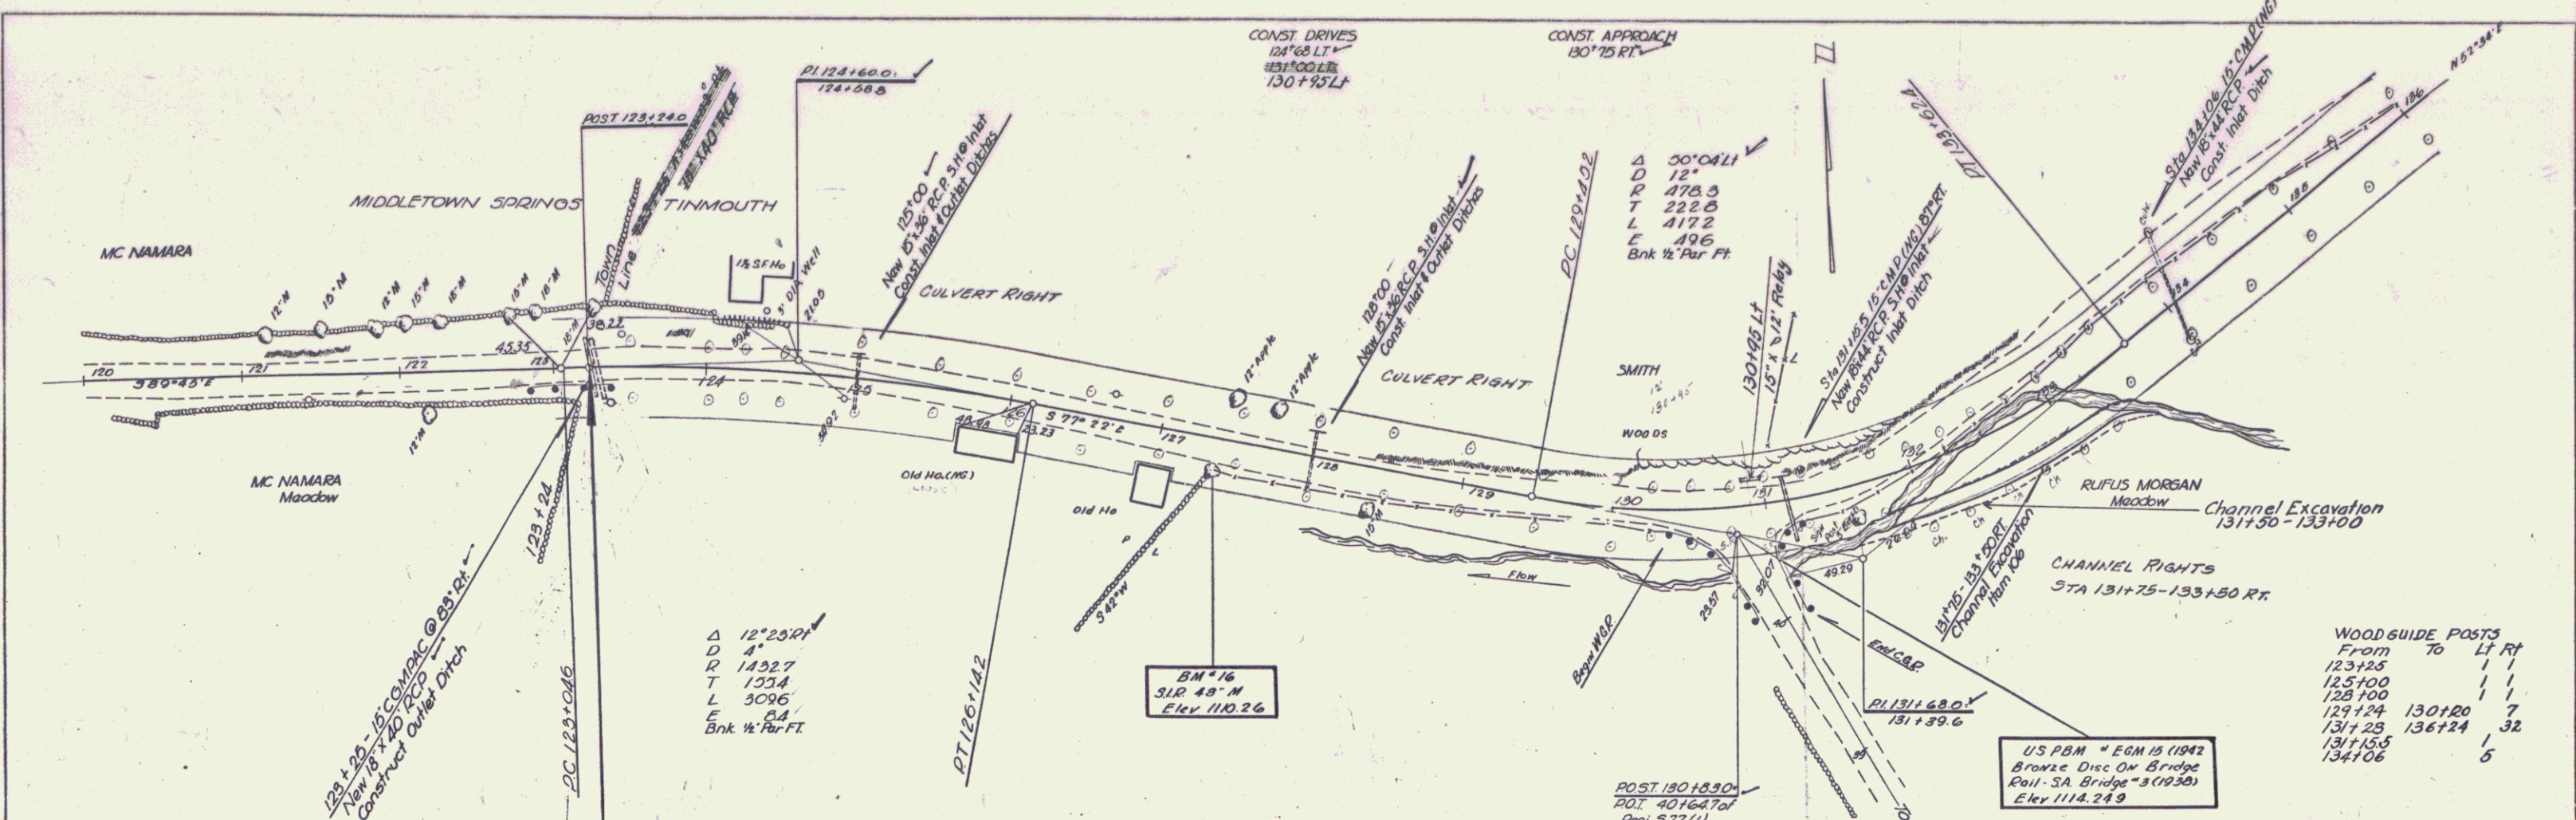

B.M. #16 - S. 1. R. 43 Maple 21' Rt. 127+35 - Elev 1110.26  
 U.S.P.B.M. #EGM 15 (1942) Bronze disc on Bridge Rail 17.2' Lt. of Approach 0+33 - Elev 1114.249

PLATE 1 - PLAN - PROFILE  
 KELLY & SPYER CO., NEW YORK  
 MADE IN U.S.A.

TINMOUTH - I.R.A.  
 Series S No. 211(A)  
 Sheet 10 of 40