


DATE	BY	REVISION
7-2-58	W. J.
7-2-58
7-2-58

NO.	DATE	BY	REVISION
1	7-2-58	W. J.
2
3

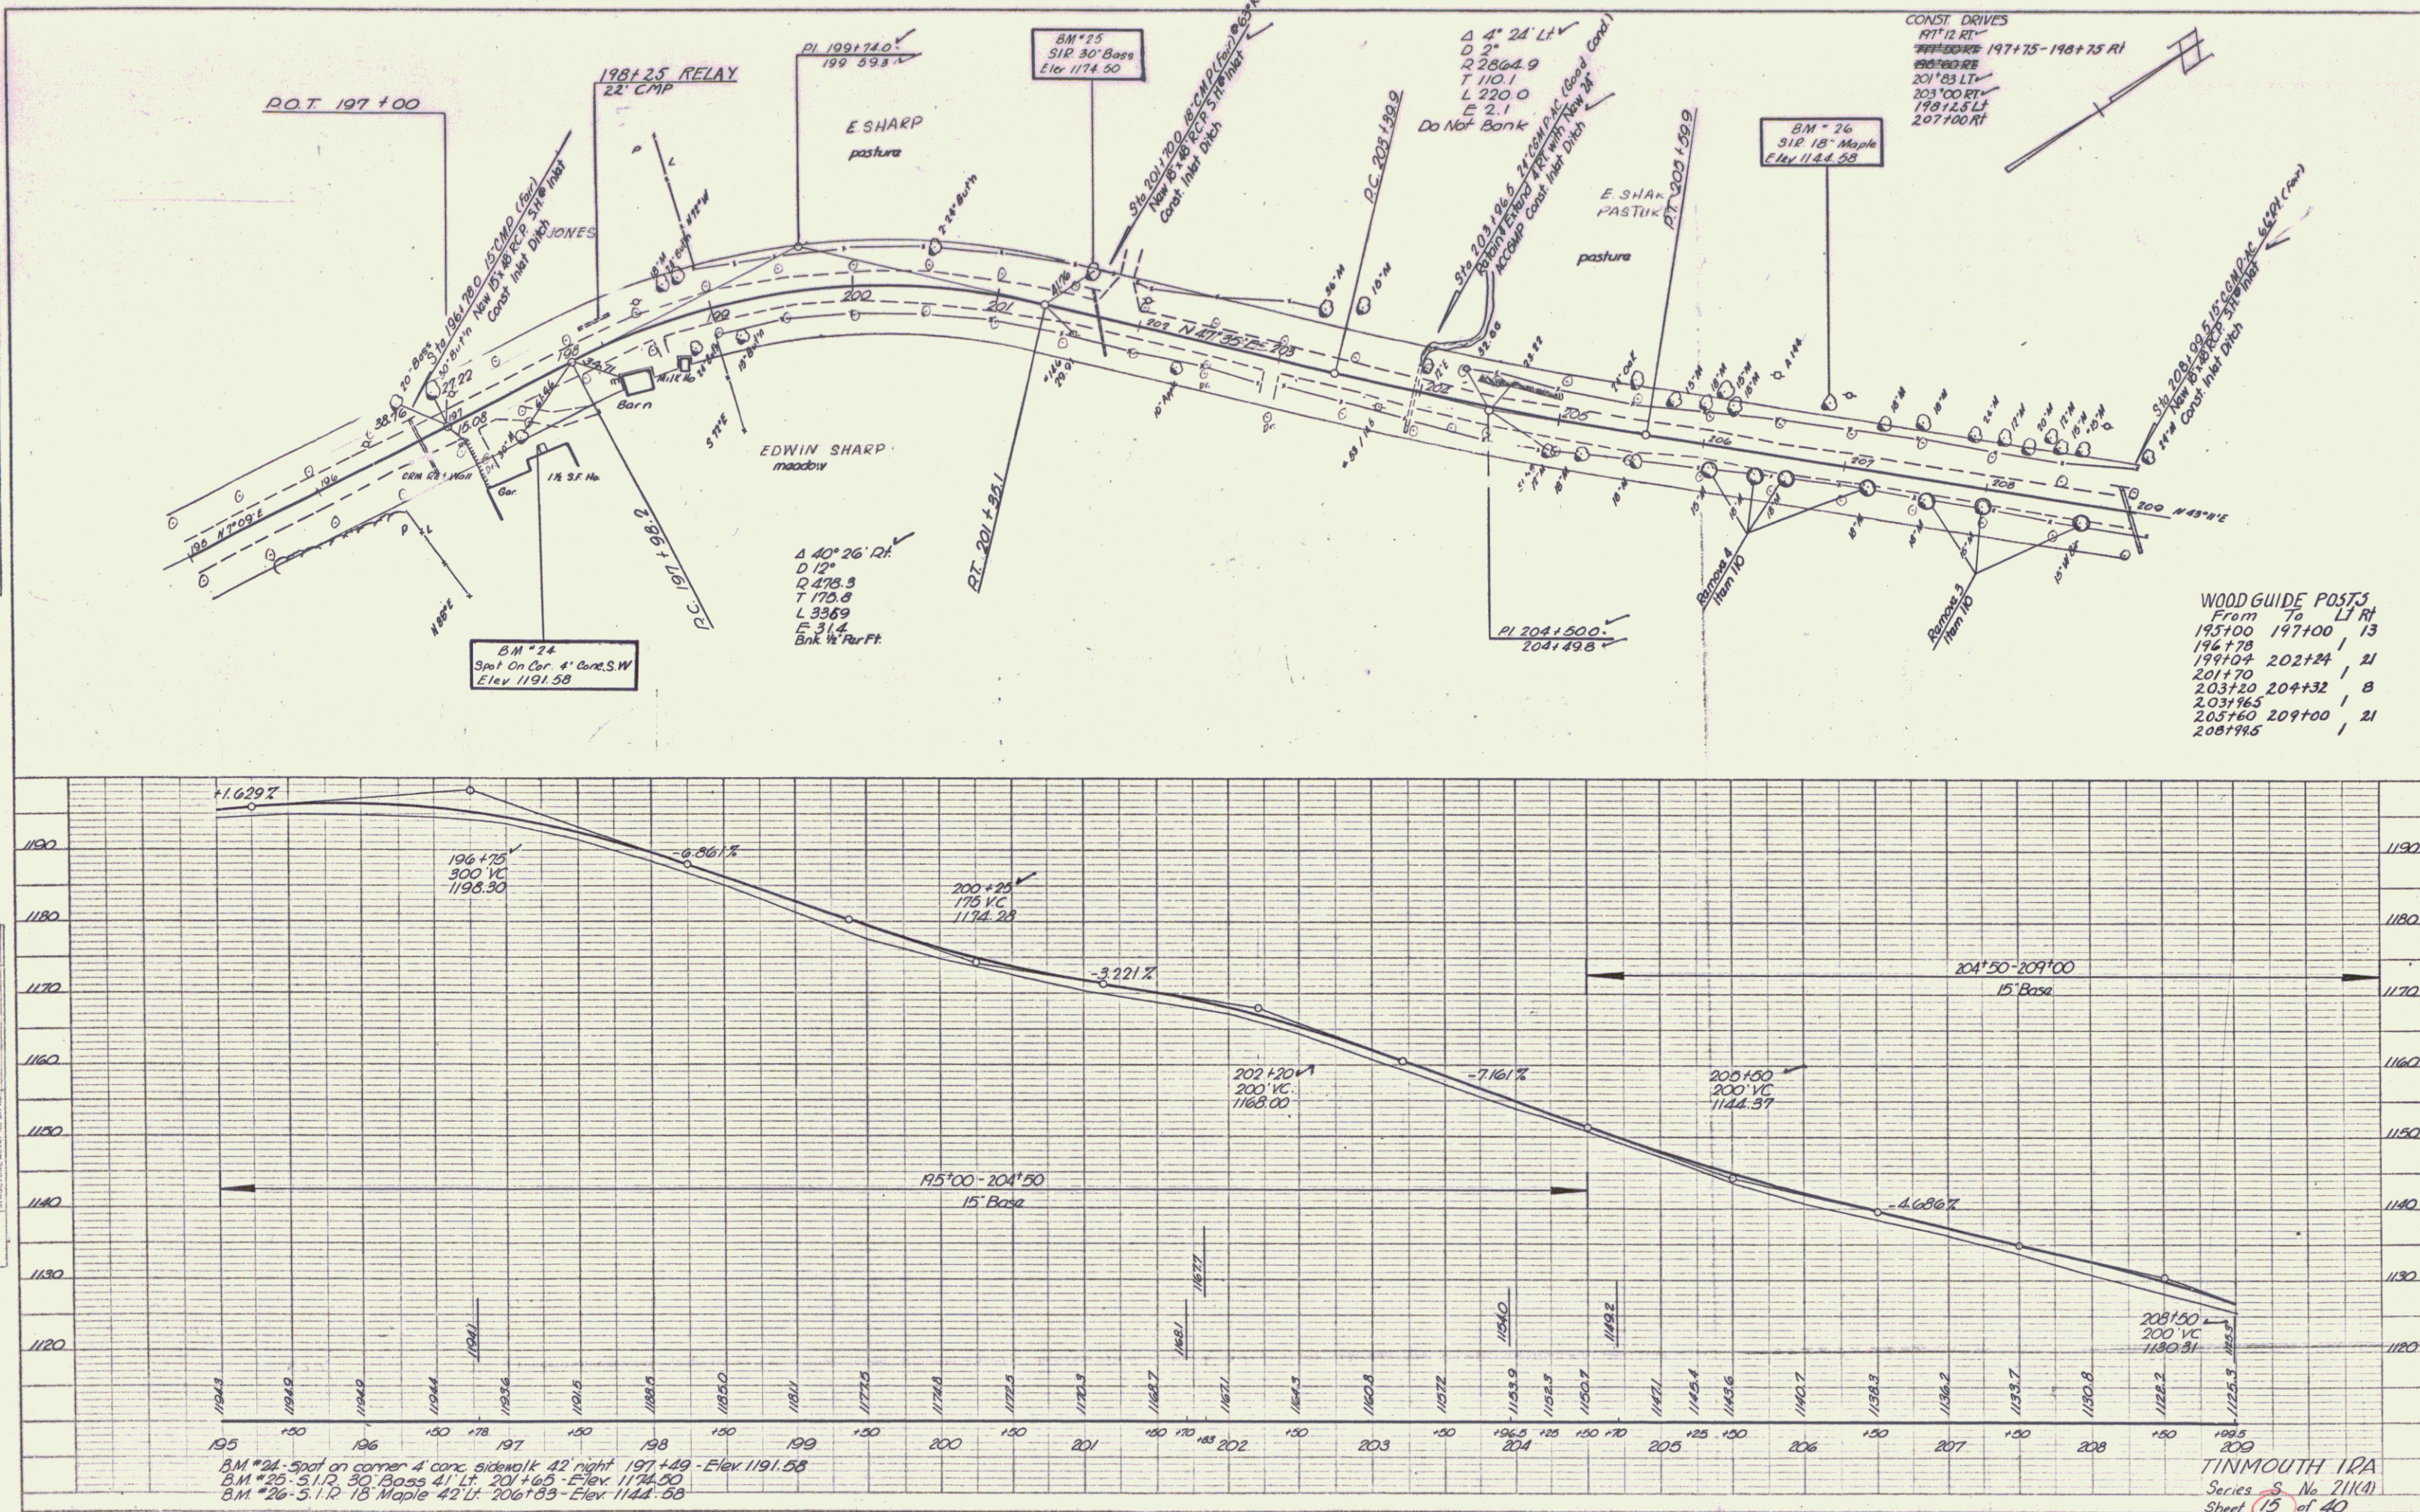

B.M. #24 - Spot on corner 4 conc sidewalk 42' right 197+49 - Elev 1191.58
 B.M. #25 - S. 1/2, 30' Base 41' Lt. 201+65 - Elev 1174.50
 B.M. #26 - S. 1/2, 18' Maple 42' Lt. 206+89 - Elev 1144.58

PLATE 1 - PLAN PROFILE
 TOWN OF ...
 MADE BY ...

TOWN OF ...
 Series S No. 211(A)
 Sheet 19 of 40