

WOOD GUIDE POSTS

STA	LT	RT
249+15	5	13
249+70	1	27
252+05	1	1
258+12	1	1
261+32	1	1
262+22	1	1
264+64	1	2


TWO CASTLE GUARD RAIL

STA	LT	RT	ANCH.
252+46	344	2	

CONSTRUCT DRIVES

LT	RT
252+60	254+65
254+30	259+50
256+67	
250+50	
251+50	
258+25	
259+80	

DATE: 6/23
 DRAWN BY: R. L. HARR
 CHECKED BY: J. L. HARR
 PROJECT: 7/18
 SHEET: 7/18

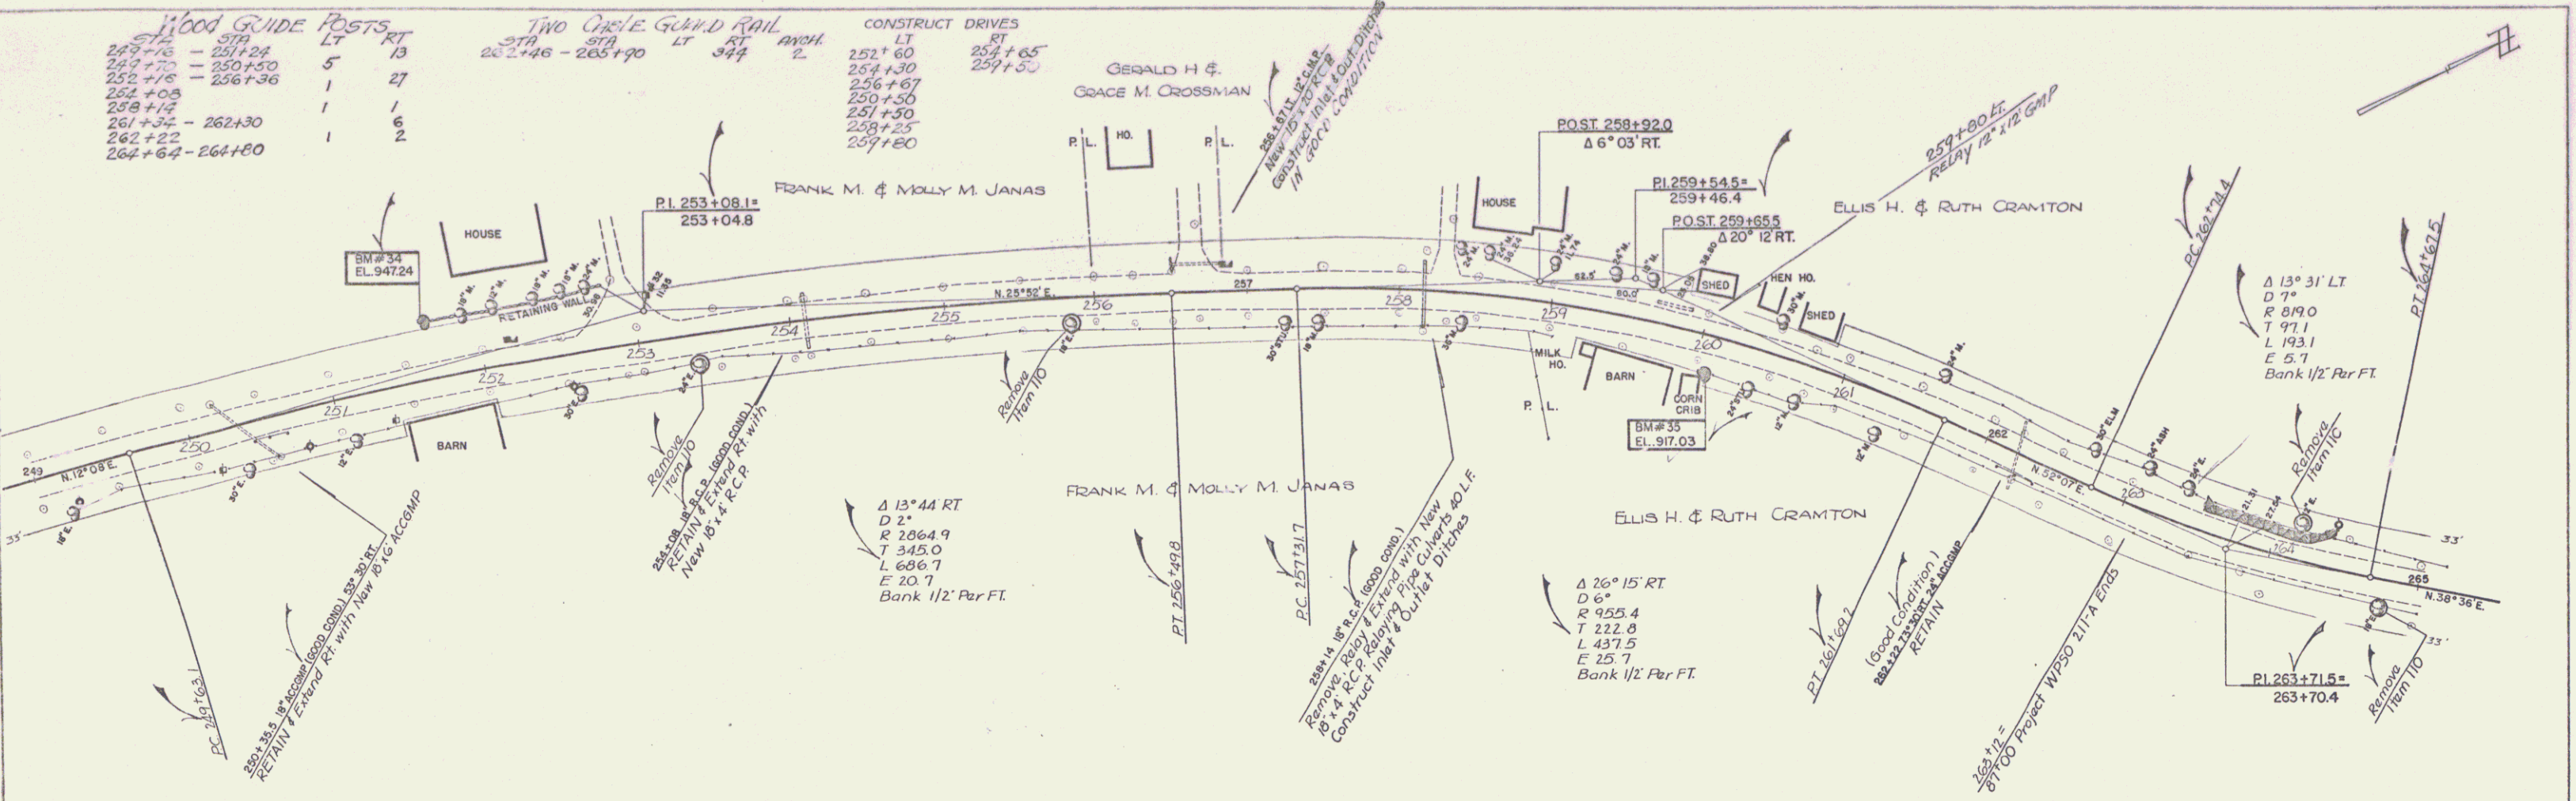

DATE: 7/18
 DRAWN BY: R. L. HARR
 CHECKED BY: J. L. HARR
 PROJECT: 7/18
 SHEET: 7/18

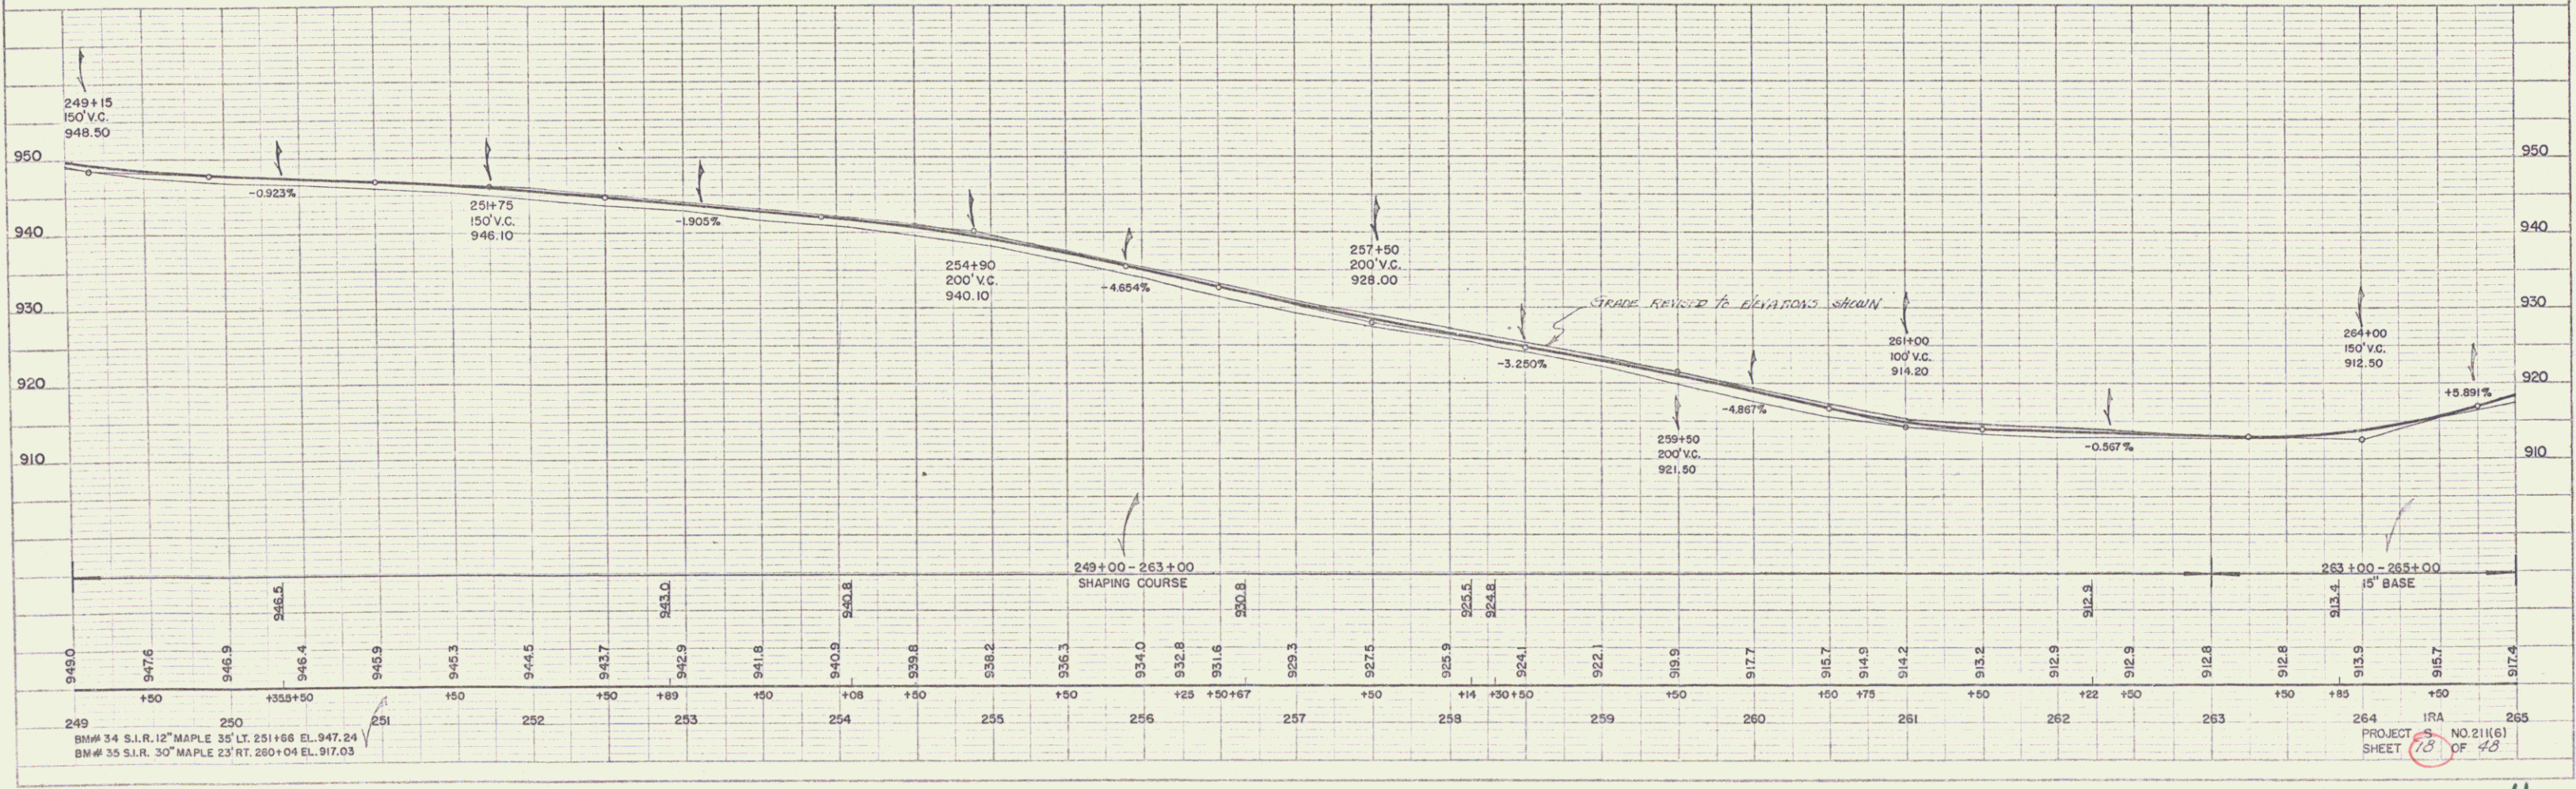


PLATE 1 - PLAN & PROFILE
 NEW YORK STATE DEPARTMENT OF TRANSPORTATION
 DIVISION OF HIGHWAYS
 ALBANY, N. Y.

PROJECT NO. 21(16)
 SHEET 7 OF 40