
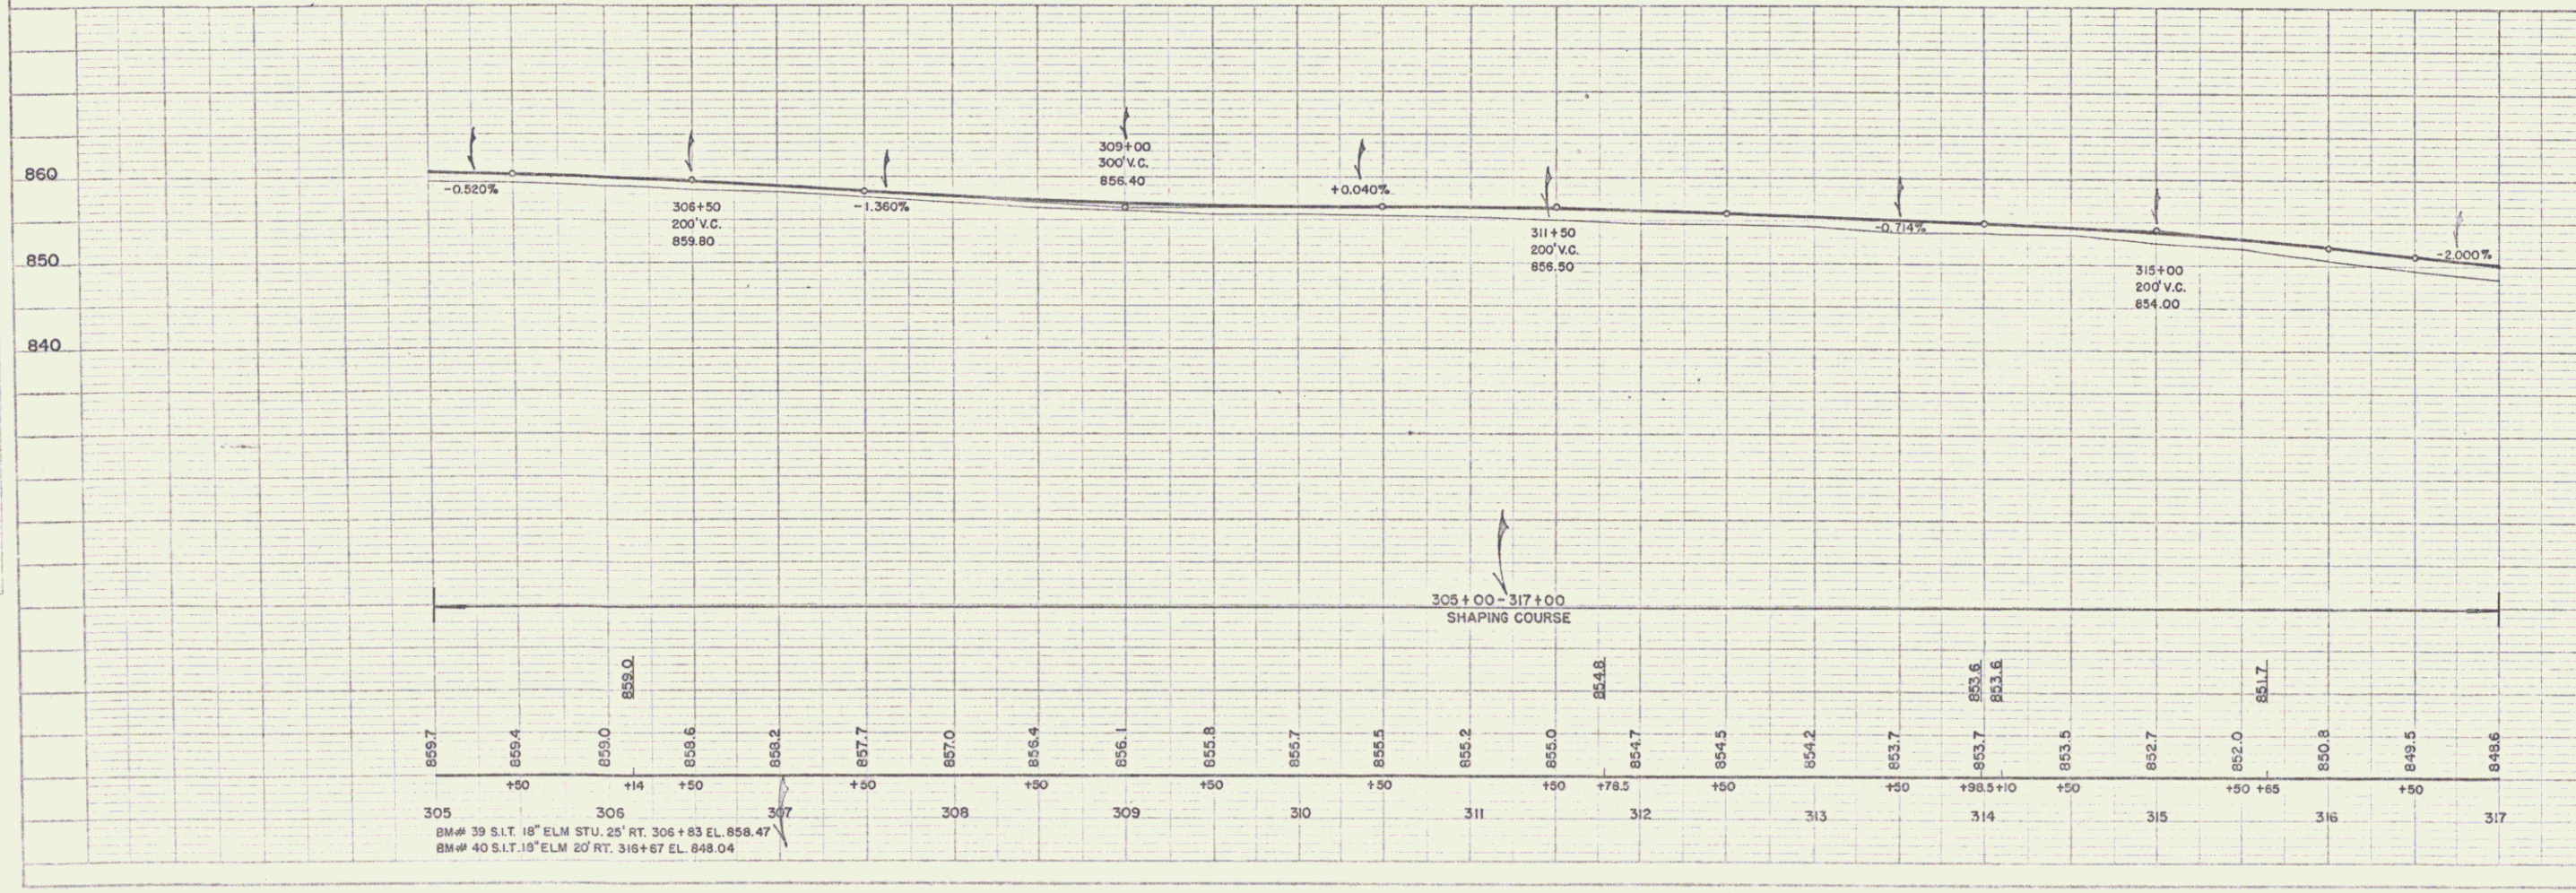


PLAN
 DRAWN BY: S. M. MARR
 DATE: 6/53
 CHECKED BY: J. R. MARR
 DATE: 6/53

PROFILE
 DRAWN BY: S. M. MARR
 DATE: 7/53
 CHECKED BY: J. R. MARR
 DATE: 7/53

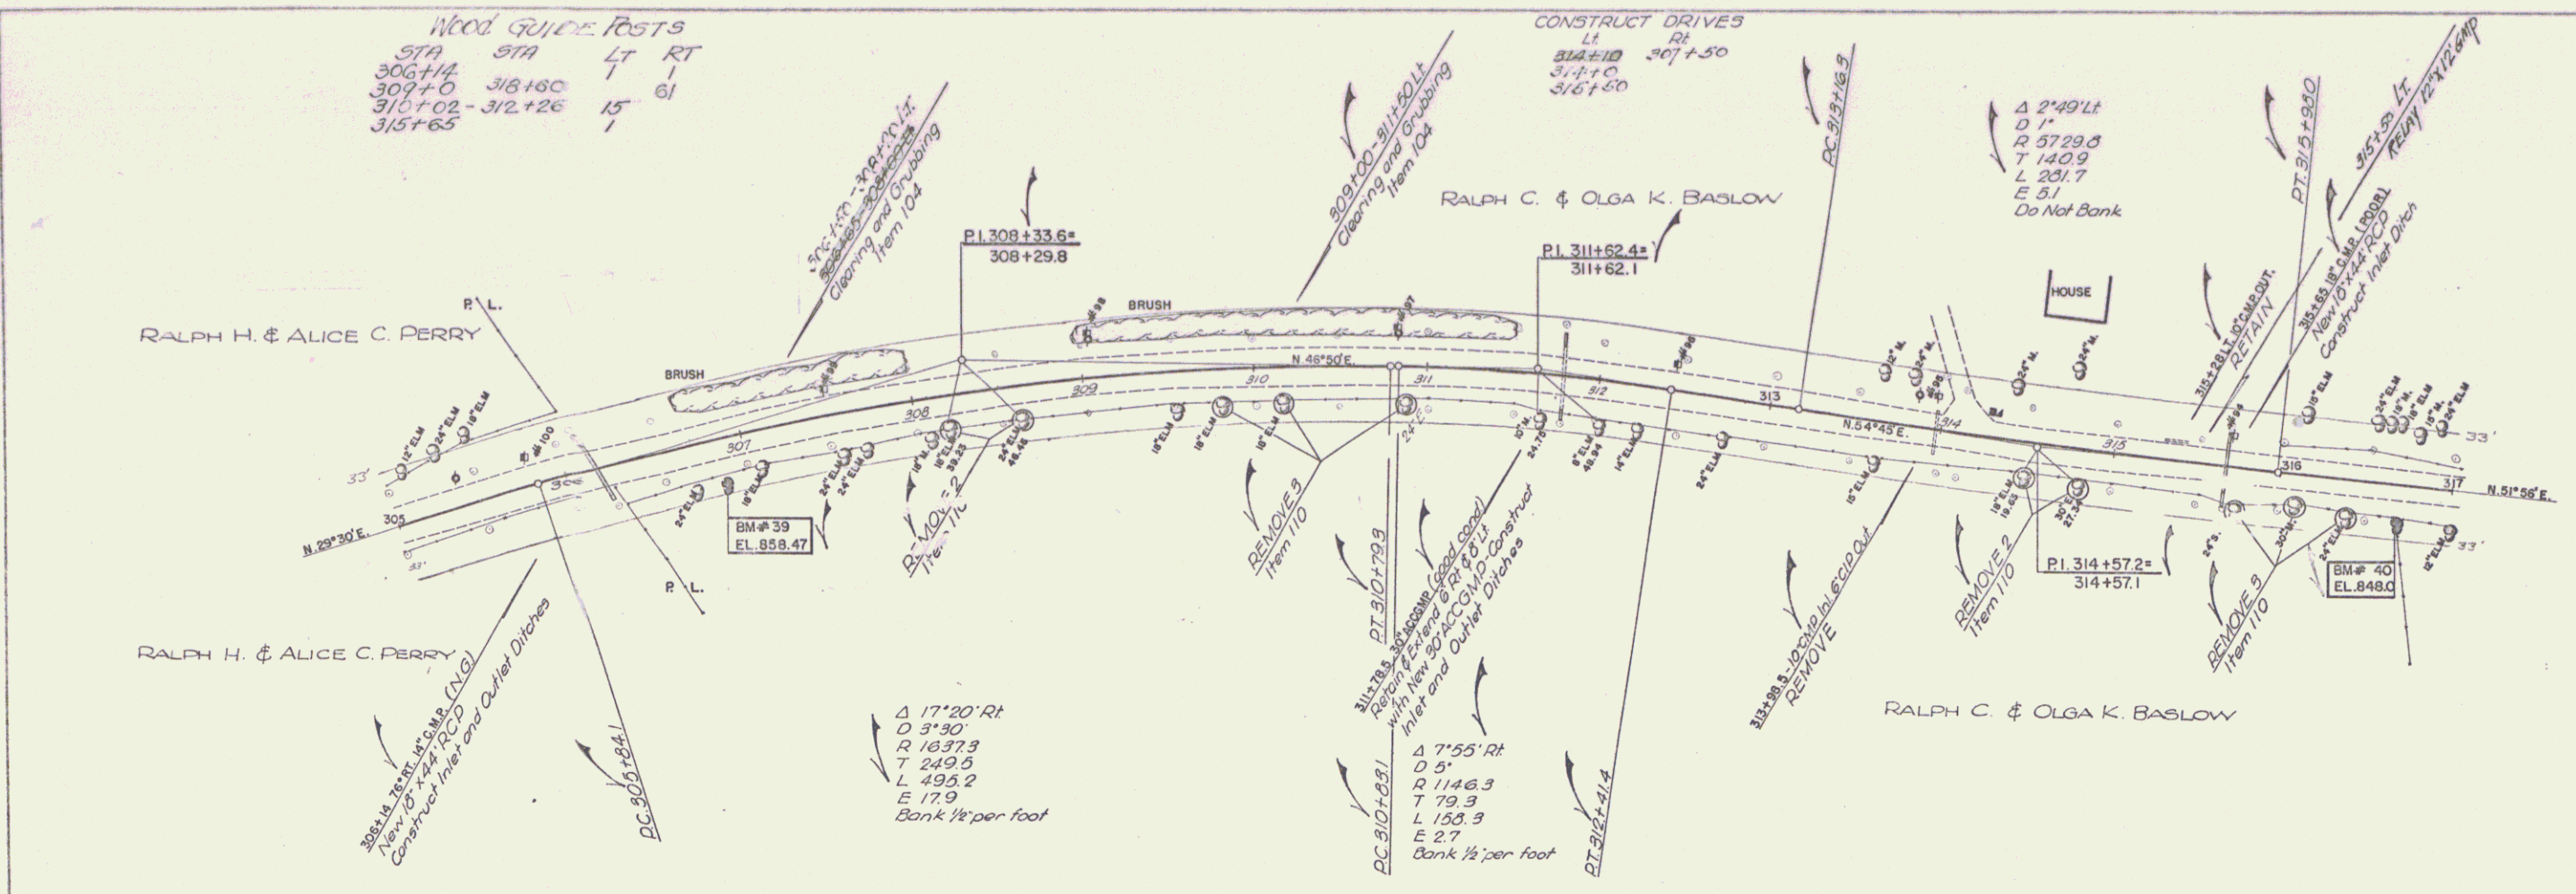

WOOD GUIDE POSTS

STA	STA	LT	RT
306+14	318+60	1	61
309+0	312+26	15	1
310+02	312+26	15	1
315+65			

CONSTRUCT DRIVES

LT	RT
314+10	307+50
314+0	
316+50	

IRA
 PROJECT NO. 21166
 SHEET 22 OF 70