

INDEX OF SHEETS

SHEET NO	TITLE PAGE
1	TYPICAL CROSS SECTION OF IMPROVEMENT, BITUMINOUS CONCRETE PAVEMENT-1750, 2015, 2020
2	QUANTITY SHEET, ITEMS
3	QUANTITY SHEET, DRAINAGE
4	QUANTITY SHEET, EARTHWORK
5	PLAN AND PROFILE SHEETS
6-13	PLAN AND PROFILE SHEETS
14	A-51 DRILLING AND BLASTING
15	B-1 DAMPING TABLES
16	B-2 TYPICAL GRADING OF SLOPES
17	B-16 DIVISIONAL ISLANDS
18	C-1 CURBS
19	C-2 SIDEWALK
20	D-1 DRAINAGE
21	D-2
22	D-3
23	D-4
24	D-5 UNDERDRAIN FLUSHING BASIN AND PIPE ELBOWS
25	D-6 CONCRETE BLOCK CATCH BASIN
26	D-7 DROP INLETS
27	D-8 DROP INLET TOPS
28	D-9 TOP FOR DROP INLET WITH GRANITE SLOPE EDGING
29	D-10 GRATES AND COVERS
30	D-11 CONCRETE CATCH BASINS
31	E-1 GARRICADES, SIGNS AND LIGHTS
32	E-2 THREE CABLE RAIL
33	J-1 MARKER POSTS
34	J-2 PROJECT MARKERS
35	J-3 CROSS SECTIONS

PROJECT	NUMBER	TYPE	SURFACE AREA
Montpelier	SP-U 028-2 (2)	Bituminous Concrete	12,625 sq

RECORD PLANS MATERIALS


GRASS - Elm St. Berlin, Vt.	STEEL CO COVERS - LeBaron Foundry, Lynn, Mass.
SAND - Caladenia Sand & Gravel Co. Pitt., Plainfield, Vt.	CAST IRON - Vermont Structural Steel Corp., Burlington, Vt.
GRAVEL - Caladenia Sand & Gravel Co. Pitt., Plainfield, Vt.	WOODHUNT IRON - R.M. McDonald's Co., Duxbury, Vt.
GRAVEL - Caladenia Sand & Gravel Co. Pitt., Plainfield, Vt.	RCD - Vermont Concrete Pipe Co., Duxbury, Vt.
GRAVEL - Caladenia Sand & Gravel Co. Pitt., Plainfield, Vt.	Home Pipe Co., Swanton, Vt.
GRAVEL - Caladenia Sand & Gravel Co. Pitt., Plainfield, Vt.	ACCUM - New England Metal Co., Palmer, Mass.
GRAVEL - Caladenia Sand & Gravel Co. Pitt., Plainfield, Vt.	C&M - Smith Quarry, Dorset, Vt.
GRAVEL - Caladenia Sand & Gravel Co. Pitt., Plainfield, Vt.	GRANITE - Rock of Ages Corp., Danby, Vt.
GRAVEL - Caladenia Sand & Gravel Co. Pitt., Plainfield, Vt.	BOUNDARY MARKERS - S.T. Griswold Co., Essex Junction, Vt.
GRAVEL - Caladenia Sand & Gravel Co. Pitt., Plainfield, Vt.	SEED - E.W. Bailey & Co., Montpelier, Vt.
GRAVEL - Caladenia Sand & Gravel Co. Pitt., Plainfield, Vt.	FERTILIZER - E.W. Bailey & Co., Montpelier, Vt.
GRAVEL - Caladenia Sand & Gravel Co. Pitt., Plainfield, Vt.	MULCH - W.C. Kirby, Cochr., Burlington, Vt.

CONTRACT DATED March 18, 1959
 CONTRACT STARTED March 18, 1959
 CONTRACT ACCEPTED July 12, 1960

STATE OF VERMONT
 DEPARTMENT OF HIGHWAYS
PROPOSED IMPROVEMENT
 URBAN PROJECT
CITY OF MONTPELIER
 COUNTY OF WASHINGTON
 ROUTE U.S. 2 SPUR
 MONTPELIER INTERCHANGE -
 CITY OF MONTPELIER CONNECTION


BEGINNING AT A POINT 0.820 MILES WESTERLY OF THE ROUTE U.S. 2 AND VT. ROUTE 12 INTERSECTION AND EXTENDING EASTERLY 0.361 MI.
 LENGTH OF PROJECT 1,907.1 FEET V = 0.361 MILE

1958 ADT	500
1960 ADT	8700
DHW	1240
T	5%
D	5%
V	40 MPH

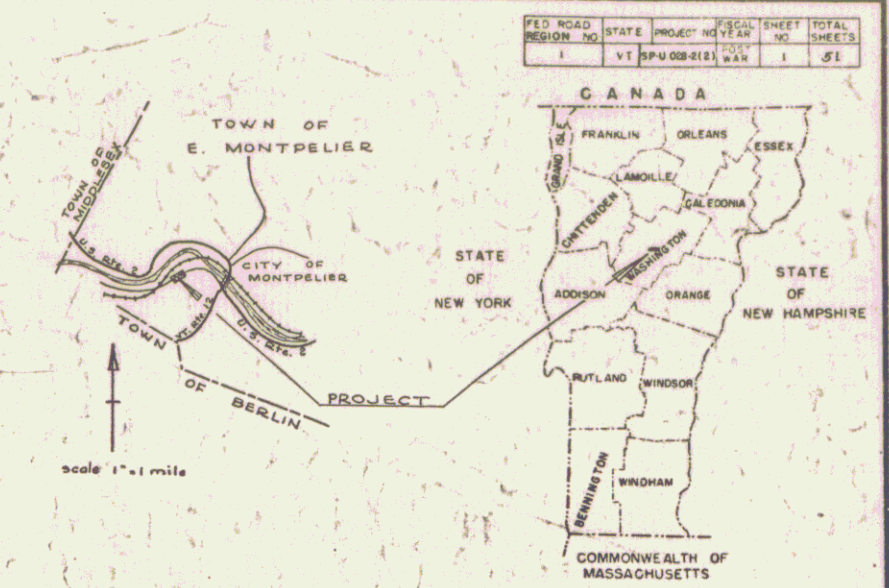

MP 0.493
 27+00.0 = 530 + 34.2
 LIMITS OF RAMP BEGIN PROJECT
 PROJ. I-09-2 (3) SP-U-028-2 (2)

MP 0.854
 540 + 500 / LIMITS OF
 END PROJECT / PROJ. FFG 2450)
 SP-U-028-2 (2) 1958

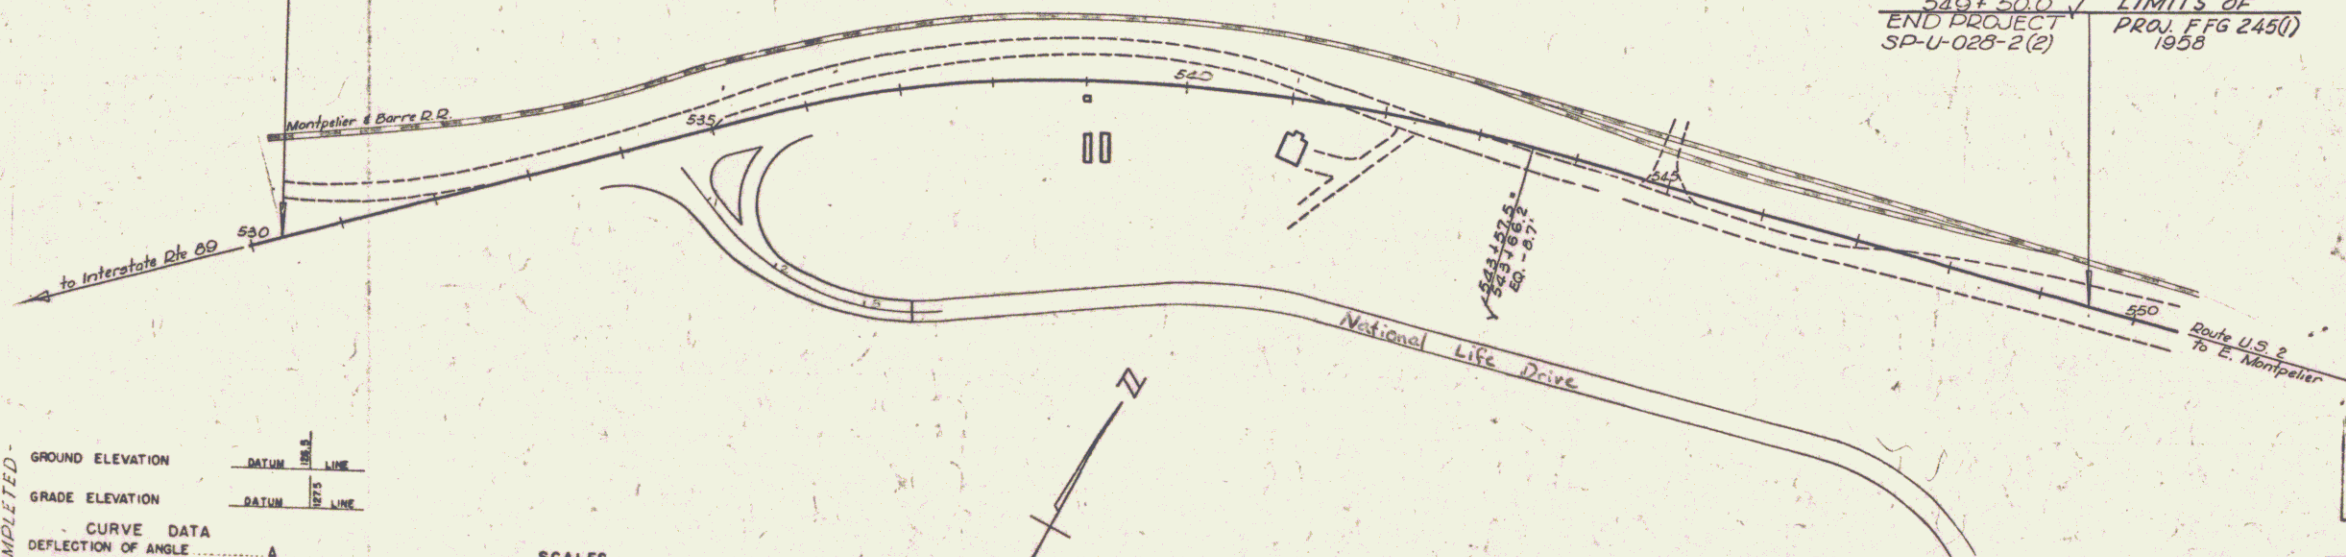

GROUND ELEVATION DATUM 1928 LINE

GRADE ELEVATION DATUM 1928 LINE

CURVE DATA

DEFLECTION OF ANGLE	Δ
DEGREE OF CURVE	D
RADIUS OF CURVE	R
TANGENT DISTANCE	T
LENGTH OF CURVE	L
EXTERNAL DISTANCE	E
POINT OF INTERSECTION	P.I.
POINT OF CURVE	P.C.
POINT OF TANGENT	P.T.
POINT ON TANGENT	P.O.T.
POINT ON SUB-TANGENT	POST

SCALES

TITLE	1" = 100'
TYPICAL	1" = 5'
PROFILE HORIZONTAL	1" = 20'
PROFILE VERTICAL	1" = 10'
CROSS SECTIONS	1" = 5' 410'

RIGHT-OF-WAY DIVISION
 TOWN FILE
 PERPETUAL
 Montpelier State Hwy.
 Town of Montpelier
 (To Be Returned To R.O.W. Division)

Pin # 99R670
 Route: ST HWY

NOTE: ANY FURTHER INFORMATION CONCERNING FINAL QUANTITIES, AMOUNTS OF MATERIALS RELATIVE TO THIS PROJECT MAY BE OBTAINED EITHER THE FIELD BOOKS OR THE ESTIMATE FILE.

THESE PLANS ARE SUBJECT TO SUCH REVISIONS AS MAY BE REQUIRED BY THE BUREAU OF PUBLIC ROADS OR THE COMMISSIONER OF HIGHWAYS.
 CONSTRUCTION IS TO BE CARRIED ON IN ACCORDANCE WITH THE PLANS AND THE STANDARD SPECIFICATIONS FOR HIGHWAY AND BRIDGE CONSTRUCTION OF JANUARY 1956 SUBMITTED TO THE BUREAU OF PUBLIC ROADS AS APPROVED JULY 5, 1956, INCLUDING ALL SUBSEQUENT APPROVED REVISIONS AND SUCH REVISED SPECIFICATIONS AND SPECIAL PROVISIONS AS ARE SUBMITTED WITH THE PLANS.

DEPARTMENT OF COMMERCE
 BUREAU OF PUBLIC ROADS

APPROVED _____ DATE _____

DIVISION ENGINEER _____ DATE _____

PROJECT SP-U No. 028-2(2)

SHEET 1 OF 51 SHEETS

APPROVED _____ DATE _____

APPROVED W. J. Taylor DATE 10-24-1958

APPROVED _____ DATE _____

APPROVED R. F. Taylor DATE October 23, 1958

APPROVED W. M. Lane DATE 10-24-58

APPROVED H. E. Skagut DATE 10-24-58

3" BITUMINOUS CONCRETE PAVEMENT

CALADENIA SAND & GRAVEL CO. INC.
 ST. JOHNSBURY, VERMONT

Location Beginning at a point 0.820 miles westerly of the Route U.S. 2 and Vermont Route 12 intersection and extending easterly 0.361 miles.

MONTPELIER - SP-U 028-2 (2)
 CONTROL PLAN
 RECORD PLAN
 CONSTRUCTION COMPLETED