

Survey  
 POT 534+37.9=  
 0+05.66 APPR RT  
 Δ 66° 52' 30"

GRANITE SLOPE EDGING  
 (MEDIAN)  
 533+00-534+30  
 535+34.8-539+00  
 (1314.01) 535+00 RI  
 THREE CABLE GUARD RAIL  
 WITH STEEL POSTS  
 533+00 LT-535+92 LT  
 536+00

CONCRETE GRAVITY CURB  
 536+25-539+00 Lt & Rt

CONSTRUCT APPROACH  
 535+00 RT  
 Sheets 13 and 49 to 51 of 51




CONCRETE CLASS B IN MEDIAN  
 535+36.8-536+60.5

SEEDING COMMERCIAL FERTILIZER  
 FOR GRASSES, AND TOPSOIL  
 533+00-534+37 in median  
 535+00 Island rt  
 536+60-539+00 in median

BM # 7  
 US ELEV.  
 523.96

PI 536+93.4=  
 536+92.2

BM # 7-A  
 US Elev  
 522.56

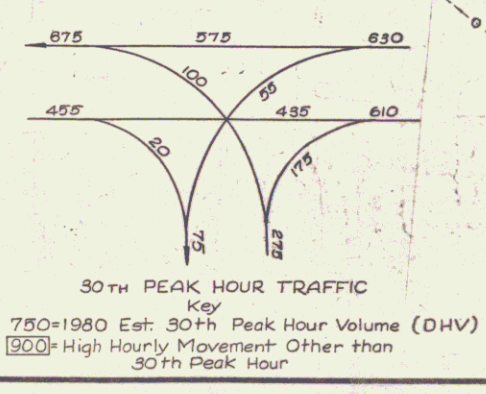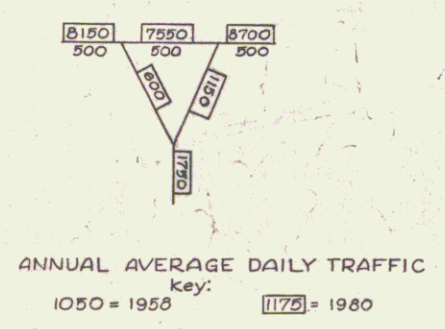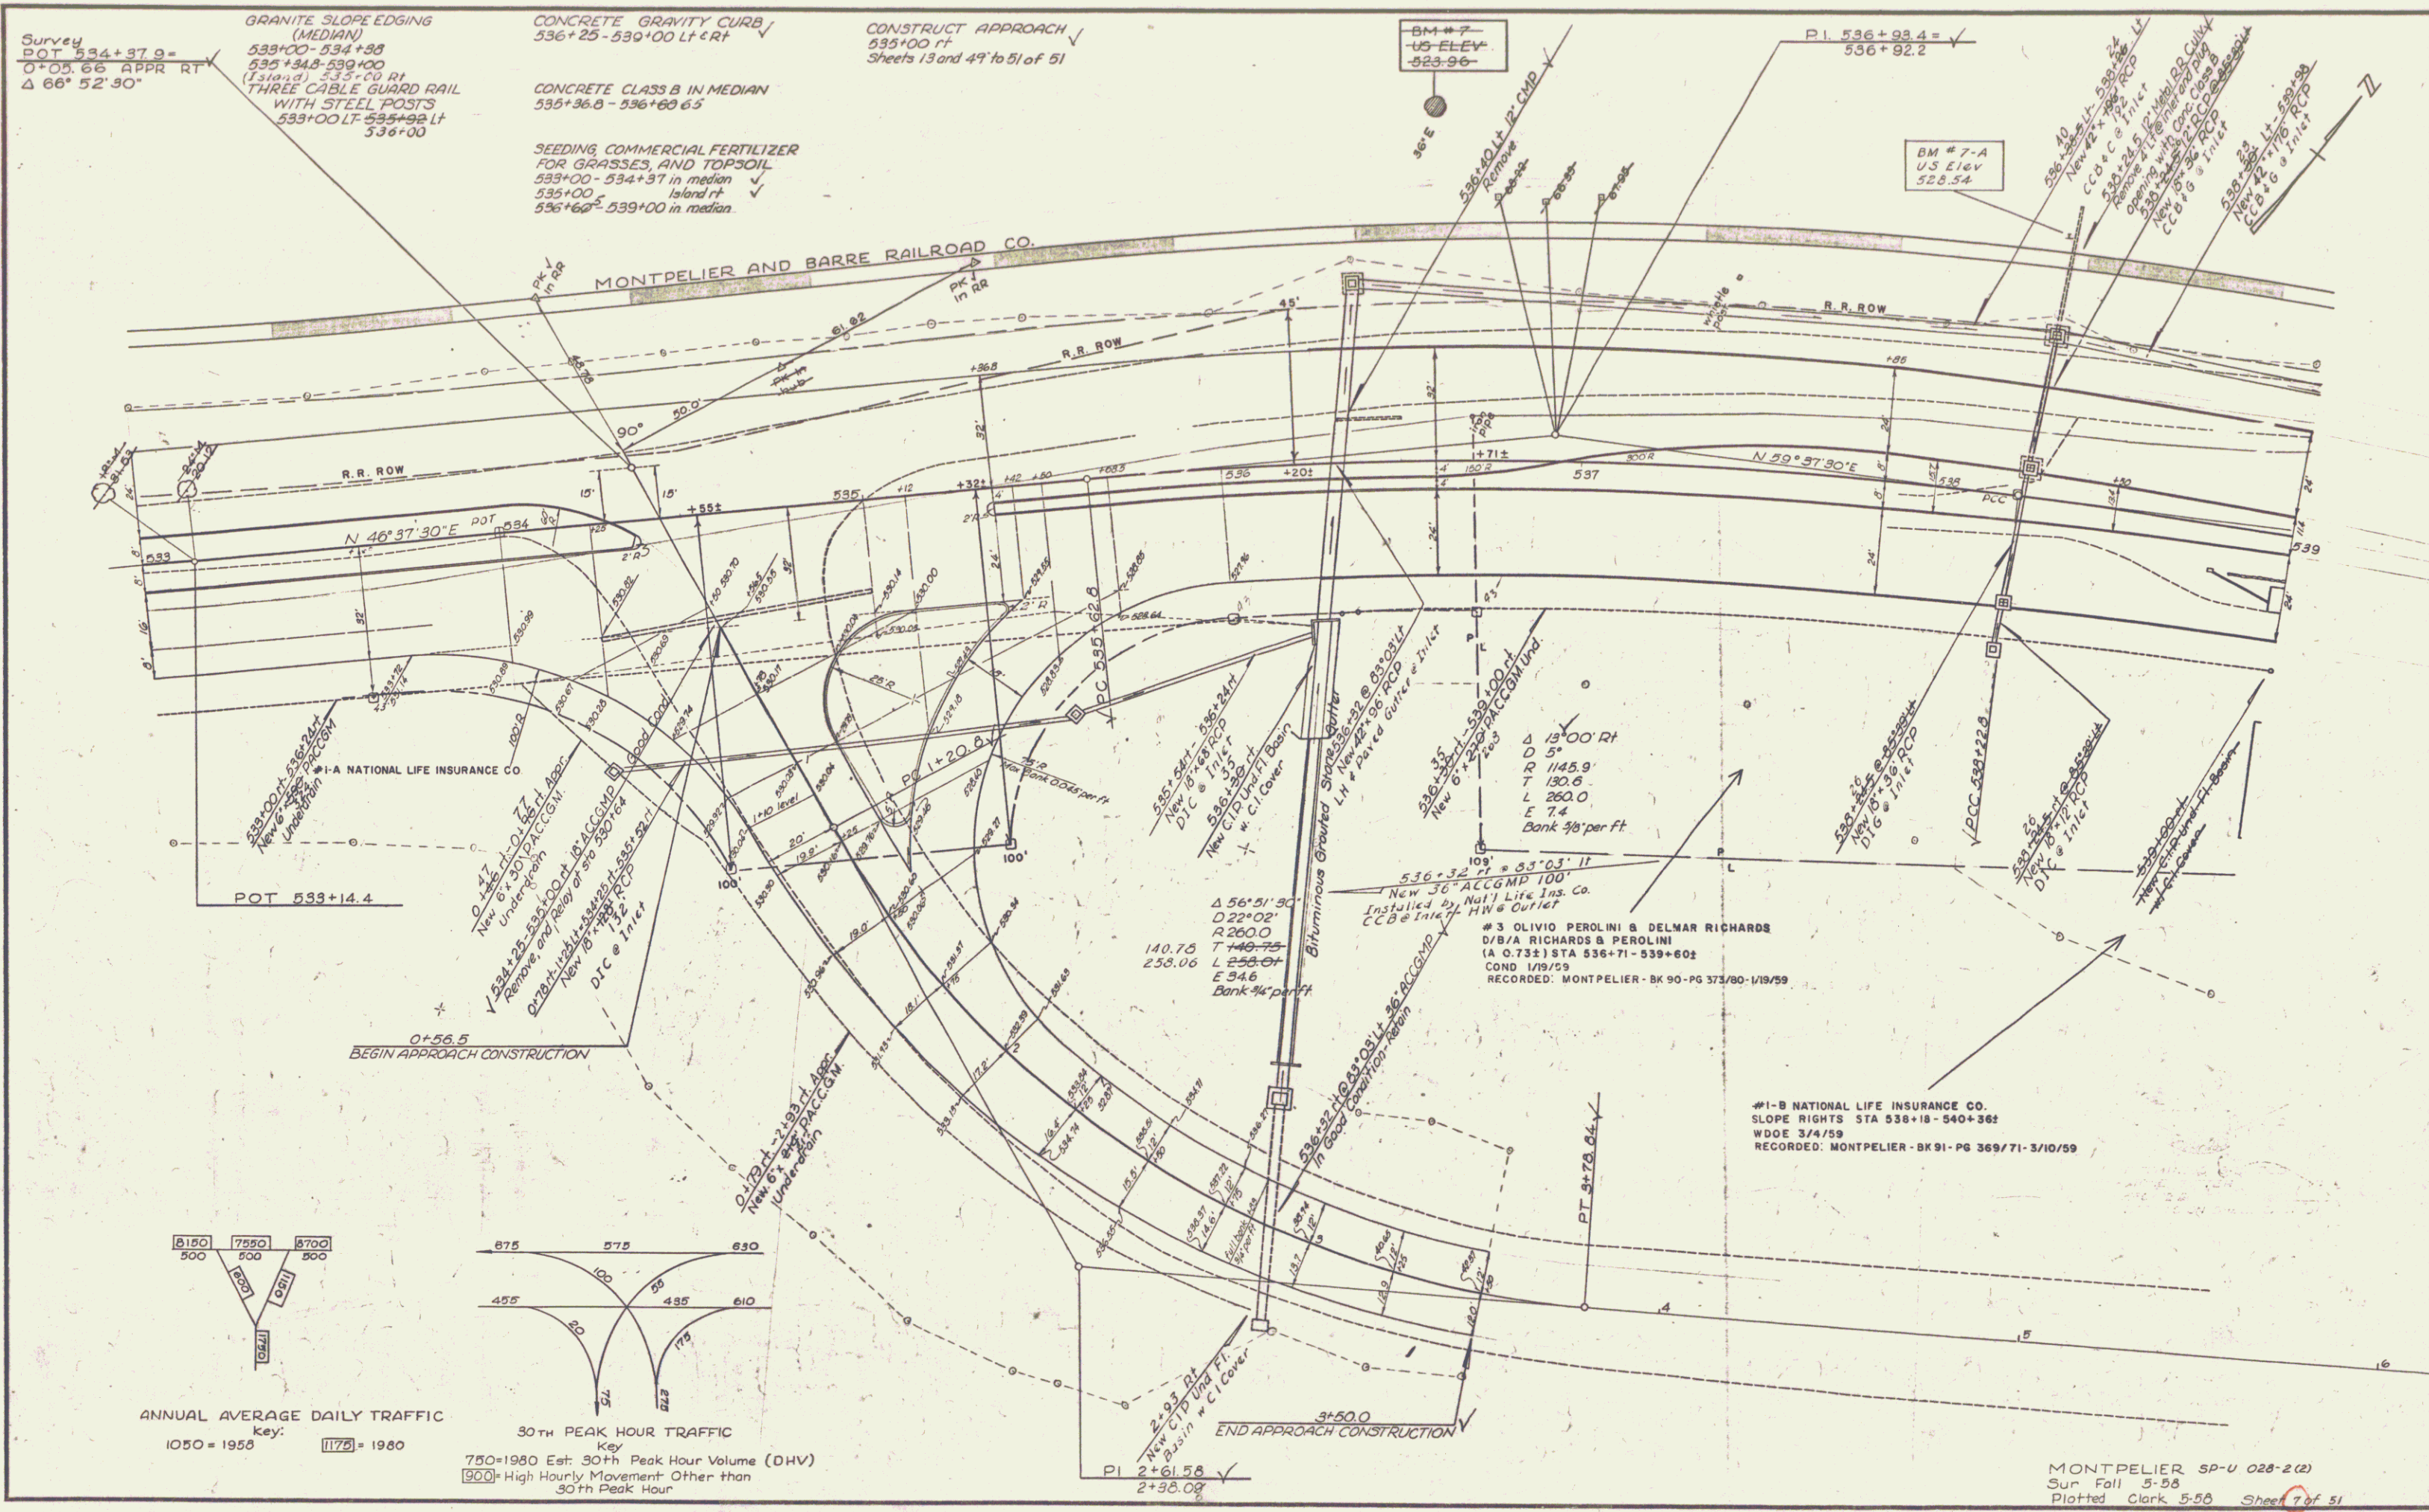

MONTPELIER 5P-U 028-2(2)  
 Sur Fall 5-58  
 Plotted Clark 5-58 Sheet 7 of 51