



PLAN
 DATE: 10/15/87
 DRAWN BY: [unclear]
 CHECKED BY: [unclear]
 TITLE: [unclear]

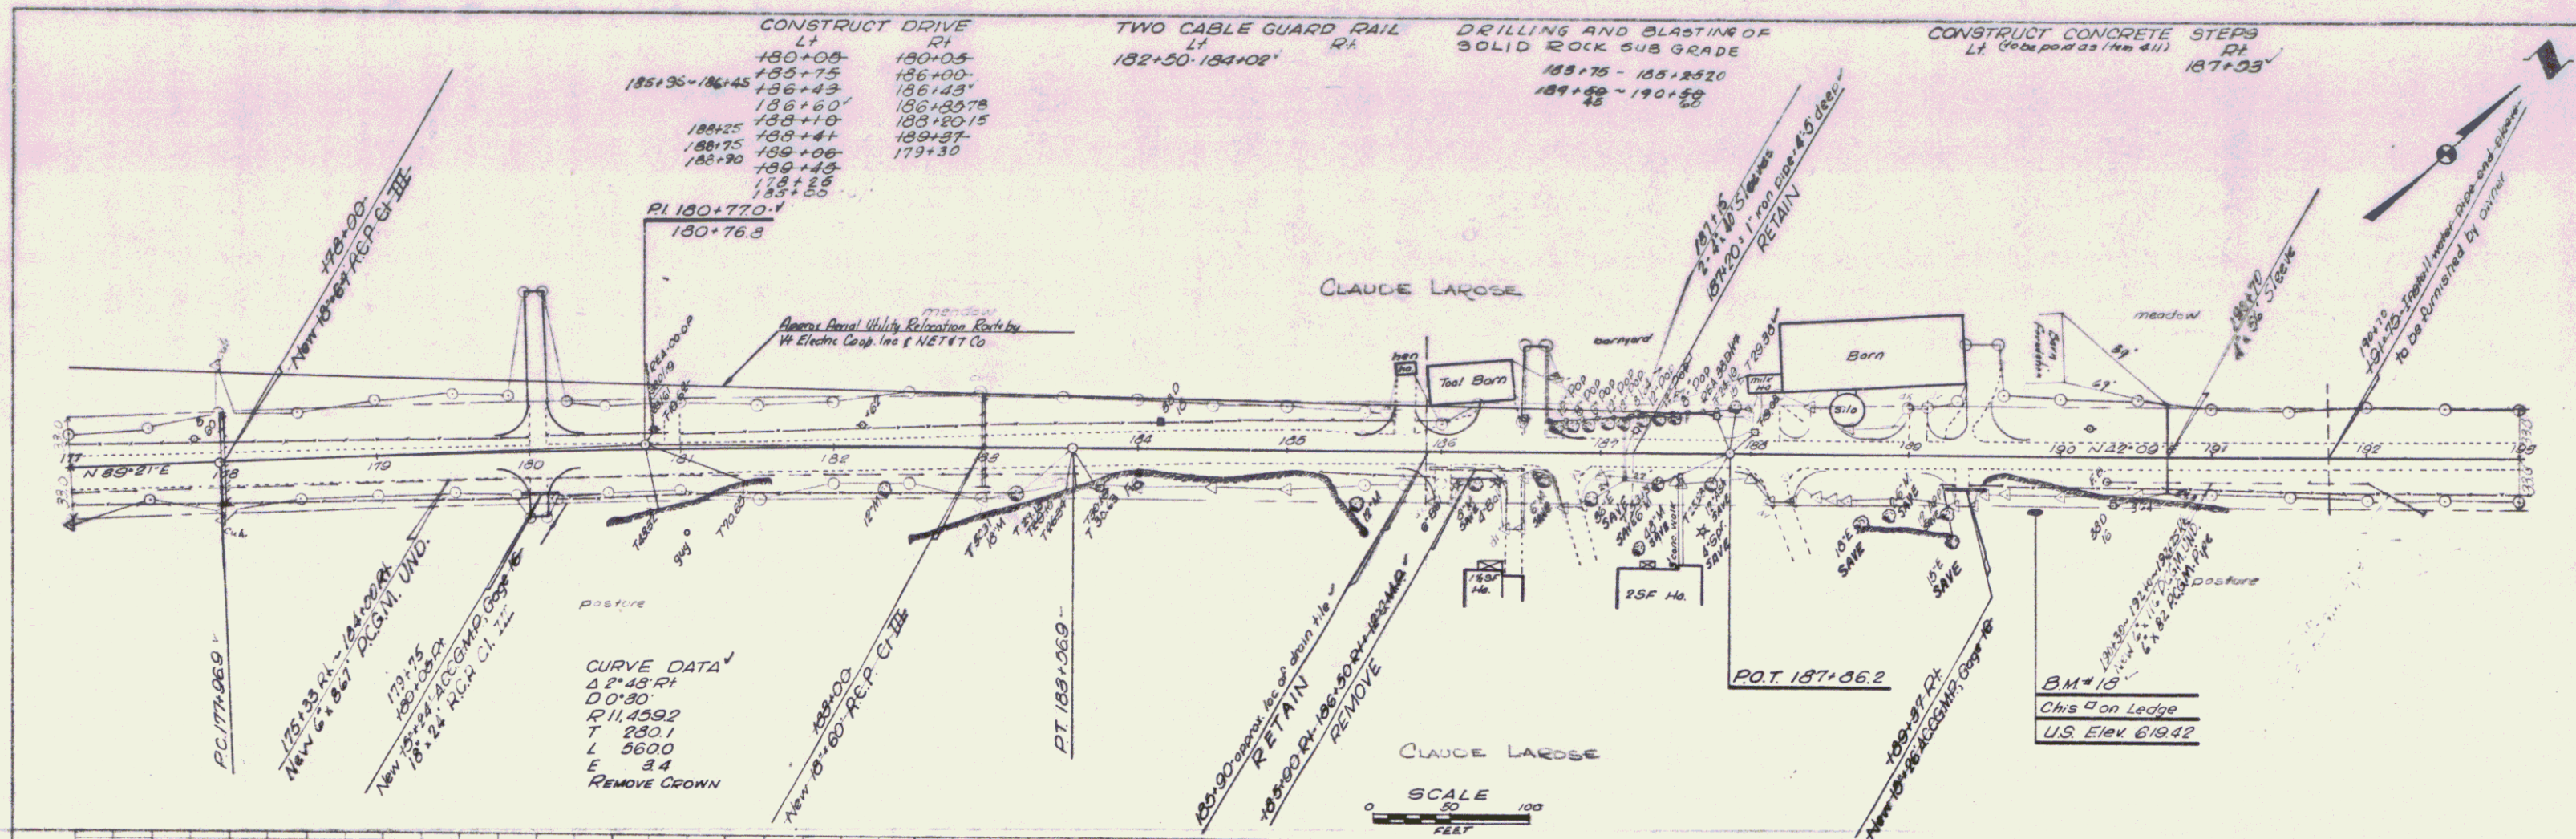

PROFILE
 DATE: 10/15/87
 DRAWN BY: [unclear]
 CHECKED BY: [unclear]
 TITLE: [unclear]

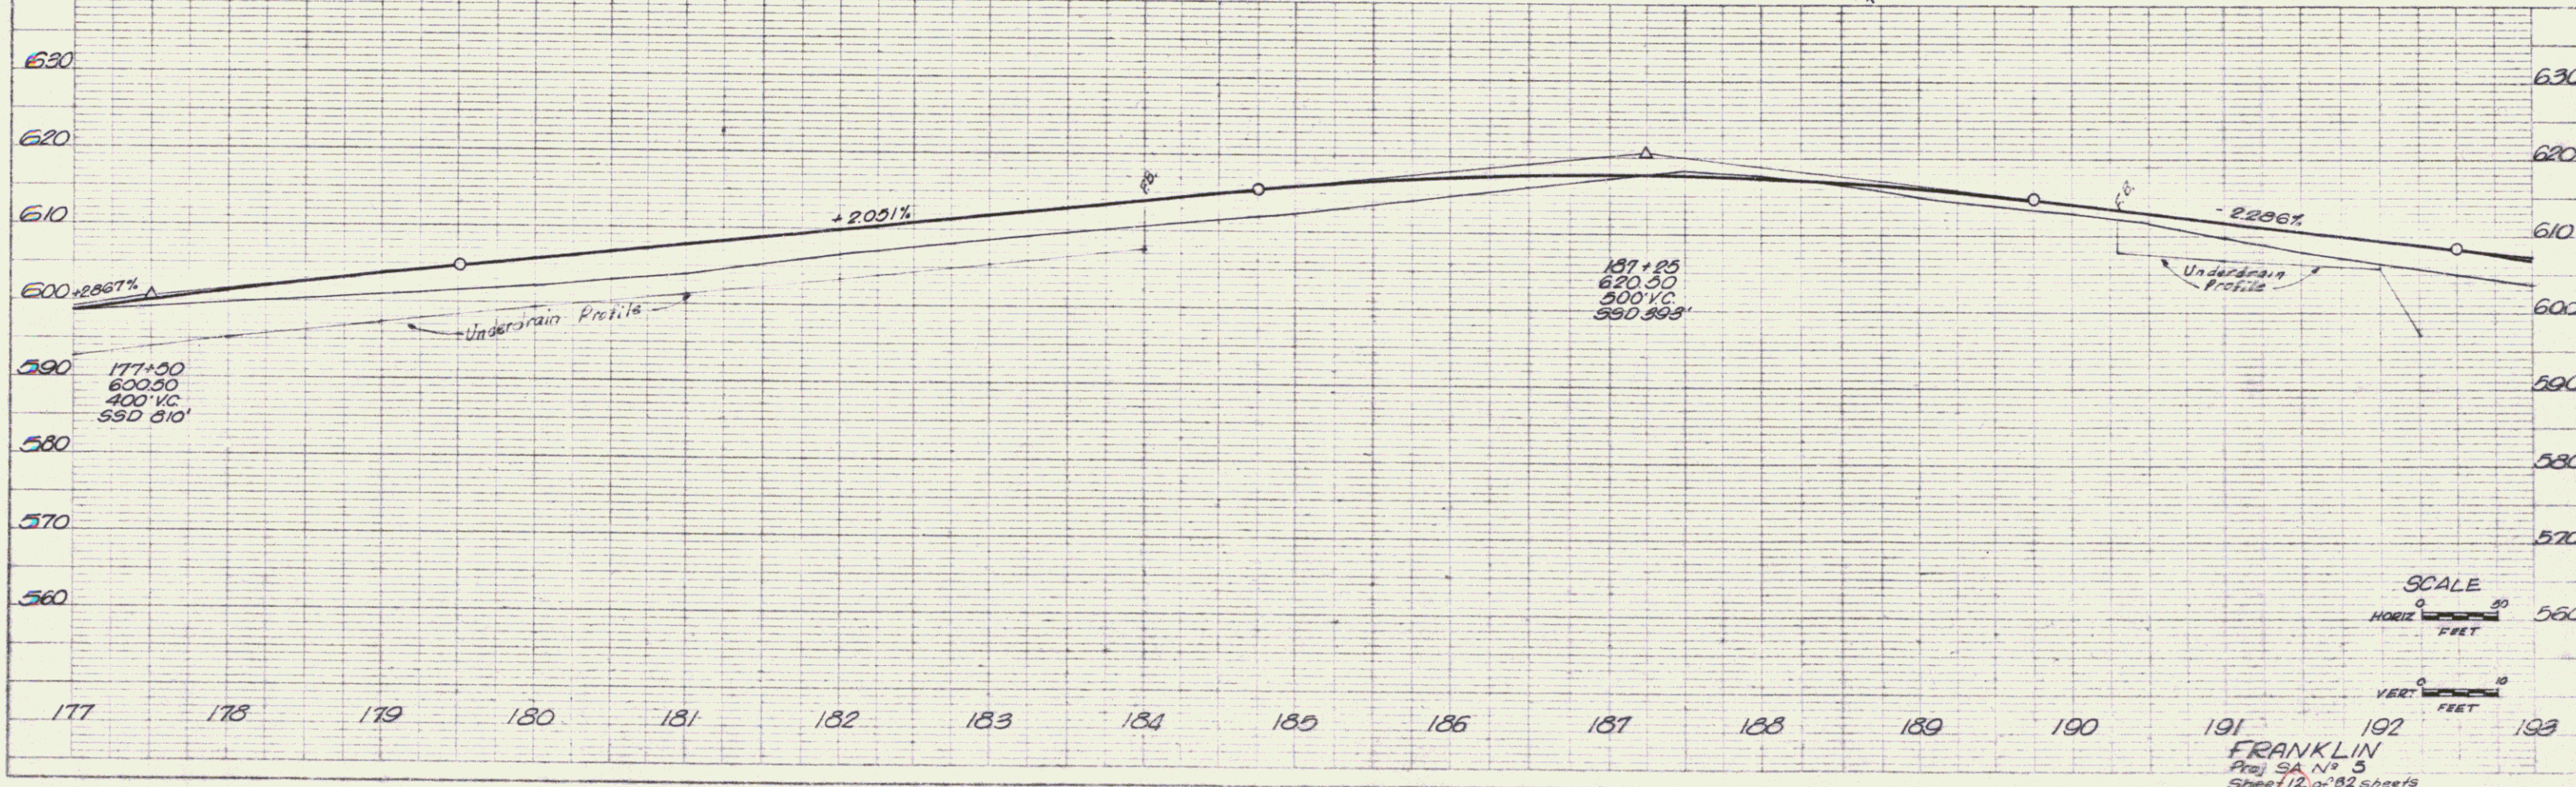

K-E
 DATE: 10/15/87
 DRAWN BY: [unclear]
 CHECKED BY: [unclear]