
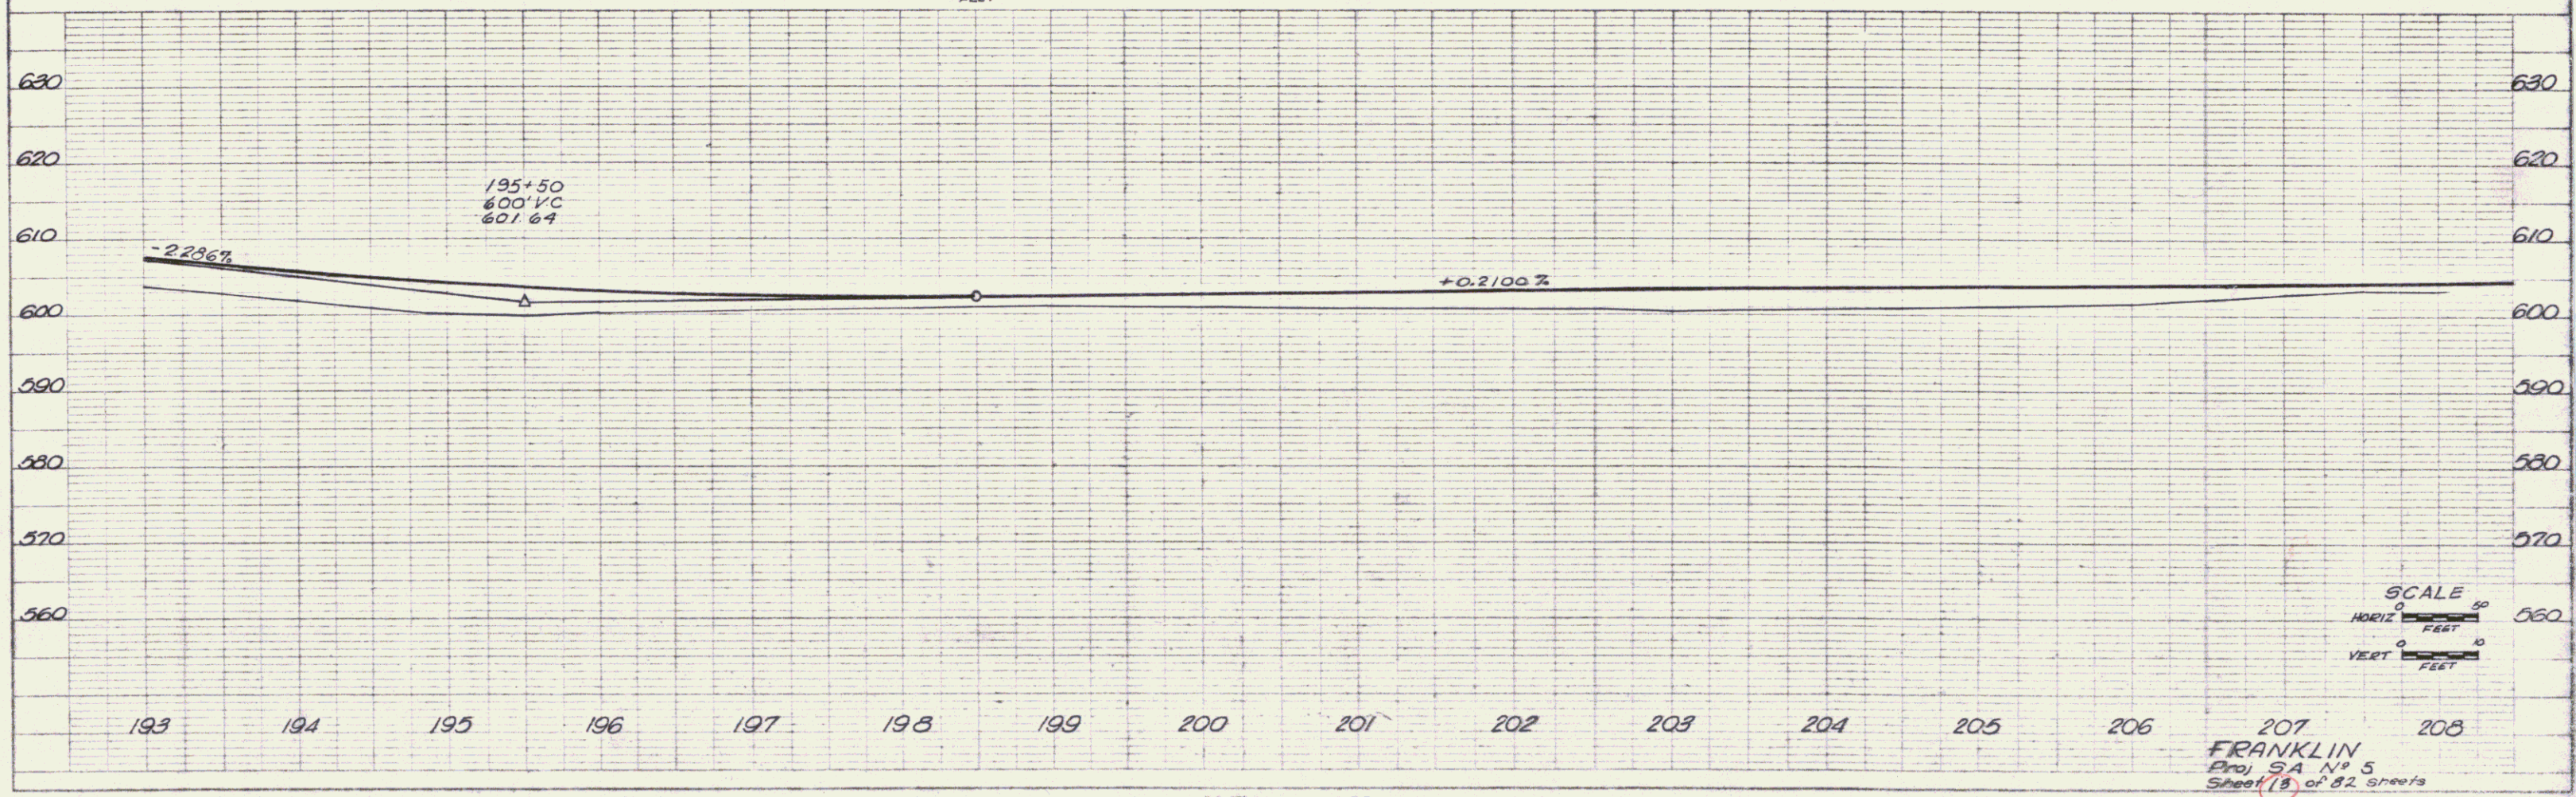


PLAN  
 DATE 7-87  
 DRAWN BY JAW  
 CHECKED BY JAW  
 TITLED

PROFILE  
 DATE 7-87  
 DRAWN BY JAW  
 CHECKED BY JAW  
 TITLED

CONSTRUCT DRIVE  
 LI 196+85 203+30  
 200+20.5 207+90  
 206+13 204+78  
 208+55  
 207+50  
 209+00  
 197+00

CURVE DATA  
 45° 53' LI  
 D 1'  
 R 5729.6  
 T 293.6  
 L 596.7  
 E 78  
 REMOVE CROWN

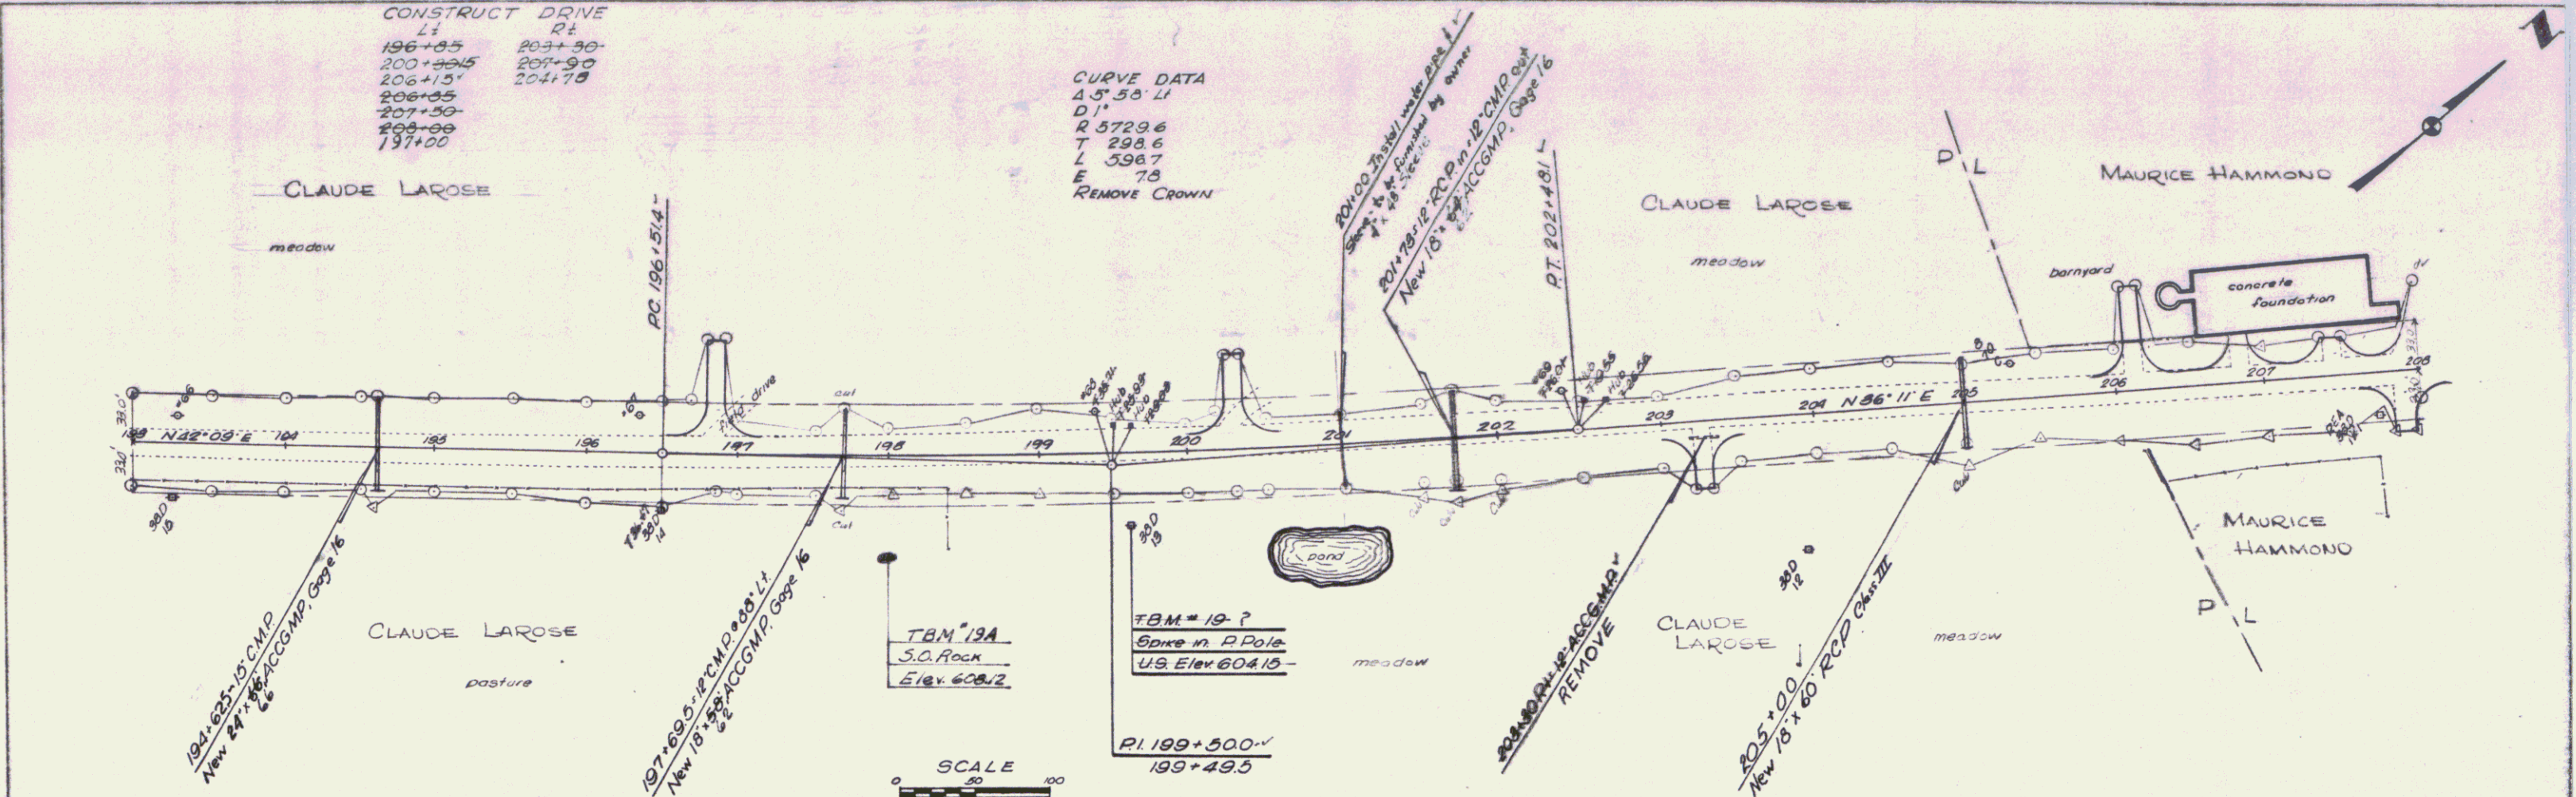

FRANKLIN  
 Proj SA N° 5  
 Sheet 15 of 82 sheets