
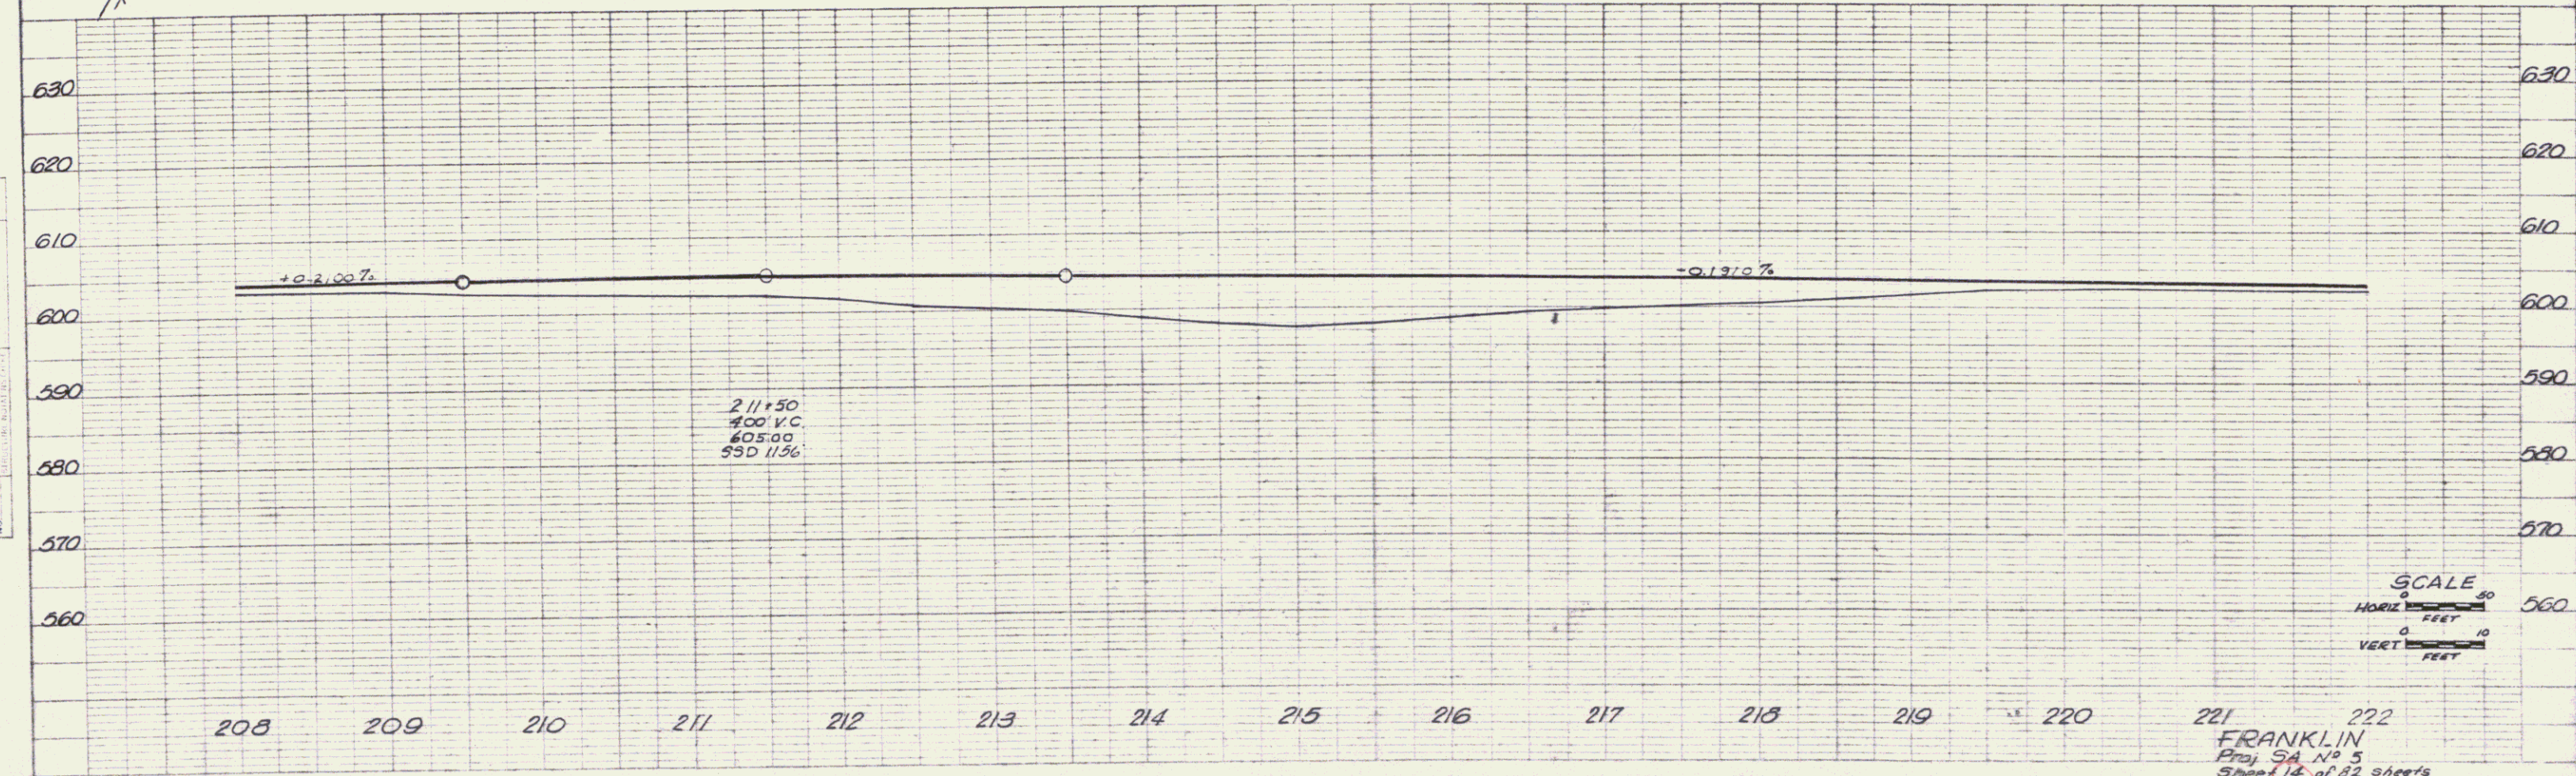


PLAN  
 DRAWN BY: *WAL*  
 CHECKED BY: *WAL*  
 DATE: *5/23/83*  
 PROJECT: *WAL*  
 SHEET: *583*

PROFILE  
 DRAWN BY: *WAL*  
 CHECKED BY: *WAL*  
 DATE: *5/23/83*  
 PROJECT: *WAL*  
 SHEET: *583*

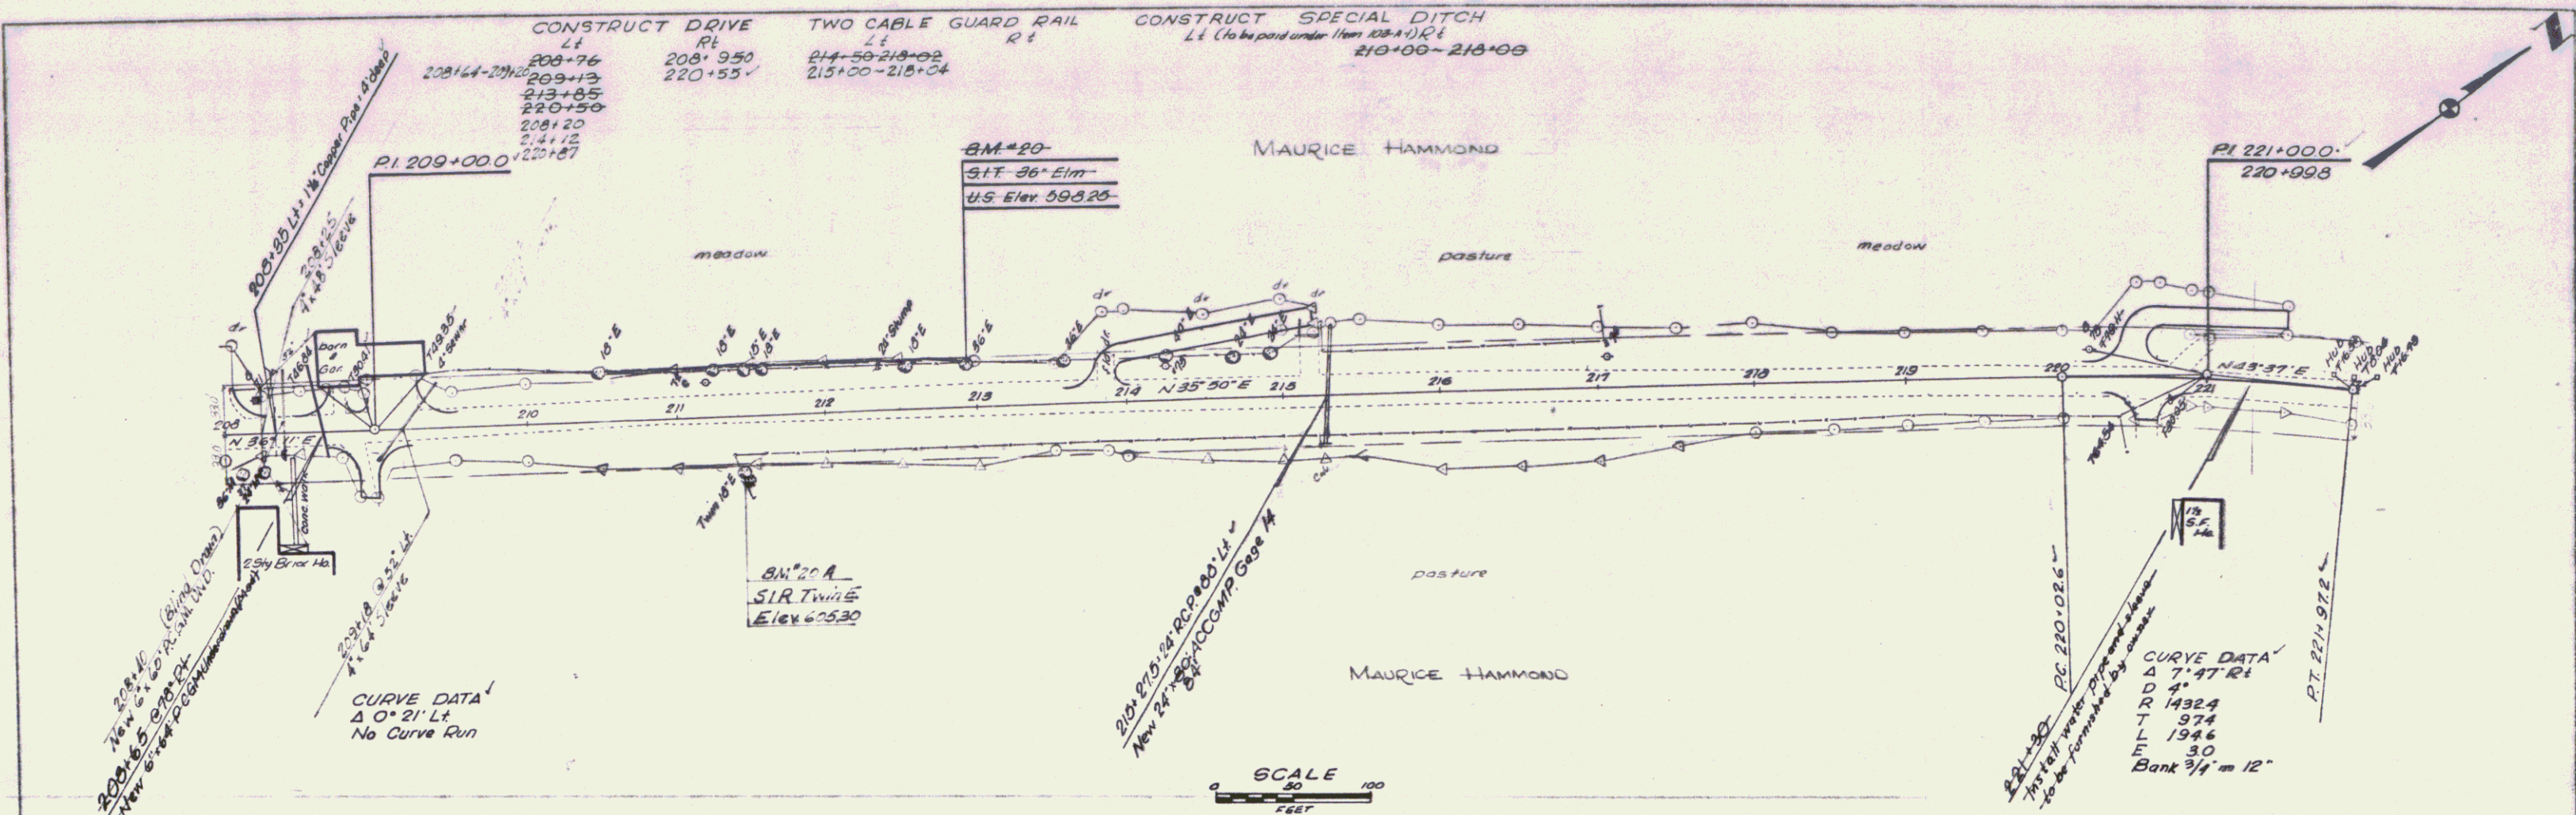

FRANKLIN  
 Proj SA No 5  
 Sheet 12 of 82 sheets