
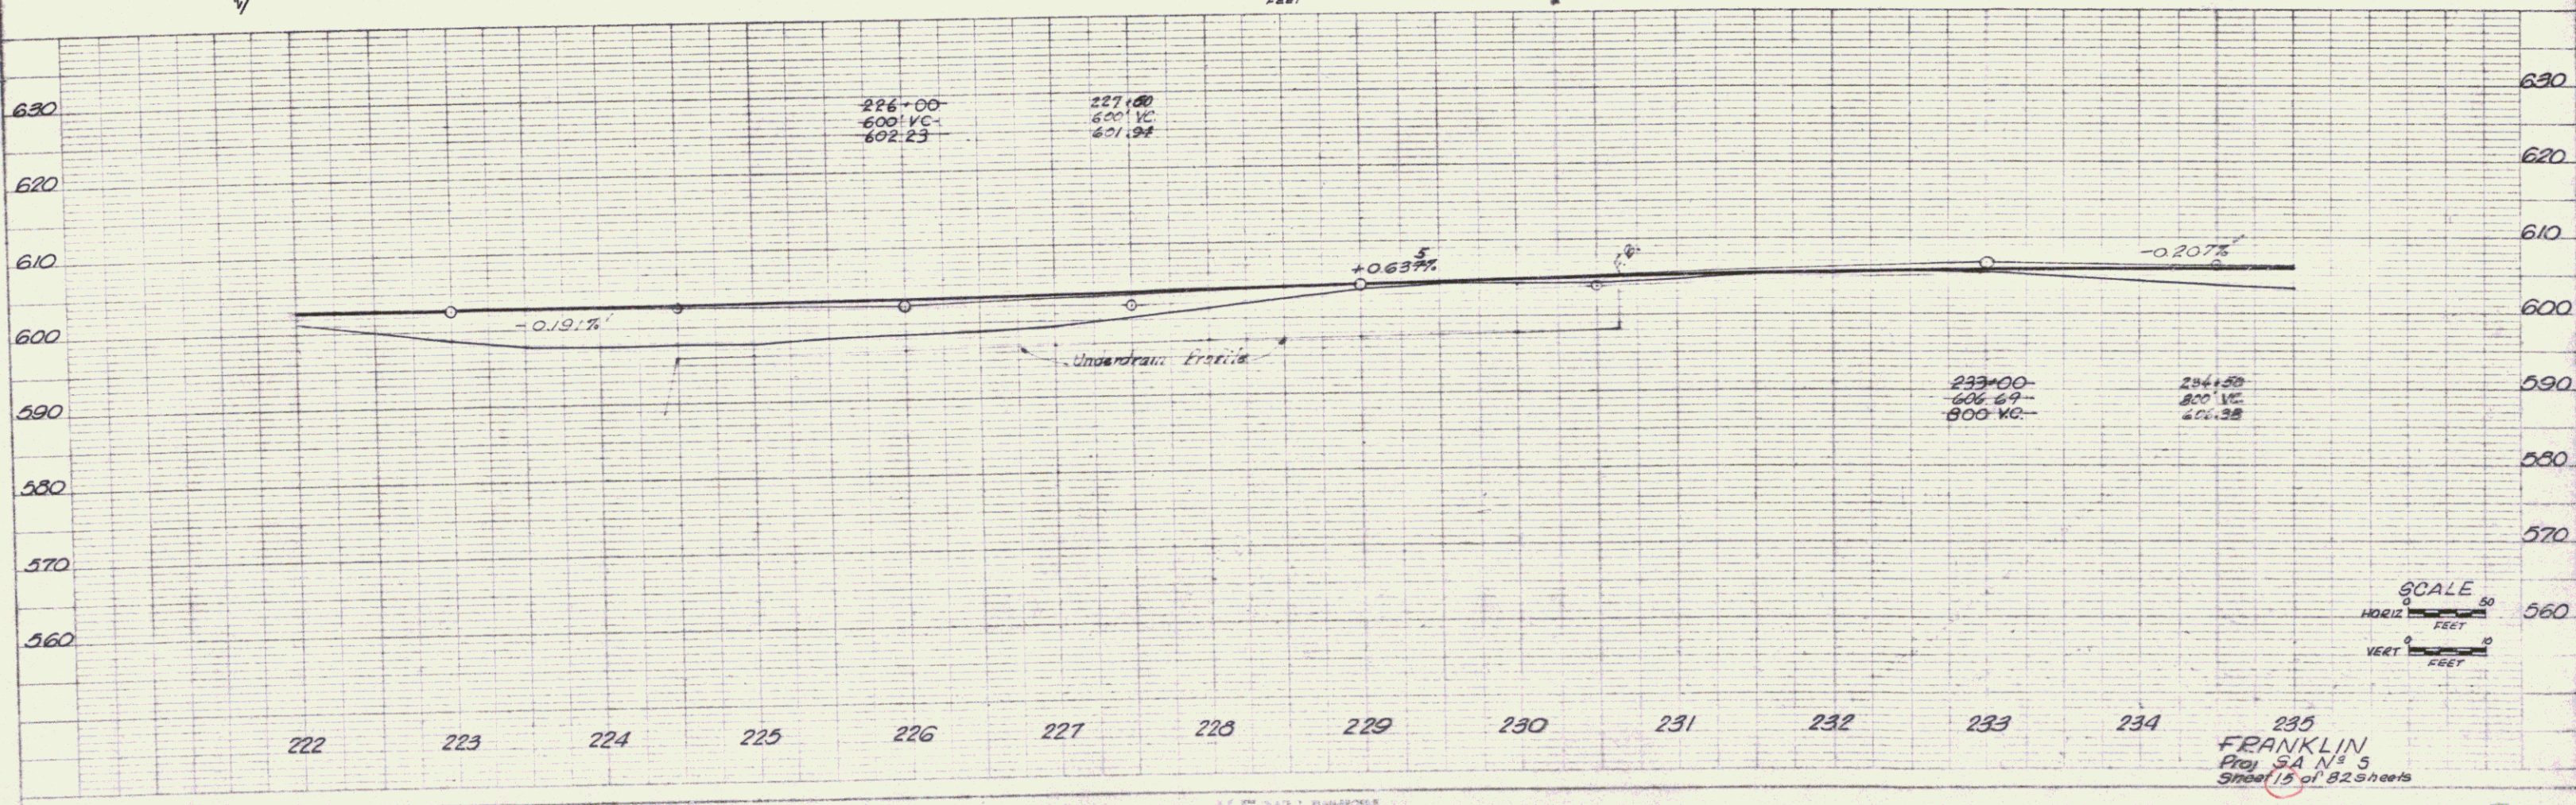


CONSTRUCT DRIVE Lt 230+00 231+50 232+20/3 232+75 233+60 235+00 229+58-231+68	TWO CABLE GUARD RAIL Lt 222+47.38 231+15.25 232+50 232+24-233+30 229+58-231+68	CONSTRUCT SPECIAL DITCH Under Item 103-A-I Lt 227+50-235+65
---	---	---

PLAN
DATE: 10/15/87
SCALE: 1"=40'
DRAWN BY: J. H. [unclear]
CHECKED BY: [unclear]

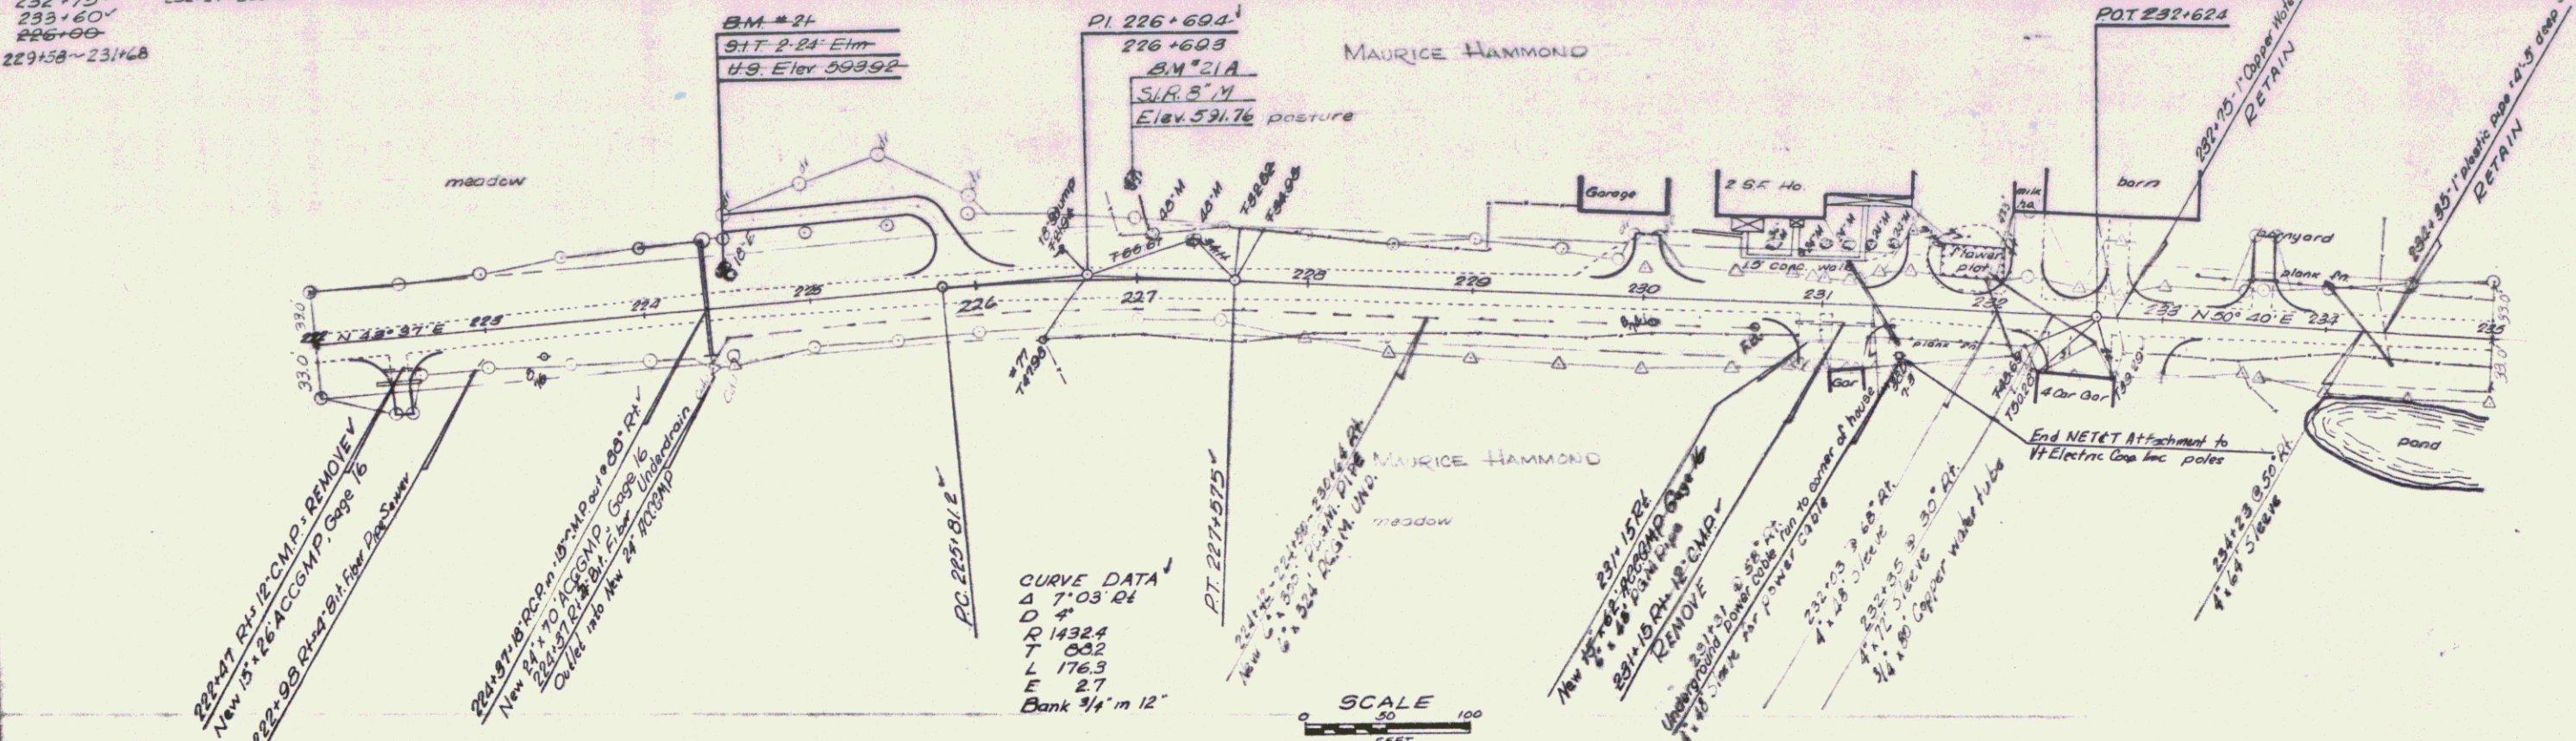

PROFILE
DATE: 10/15/87
SCALE: 1"=40'
DRAWN BY: J. H. [unclear]
CHECKED BY: [unclear]

235
FRANKLIN
Proj. SA N 5
Sheet 15 of 82 sheets