
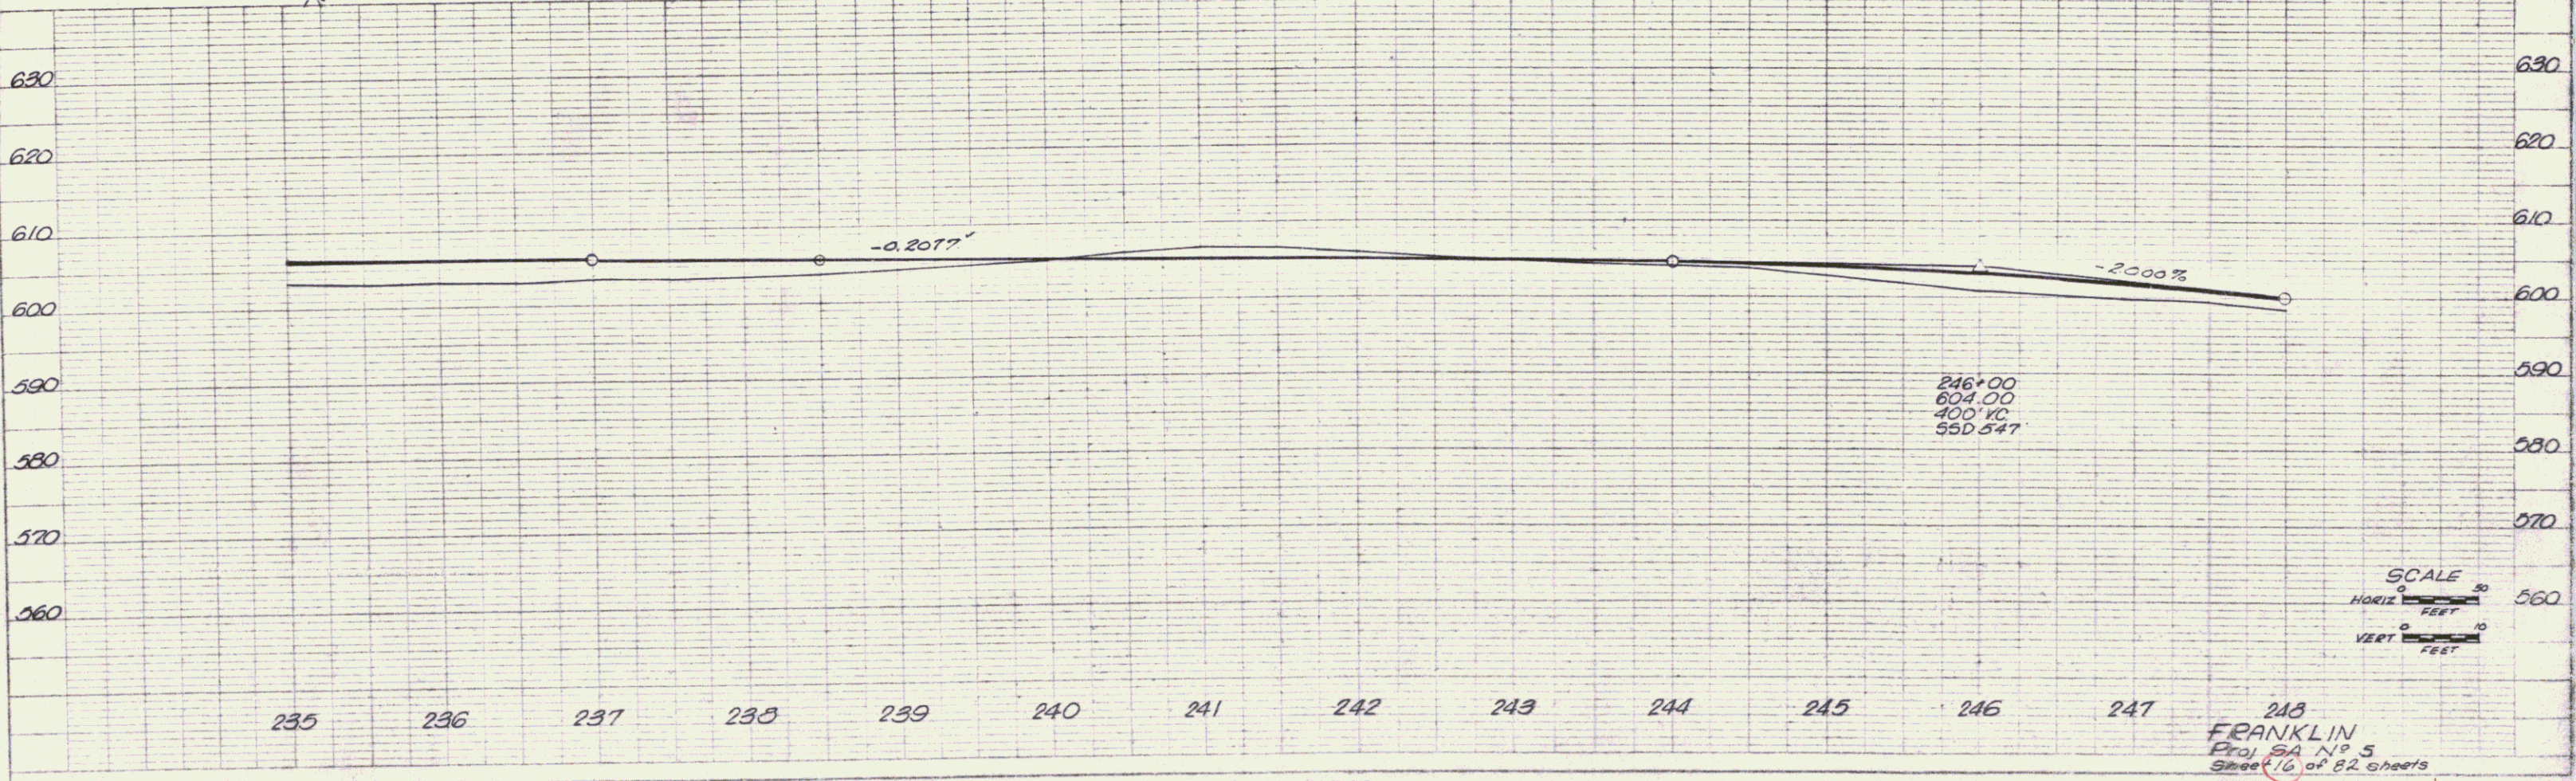


PLAN
 DATE: 10/1/58
 DRAWN BY: S.M.
 CHECKED BY: J.A.L.
 TRACED BY: S.M.

PROFILE
 DATE: 10/1/58
 DRAWN BY: S.M.
 CHECKED BY: J.A.L.

CONSTRUCT DRIVE CONSTRUCT APPROACH TWO CABLE GUARD RAIL
 Lt Rt Lt Rt Lt Rt
 230+00.20 244+19.00 236+50 235+25-238+45 245+50-248+00
 242+15 241+25 24+10.5

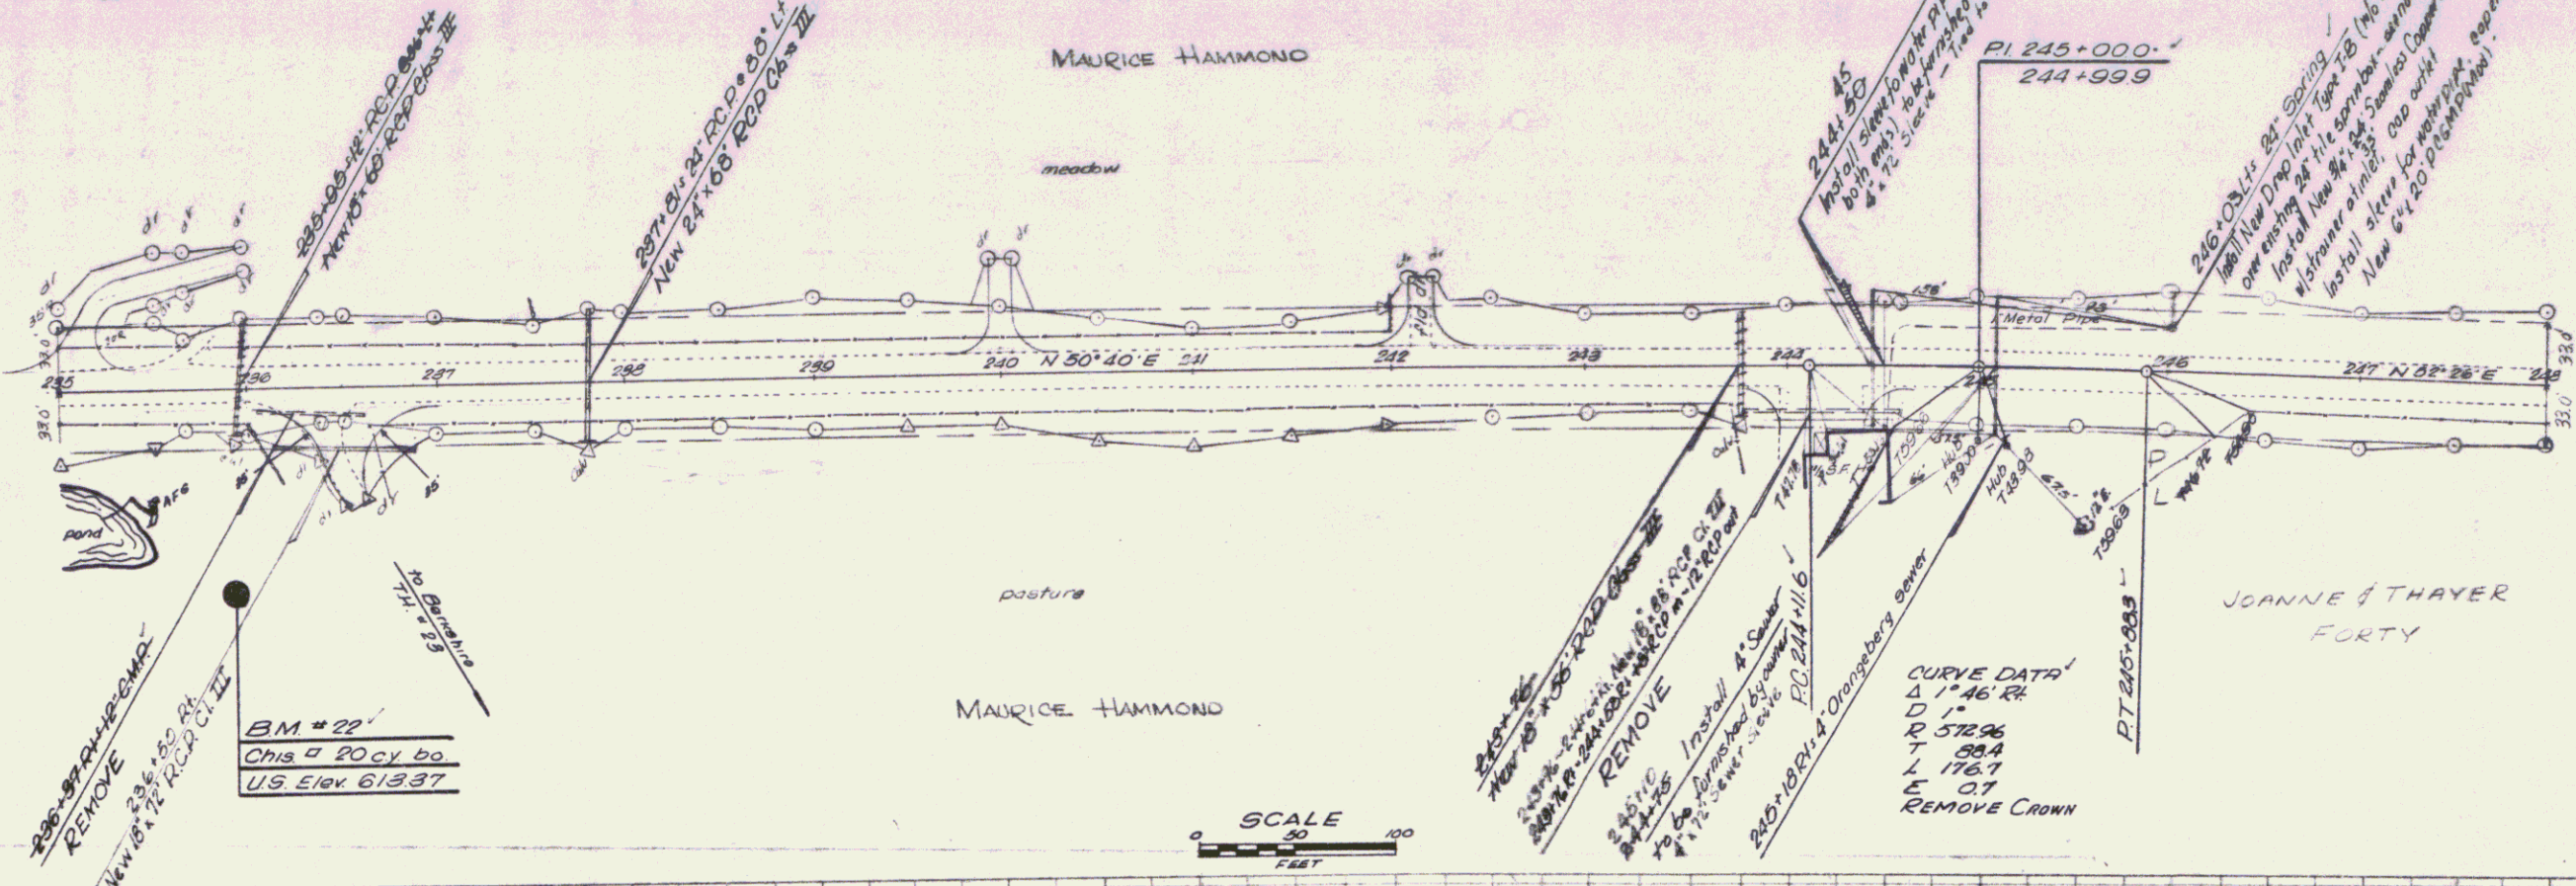

248
 FRANKLIN
 Proj. SA N° 5
 Sheet 16 of 82 sheets