


CONSTRUCT DRIVE  
 Lt  
 251+50.00  
 255+00  
 260+395


TWO CABLE GUARD RAIL  
 Lt  
 248+00-251+39  
 50'-252+00

CURVE DATA  
 Δ 1° 36' 11"  
 D 0° 30'  
 P 114592  
 T 1600  
 L 3200  
 E 1.1  
 REMOVE CROWN

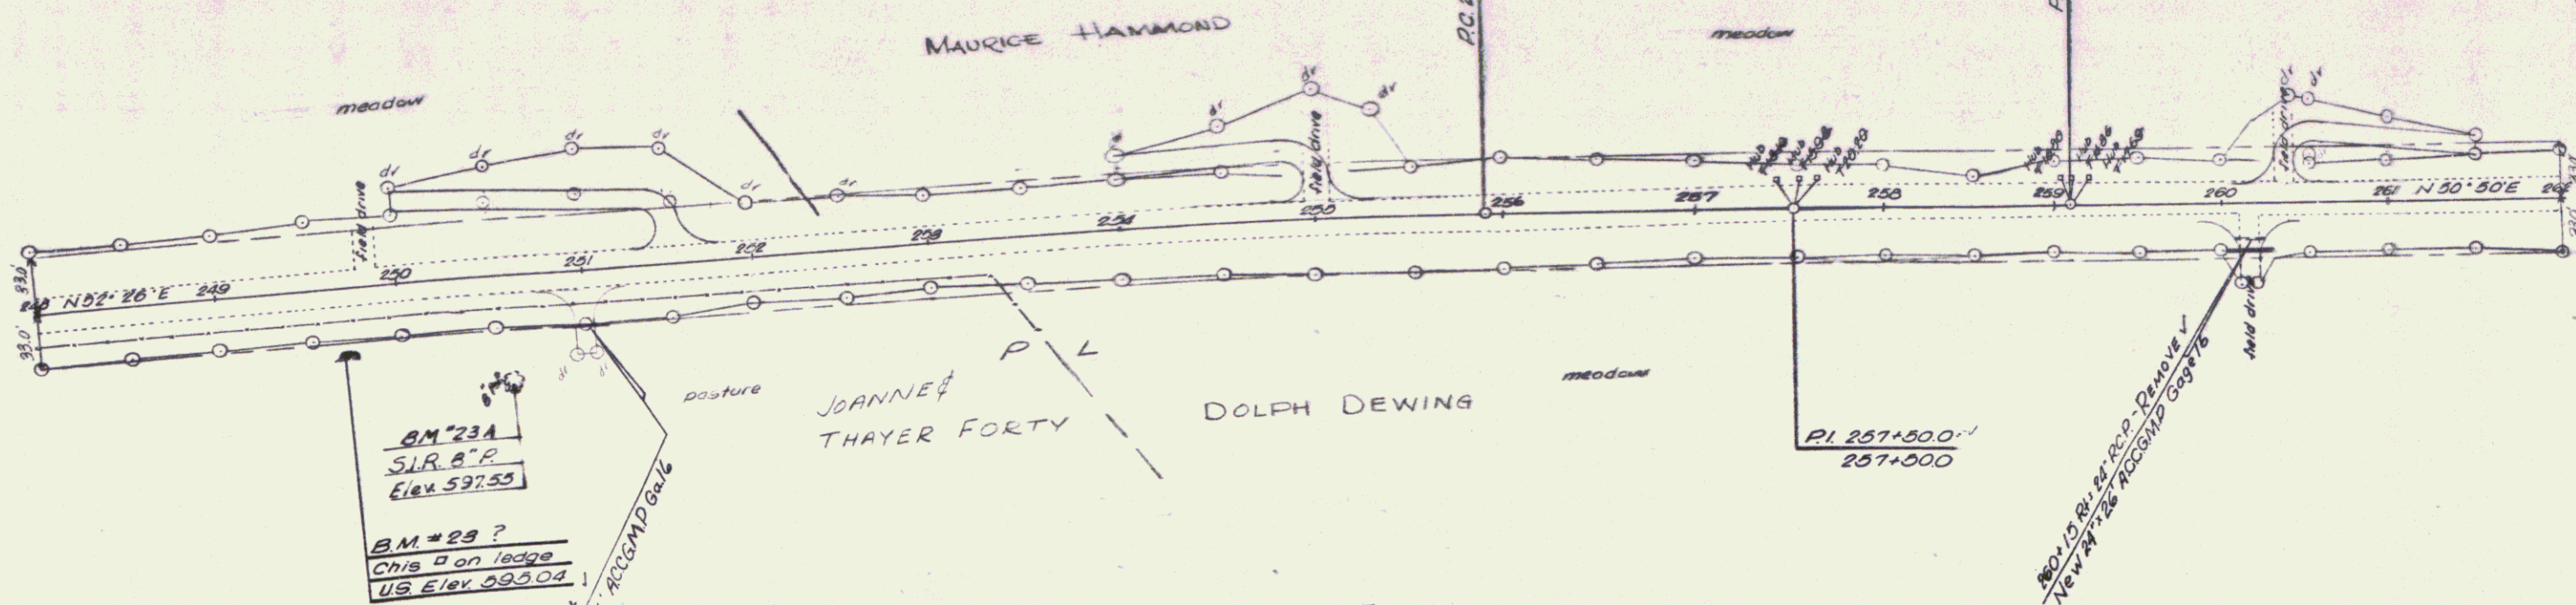

B.M. #23A  
 S.I.R. B.P.  
 Elev. 597.55  
 B.M. #29?  
 Chris on ledge  
 US Elev. 593.04

SCALE  
 0 50 100  
 FEET

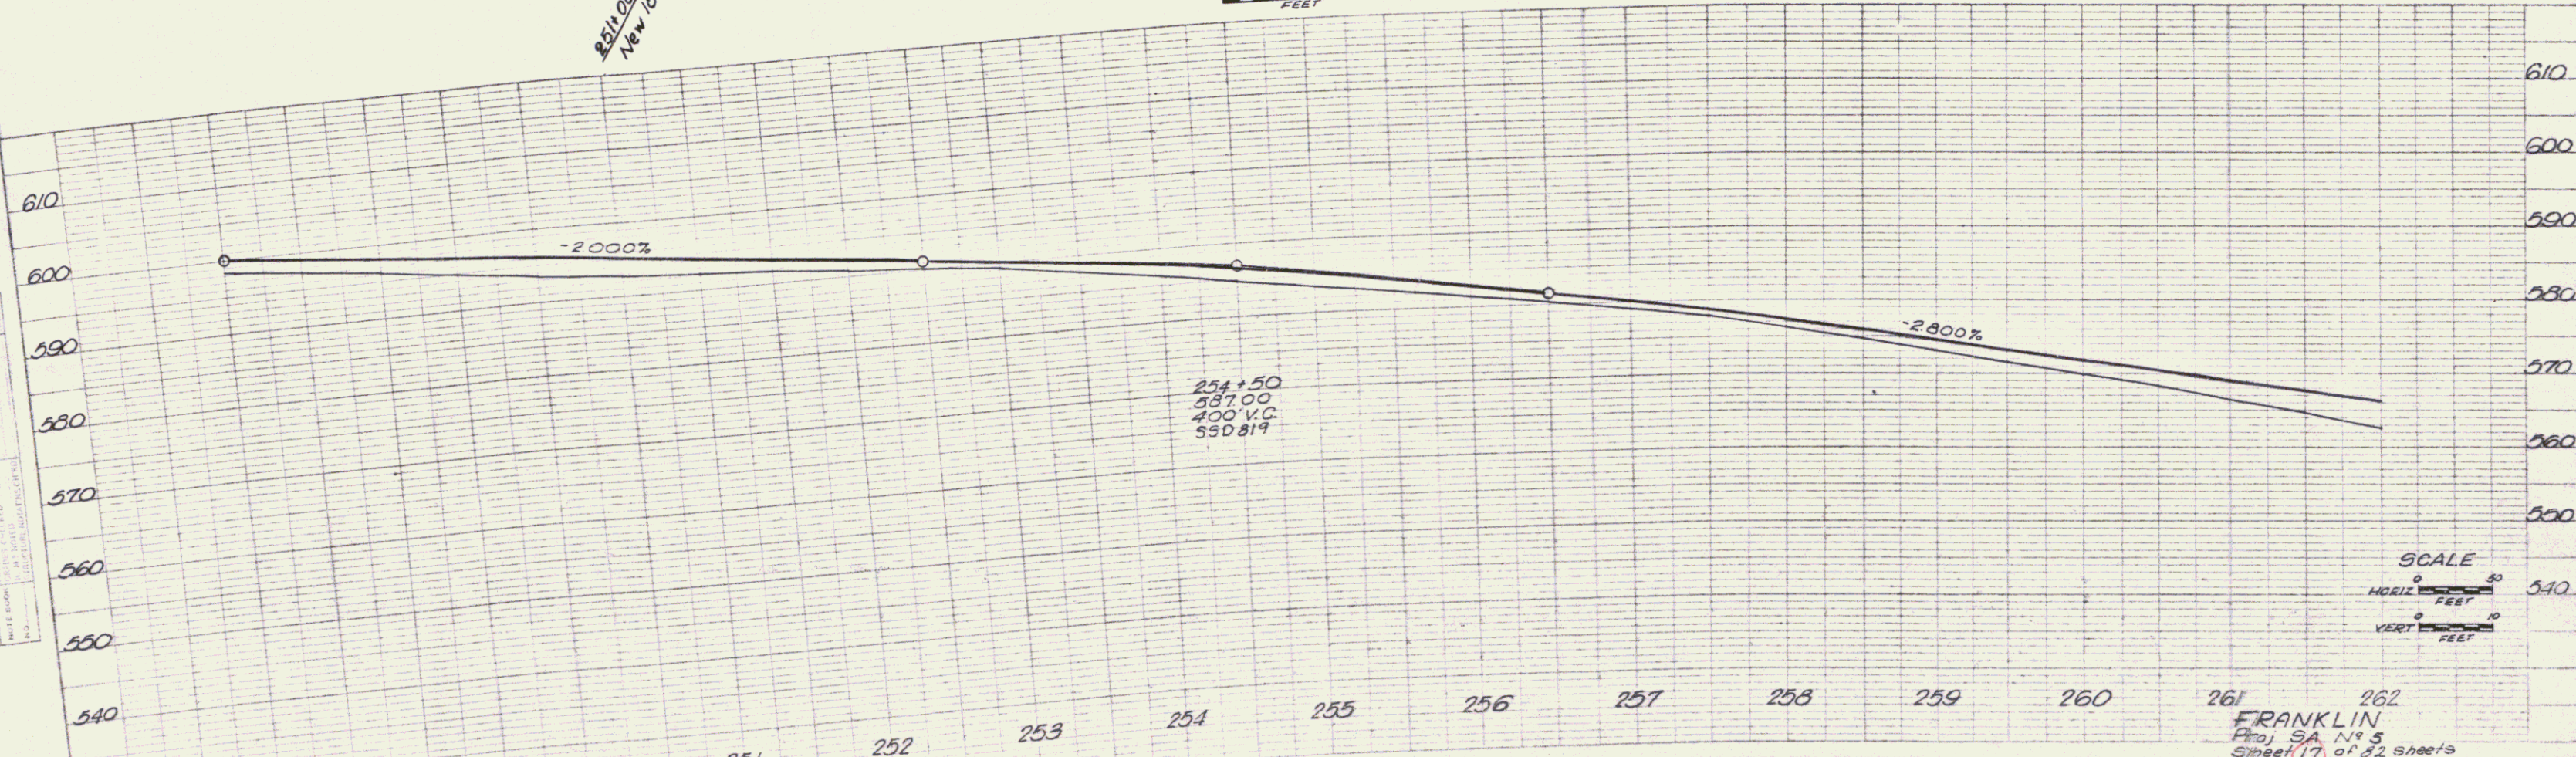

SCALE  
 0 50  
 HORIZ FEET  
 0 10  
 VERT FEET

FRANKLIN  
 Proj SA N° 5  
 Sheet 17 of 22 sheets