
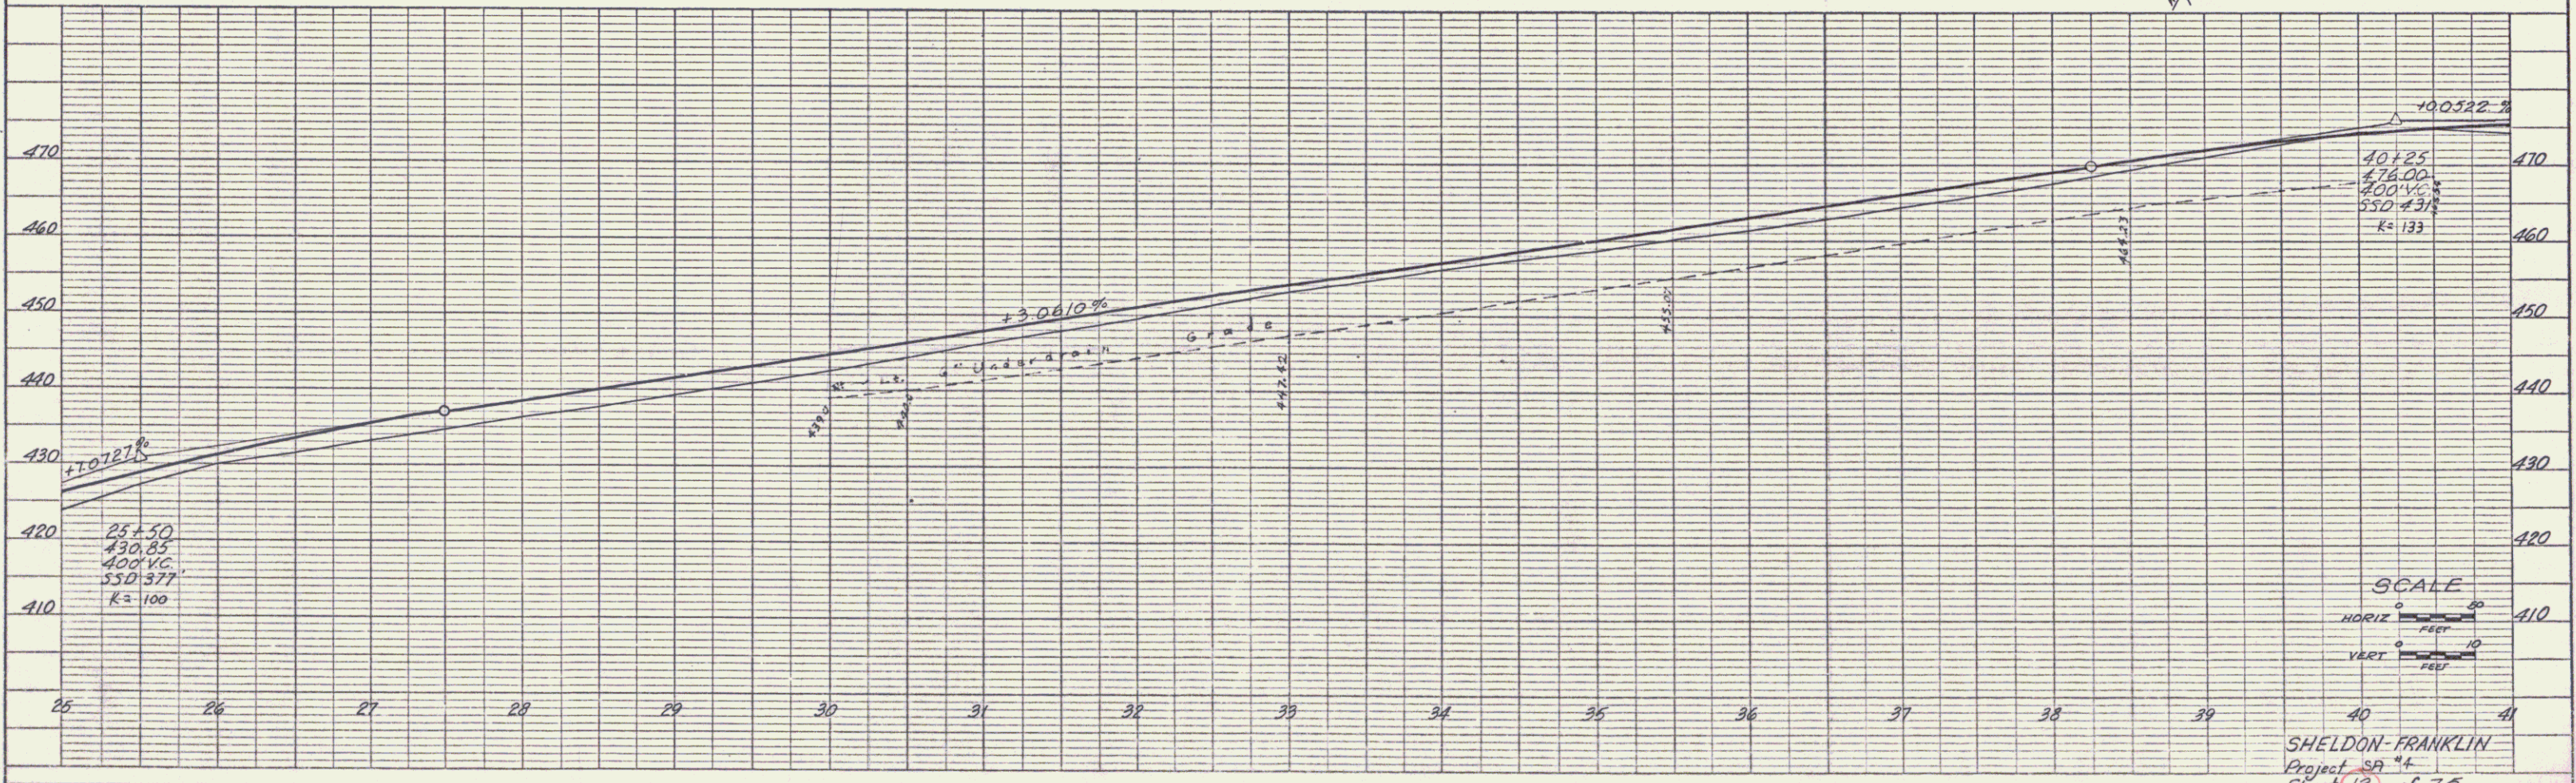


PLAN
 DRAWN BY: A. Gagnon
 CHECKED BY: A. Gagnon
 DATE: 11/15/11
 SHEET NO.: 12 of 15

PROFILE
 DRAWN BY: A. Gagnon
 CHECKED BY: A. Gagnon
 DATE: 11/15/11
 SHEET NO.: 12 of 15

CONSTRUCT DRIVE	
STATION	ELEVATION
39+10	401.383
40+00	401.050
40+10	331.95
40+20	251.00

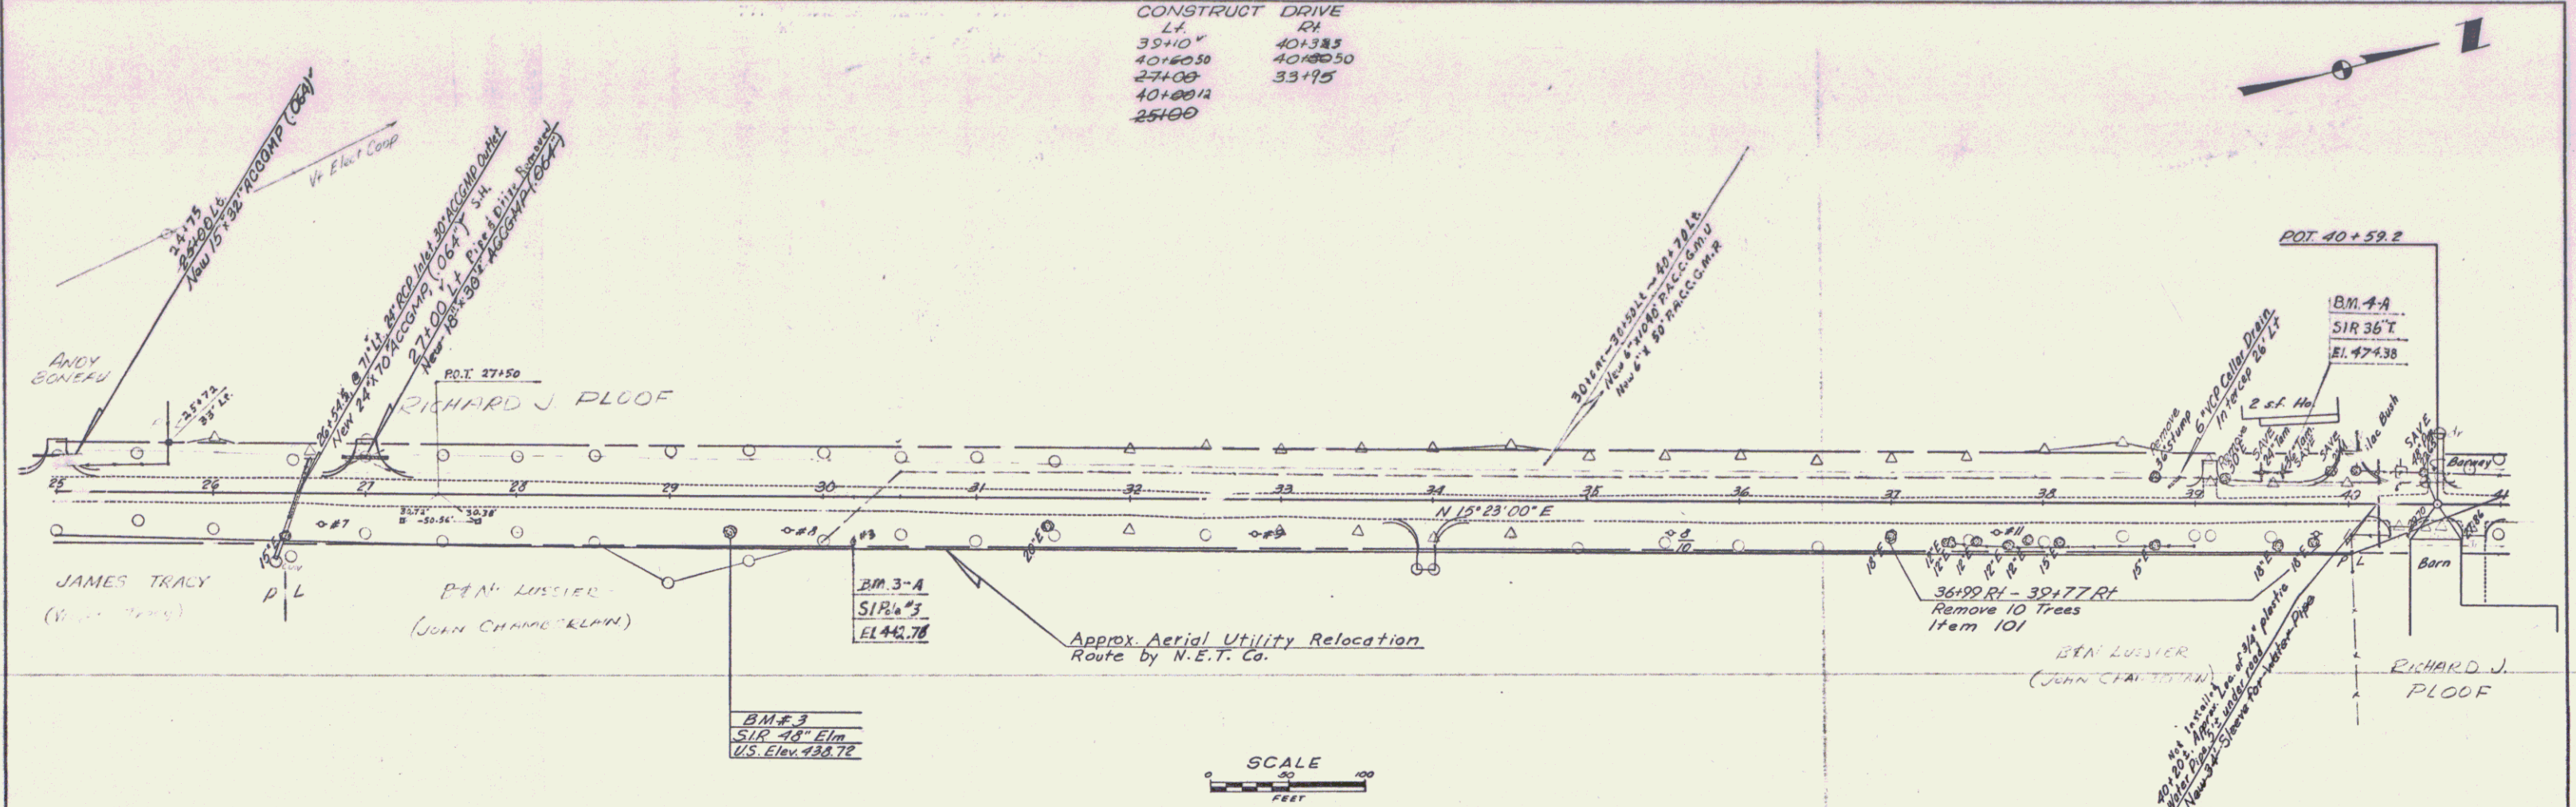

K&E PLATE 1, PLAN-PROFILE
 REYNOLDS & BAKER CO.
 487012 SUPERFLEX™ THERMOPLASTIC FILM

SHELDON-FRANKLIN
 Project: SR #4
 Sheet 12 of 15