

PLAN  
 CHECKED BY: A. Grogan  
 DATE: 11/11/11  
 DRAWN BY: A. Grogan  
 DATE: 11/11/11  
 PROJECT: 11/11/11  
 SHEET: 13 of 15

PROFILE  
 CHECKED BY: A. Grogan  
 DATE: 11/11/11  
 DRAWN BY: A. Grogan  
 DATE: 11/11/11  
 PROJECT: 11/11/11  
 SHEET: 13 of 15

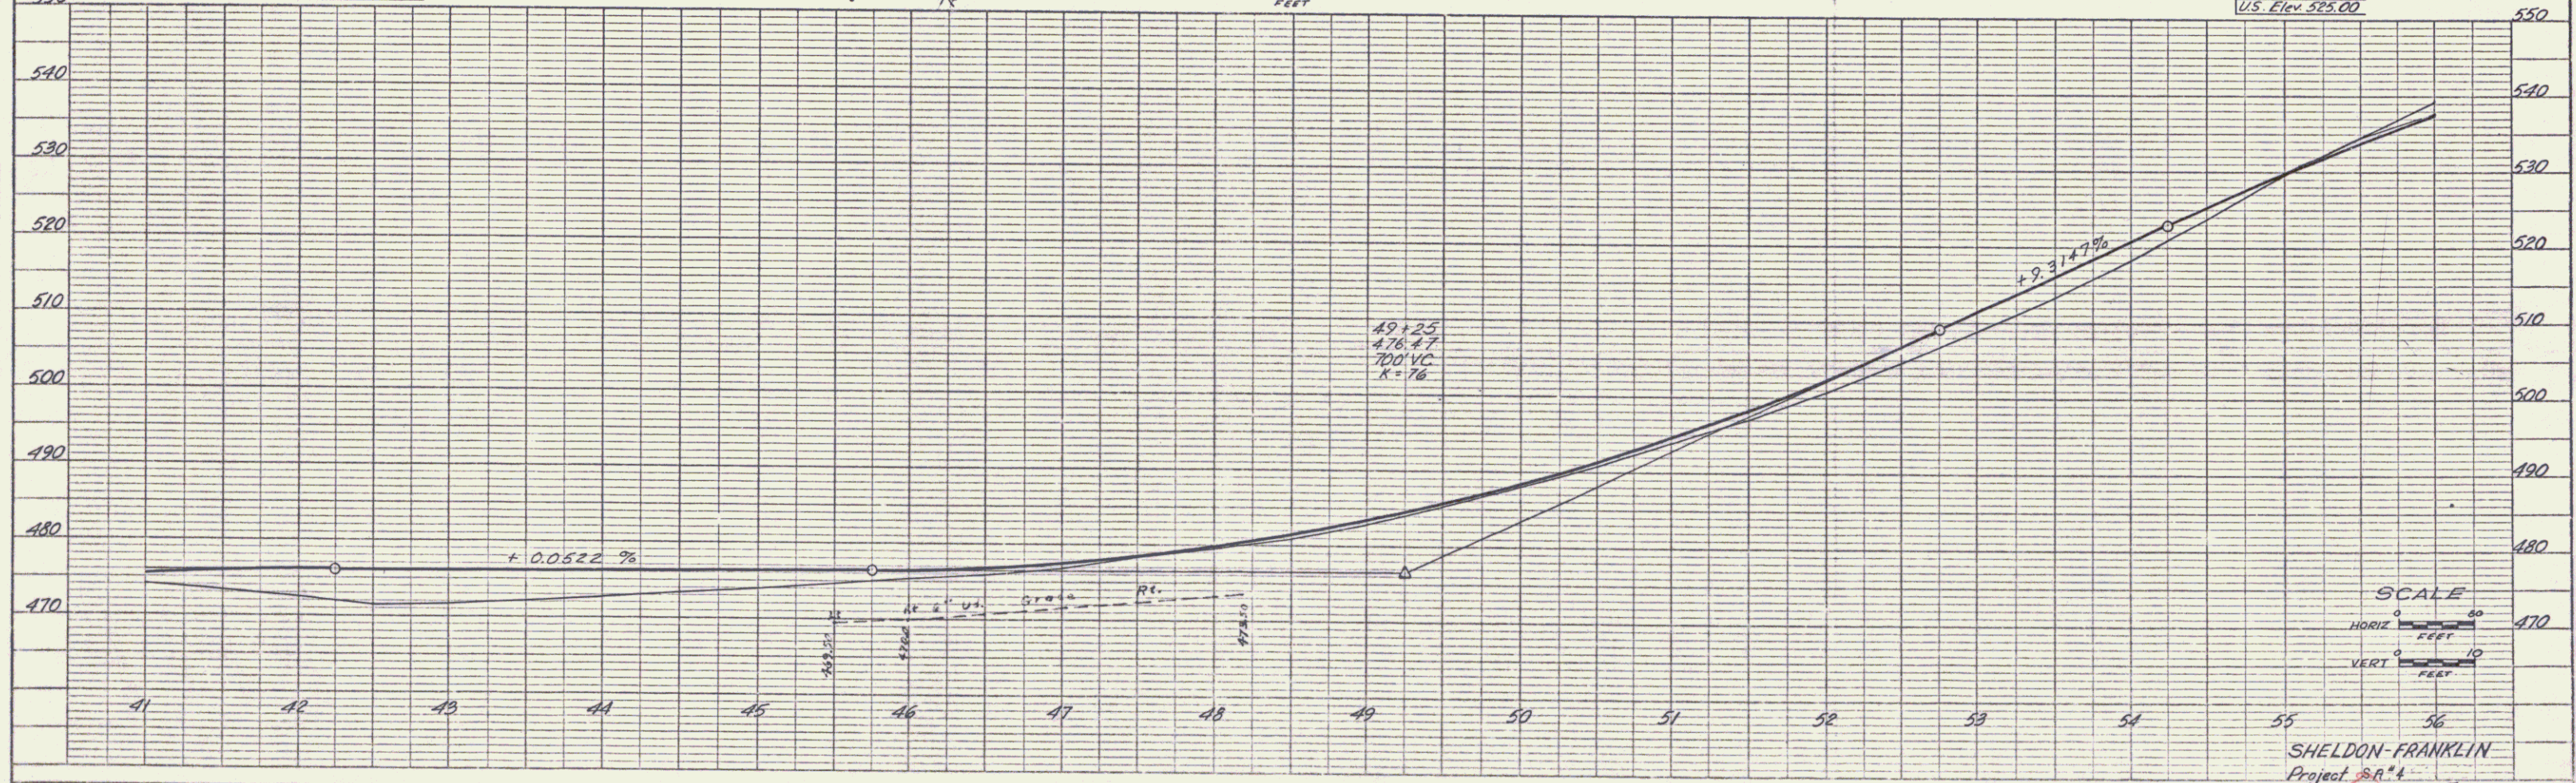
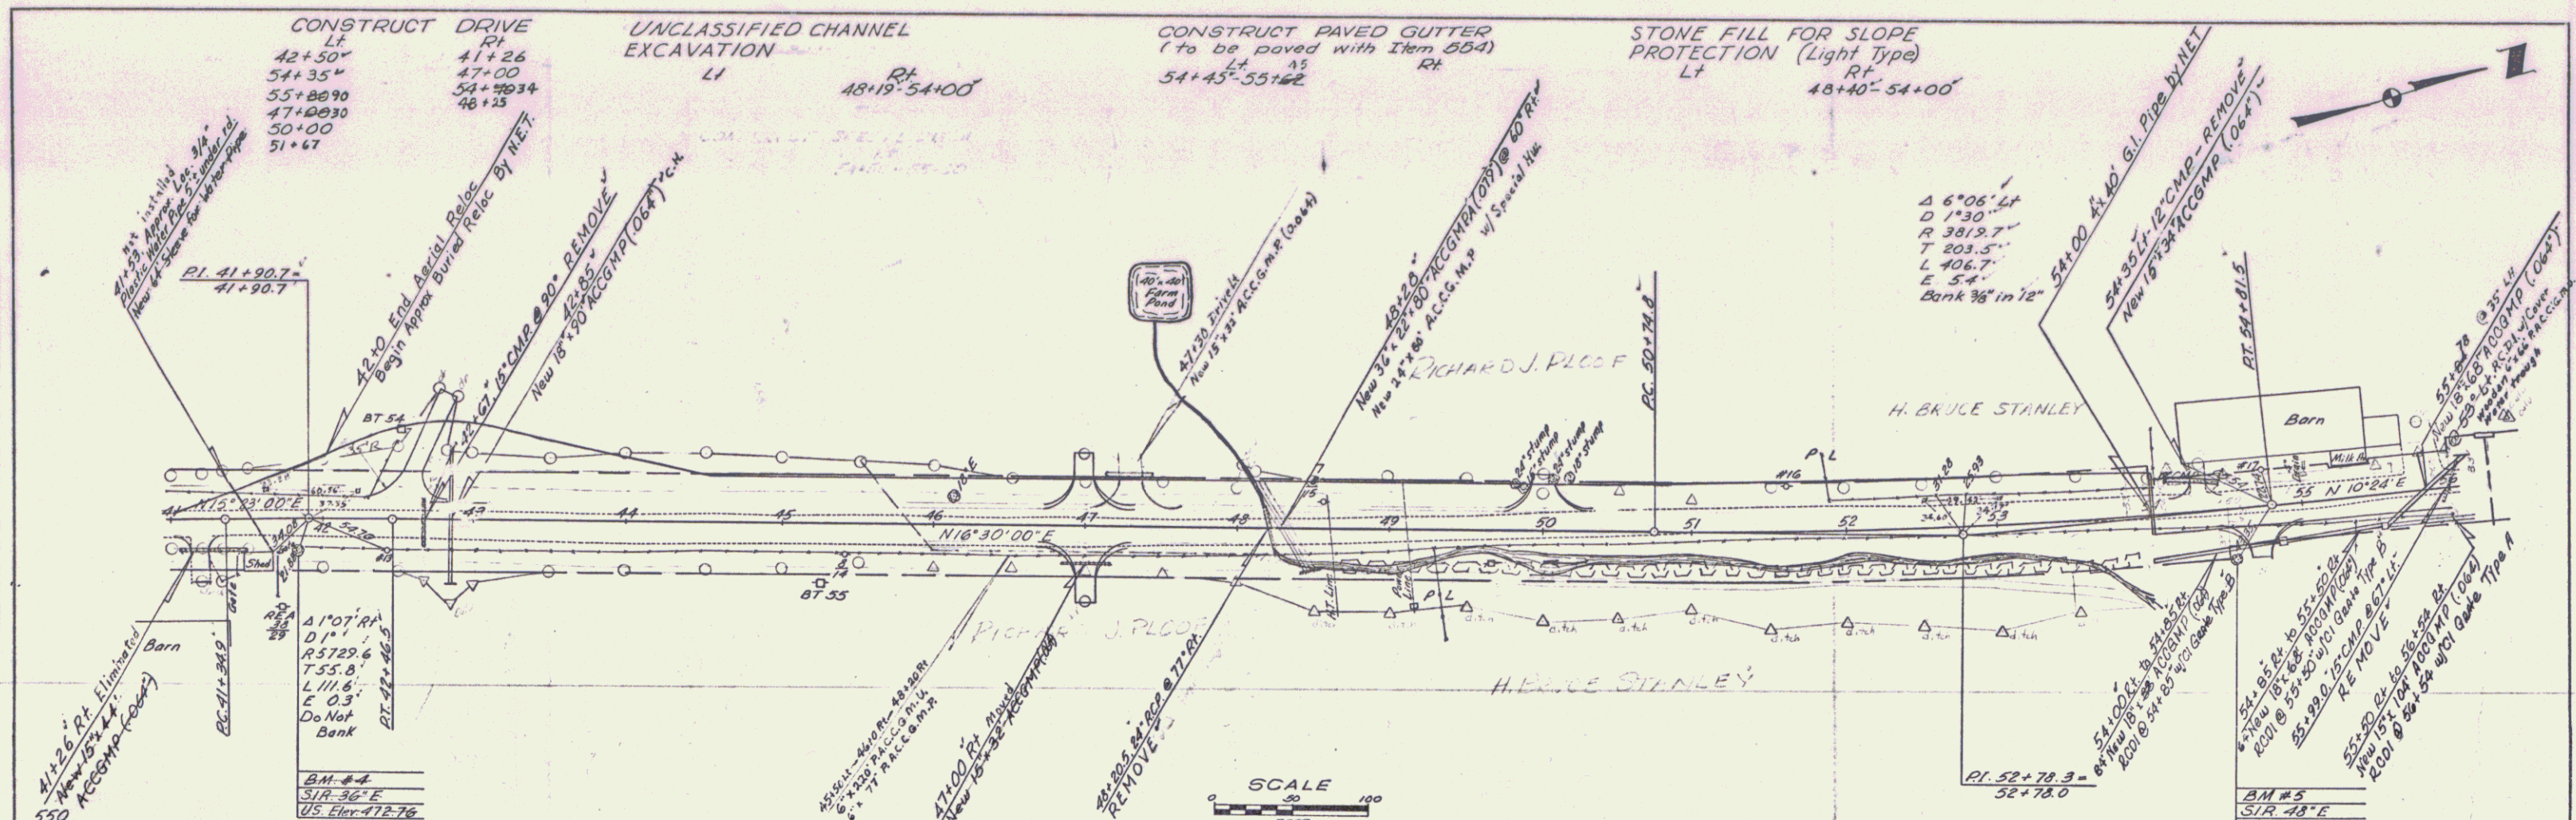


PLATE 1, PLAN-PROFILE  
 SHELDON-FRANKLIN  
 487012 IMPERIAL ENGINEERING, INC.

SHELDON-FRANKLIN  
 Project 11/11/11  
 Sheet 13 of 15