

PLAN
 SHELDON FRANKLIN
 PROJECT SR 14
 SHEET 14
 DATE 11/17/54
 DRAWN BY S. G. BAYNE
 CHECKED BY A. G. BAYNE

PROFILE
 SHELDON FRANKLIN
 PROJECT SR 14
 SHEET 14
 DATE 11/17/54
 DRAWN BY S. G. BAYNE
 CHECKED BY A. G. BAYNE

CONSTRUCT DRIVE
 LT
 61+20.10 57+40
 68+00.75 64+00.20
 70+02.75 70+70
 71+04.50 71+04.50
 67+50 68+10
 64+45

CONSTRUCT PAVED GUTTER
 69+40 ~ 70+00 Lt.

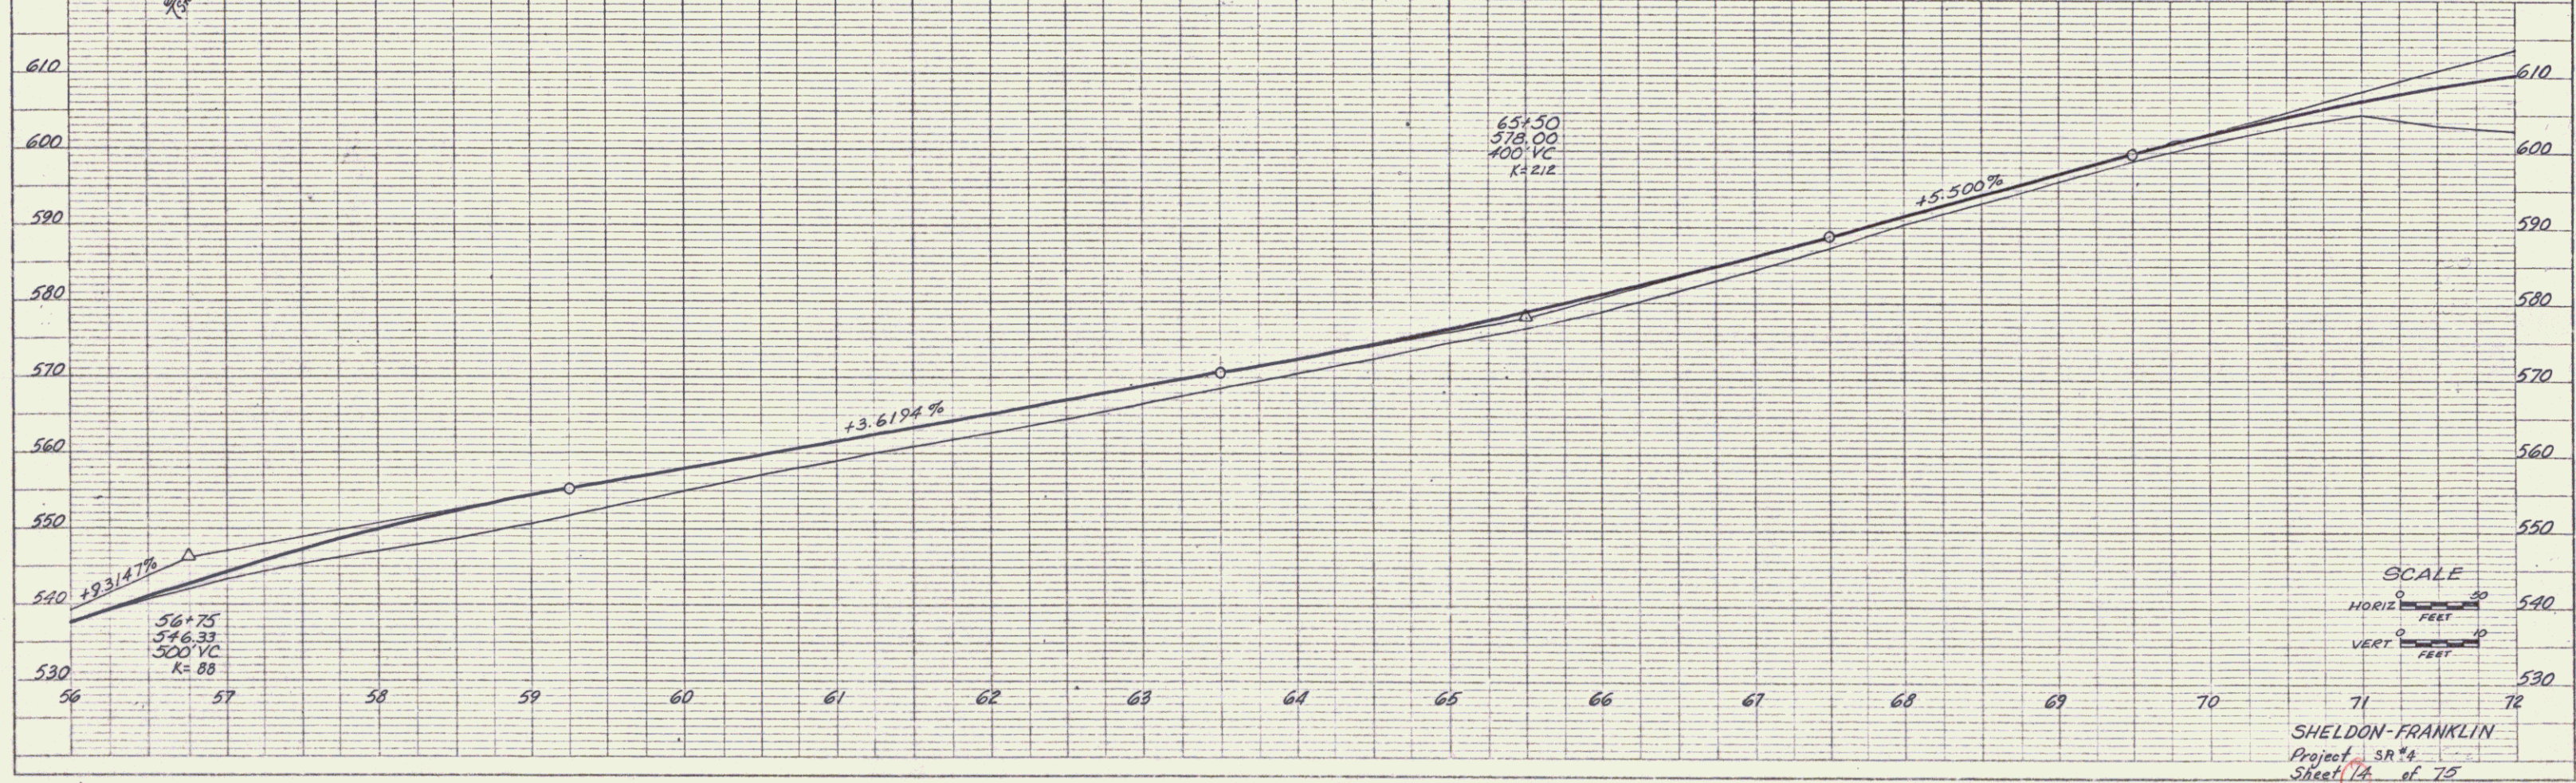
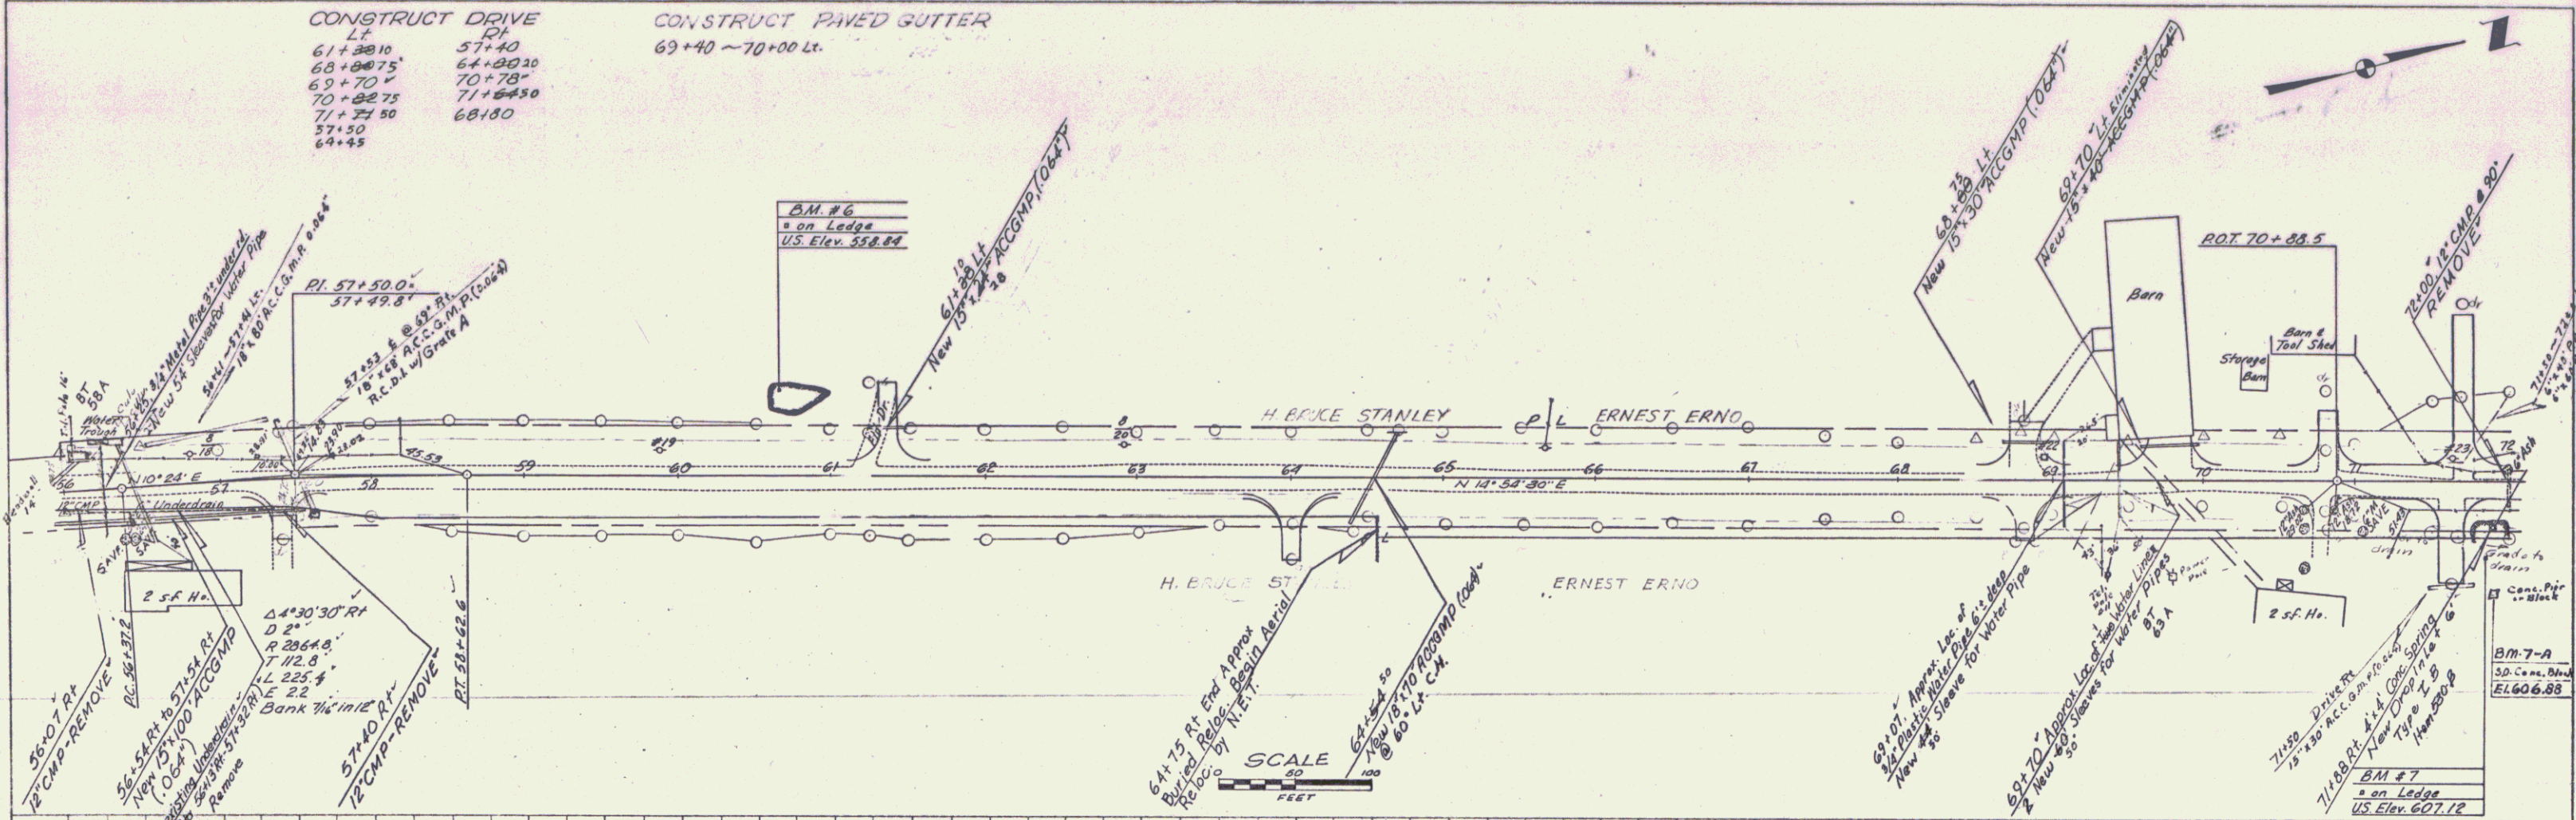


PLATE 1. PLAN-PROFILE
 SHELDON FRANKLIN
 PROJECT SR 14
 SHEET 14
 DATE 11/17/54
 DRAWN BY S. G. BAYNE
 CHECKED BY A. G. BAYNE

SHELDON-FRANKLIN
 Project SR 14
 Sheet 14 of 15

5