


PLAN
 DRAWN BY: A. C. Cogan
 CHECKED BY: A. C. Cogan
 DATE: 10/1/54

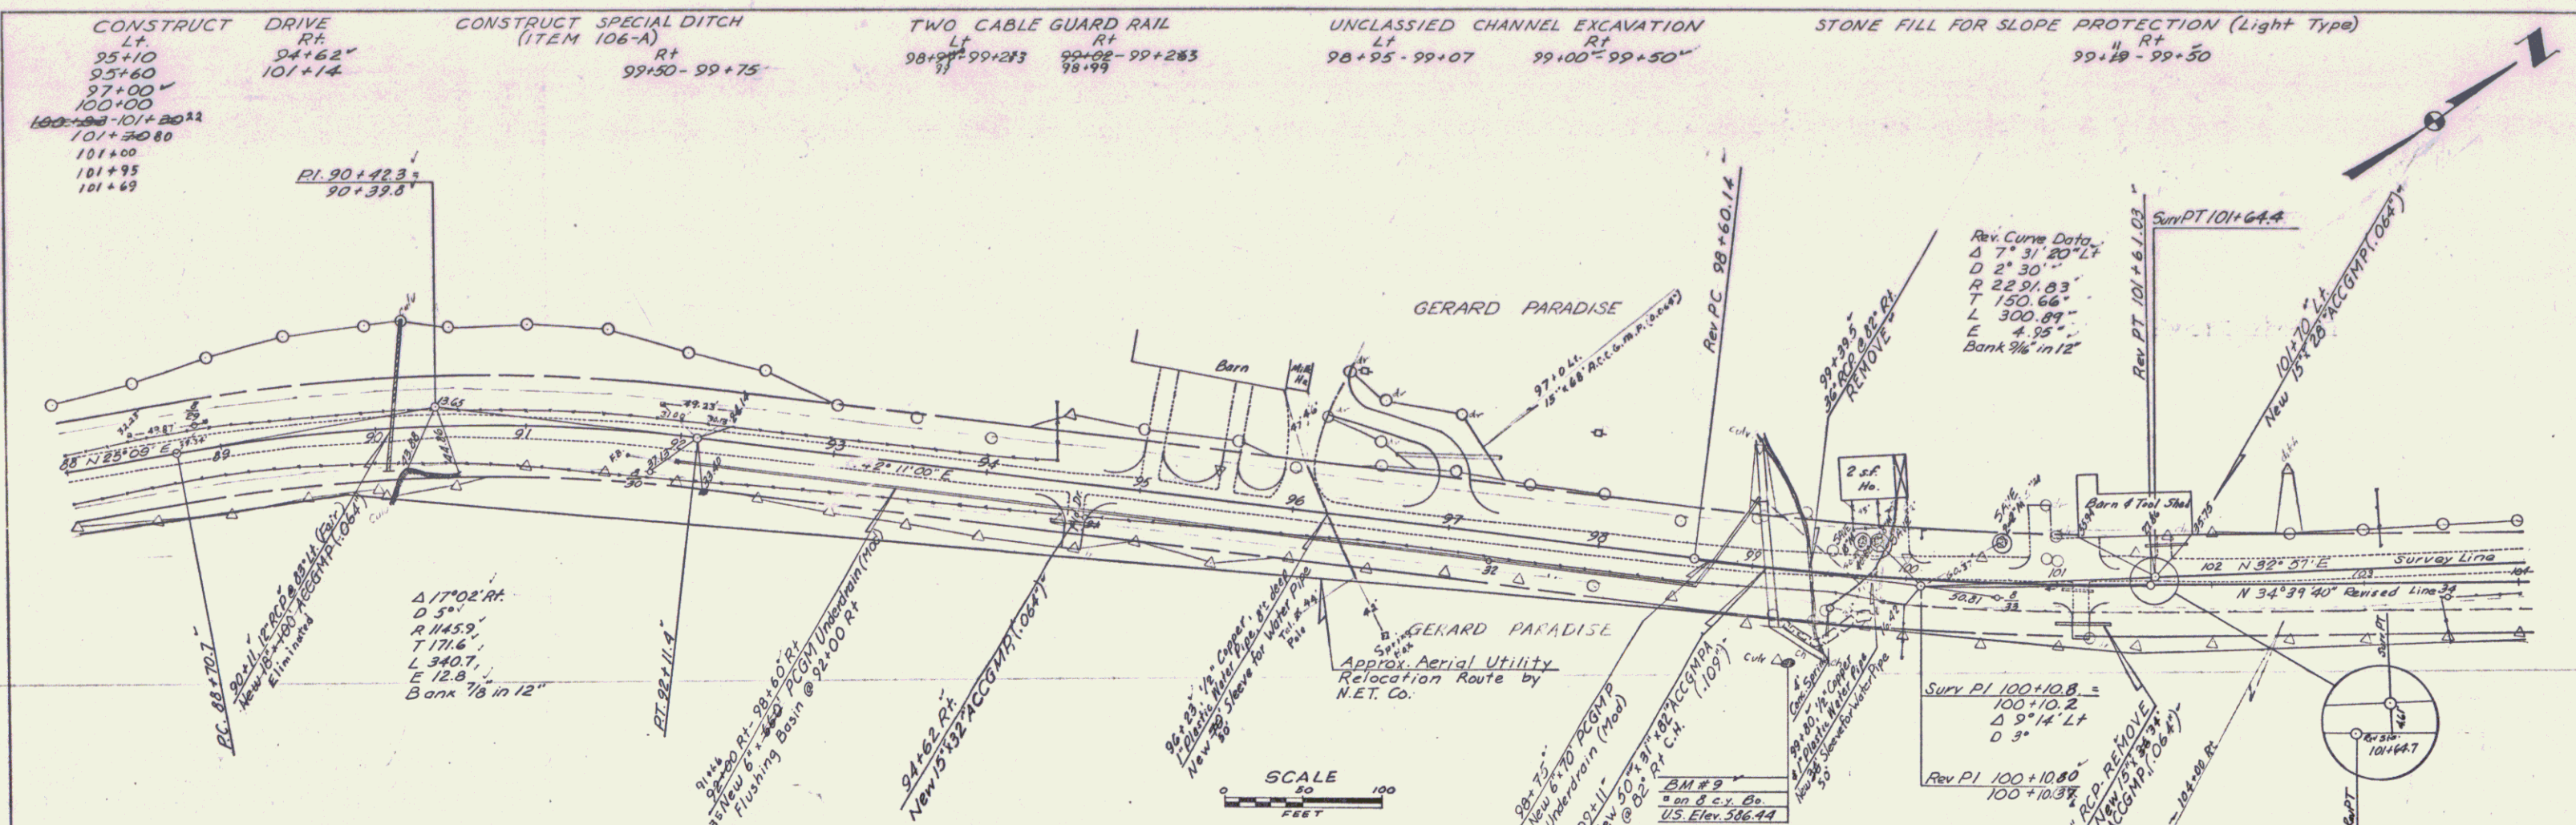

PROFILE
 DRAWN BY: S. J. Cogan
 CHECKED BY: S. J. Cogan
 DATE: 10/1/54

