
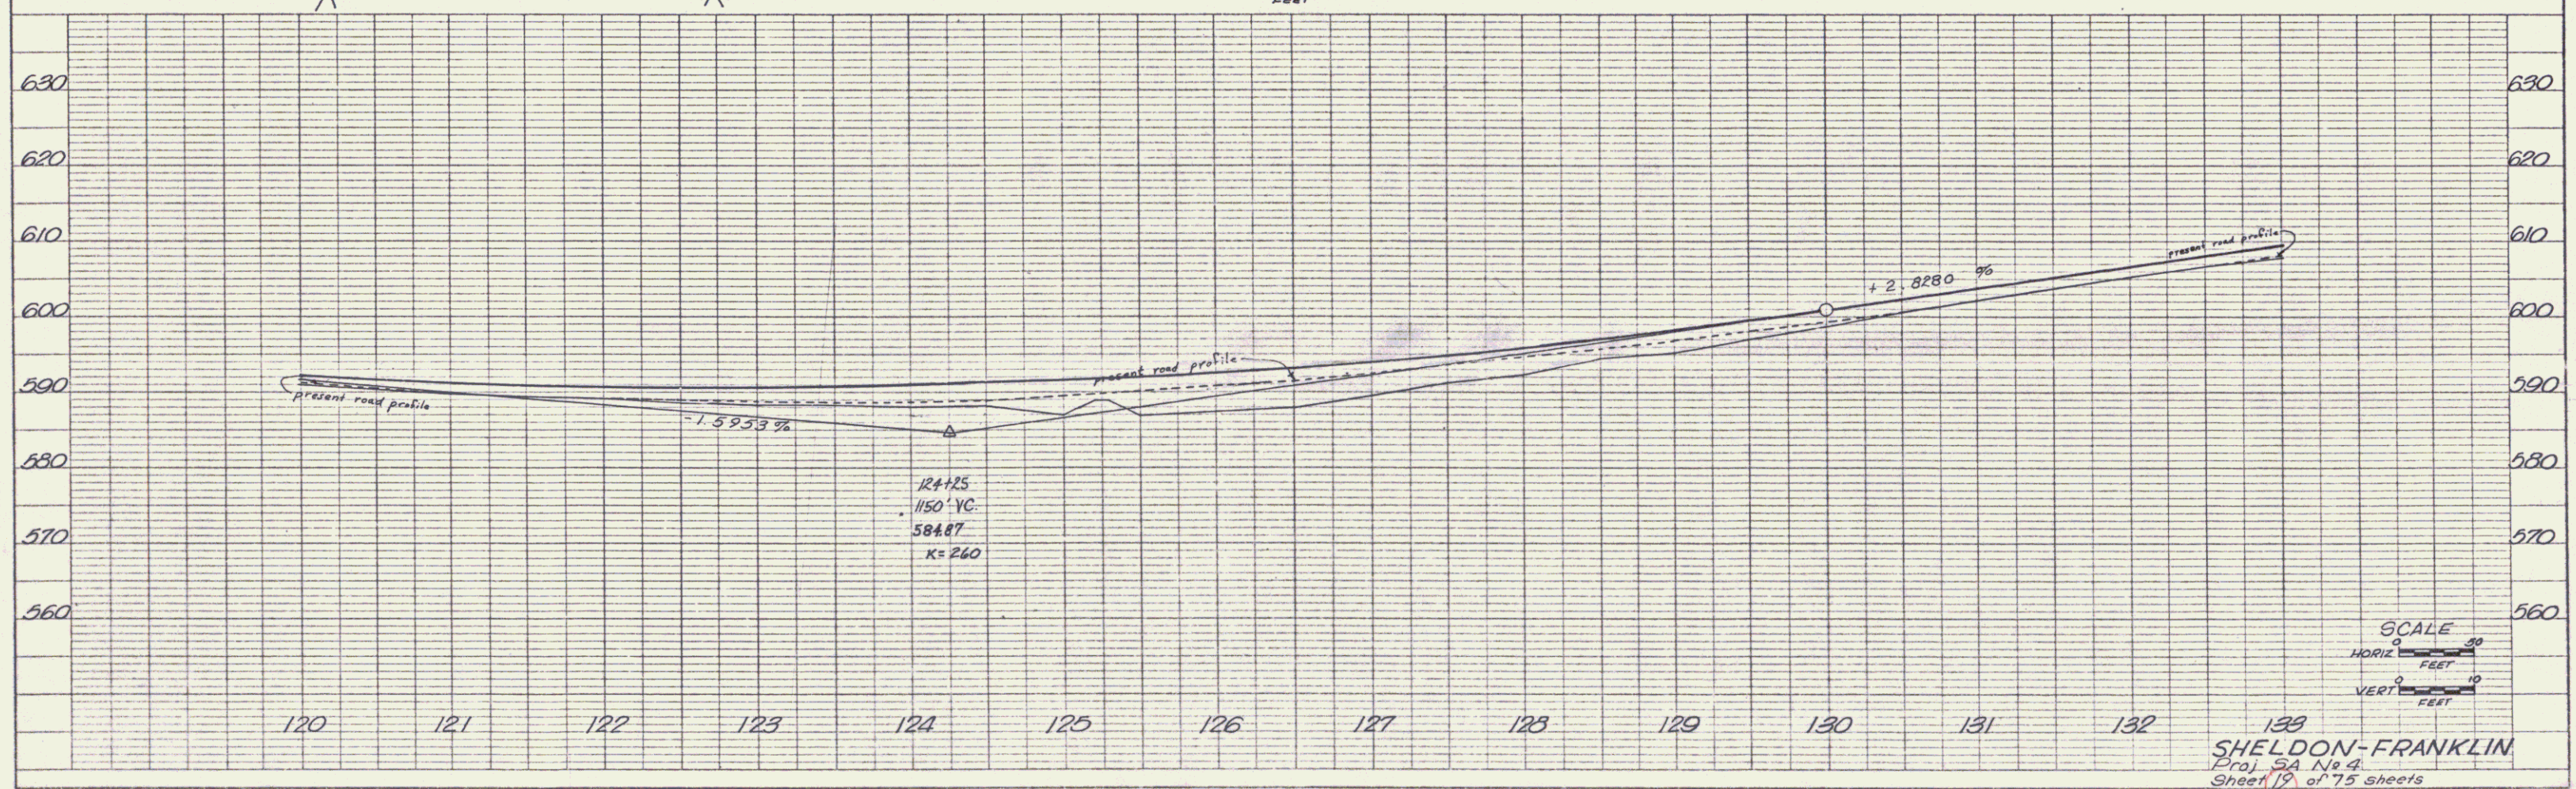


CONSTRUCT DRIVE TWO CABLE GUARD RAIL  
 LT RT LT RT  
 121+60.5 121+90.25 124+00-124+24 124+00-124+24

CURVE DATA  
 $\Delta$  38° 39' 07" LT 35'  
 D 1° 45'  
 R 3274.0'  
 T 1147.10'  
 L 2206.68'  
 E 196.18'  
 Bank 7/8" in 12"

BM #12  
 Chis # 5 cy. Ba.  
 U.S. Elev 589.68

PLAN  
 DESIGNED BY: SMITH, A.P.G.  
 CHECKED BY: WAL  
 DATE: 6-87  
 NO. 767

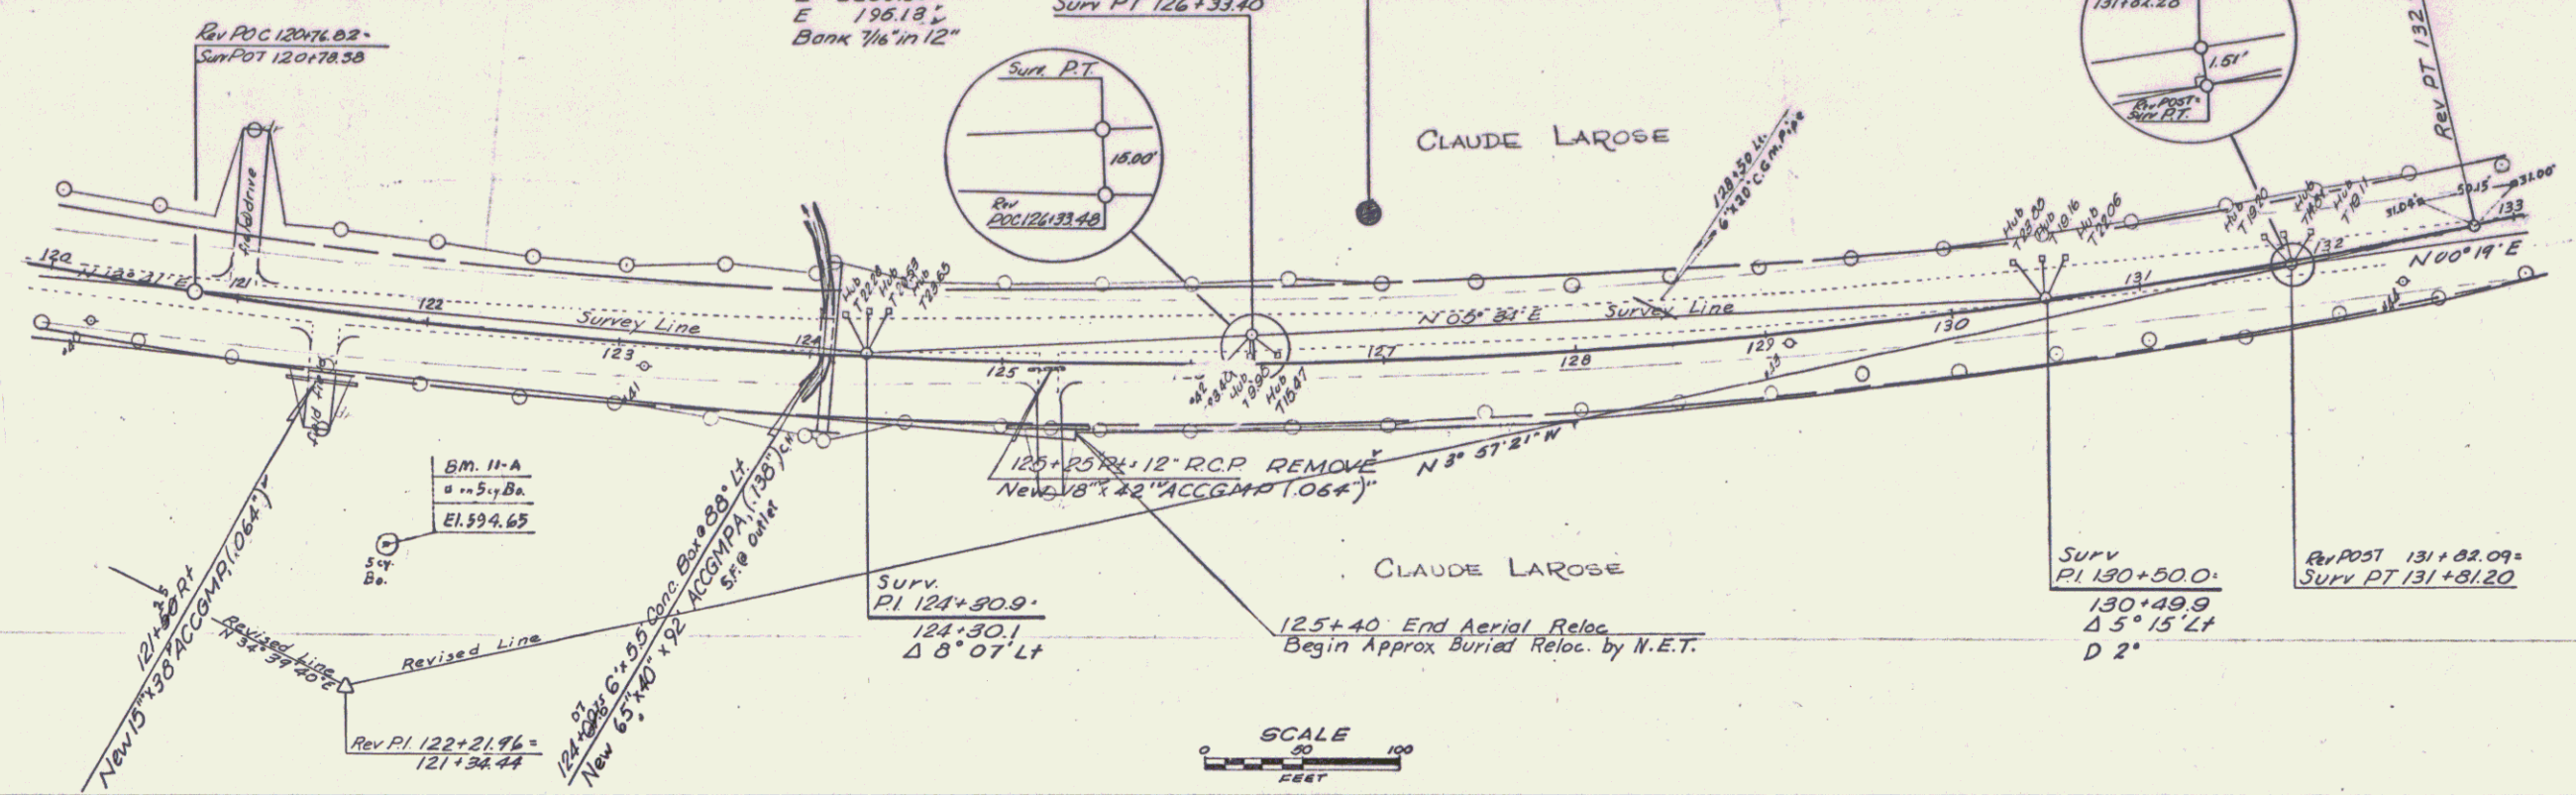

PROFILE  
 DESIGNED BY: SMITH, A.P.G.  
 CHECKED BY: WAL  
 DATE: 6-87  
 NO. 567

K-E PLATE 1, PLAN PROFILE  
 SHEET & BOOK 60

139  
 SHELDON-FRANKLIN  
 Proj. SA No. 4  
 Sheet 19 of 75 sheets