

INDEX OF SHEETS

SHEET NO	TITLE PAGE
1	TITLE PAGE
2	TYPICAL CROSS SECTION OF IMPROVEMENT DOUBLE TACK COAT OF REFINED TAR WITH PEA STONE SEAL ITEM SIZE
3	ROADWAY STANDARD SHEET RS 56-1 (BANKING)
4	ROADWAY STANDARD SHEET RS 56-12 (BARRICADES, SIGNS, LIGHTS) ROAD
5	QUANTITY SHEET (ITEMS)
6	QUANTITY SHEET (DRAINAGE)
7-9	EARTHWORK SHEETS
10-17	PLAN & PROFILE SHEETS
18	ROADWAY STANDARD SHEET RS 56-3 (MARKERS)
19	ROADWAY STANDARD SHEET RS 56-4 (DRAINAGE)
20	ROADWAY STANDARD SHEET RS 56-6 (TYPICAL GRADING)
21	ROADWAY STANDARD SHEET RS 56-10 (TWO-CABLE GUARD RAIL)
22	ROADWAY STANDARD SHEET RS 56-14 (DRAINAGE)

23-66 CROSS SECTIONS	PROJECT NAME & NUMBER	TYPE	AREA
	CANAAN DS 0271 (2)	DOUBLE TACK COAT REFINED TAR WITH PEA STONE SEAL	23,123 S.Y.

RECORD PLANS MATERIALS

GRAVEL SUBBASE: PAQUETTE PIT, CLARKSVILLE, N.H. SAND: BELMARE PIT, CANAAN, VT.  
 TAR: TRIMOUNT BIT. PRODUCTS, EVERETT, MASS. PEASTONE: LESSARDS, SORHAM, N.H.  
 ACCOMP: NEW ENGLAND METAL CULVERT CO., W. RIVER, VT. & 6" PACCM UNDERDRAIN  
 RCP & PRCP: CONCRETE PIPE CO., WINDSOR, VT. CEMENT: DRAGON, CROFTON, N.H.  
 GUARD RAIL CABLE & FITTINGS: AMERICA WIRE ROPE, NEW HAVEN, CONN.  
 WOODEN POST: NEW ENG. POLE, MERRIMACK, N.H. VIT. CLAY PIPE: POUTRE, BEECHER FALLS, VT.  
 CONTRACTOR: MAURICE C. BUCK, COLEBROOK, N.H. CONTRACT: JUNE 12, 1958  
 RESIDENT ENGINEER: LESLIE L. MOONEY STARTED: JULY 7, 1958  
 INSPECTORS: H. W. WASHNER, G. REED COMPLETED: JULY 30, 1959  
 RECORD PLAN: MOONEY, WASH. BURN. ACCEPTED: JULY 30, 1959



STATE OF VERMONT  
DEPARTMENT OF HIGHWAYS

PROPOSED IMPROVEMENT  
FEDERAL AID  
SECONDARY PROJECT

TOWN OF CANAAN  
COUNTY OF ESSEX  
VERMONT ROUTE 253  
CANAAN BEECHER FALLS ROAD

BEGINNING AT THE INTERSECTION OF VT ROUTE 114 AND VT ROUTE 27 AND EXTENDING EASTERLY 11,384.5 FT. TO THE INTERNATIONAL BORDER  
LENGTH OF PROJECT = 11,384.5 FT. = 2.156 MILES

FED. ROAD DISTRICT	STATE	PROJECT NO.	YEAR	SHEET NO.	TOTAL SHEETS
1	VT	05 0271(2)	1958	1	64

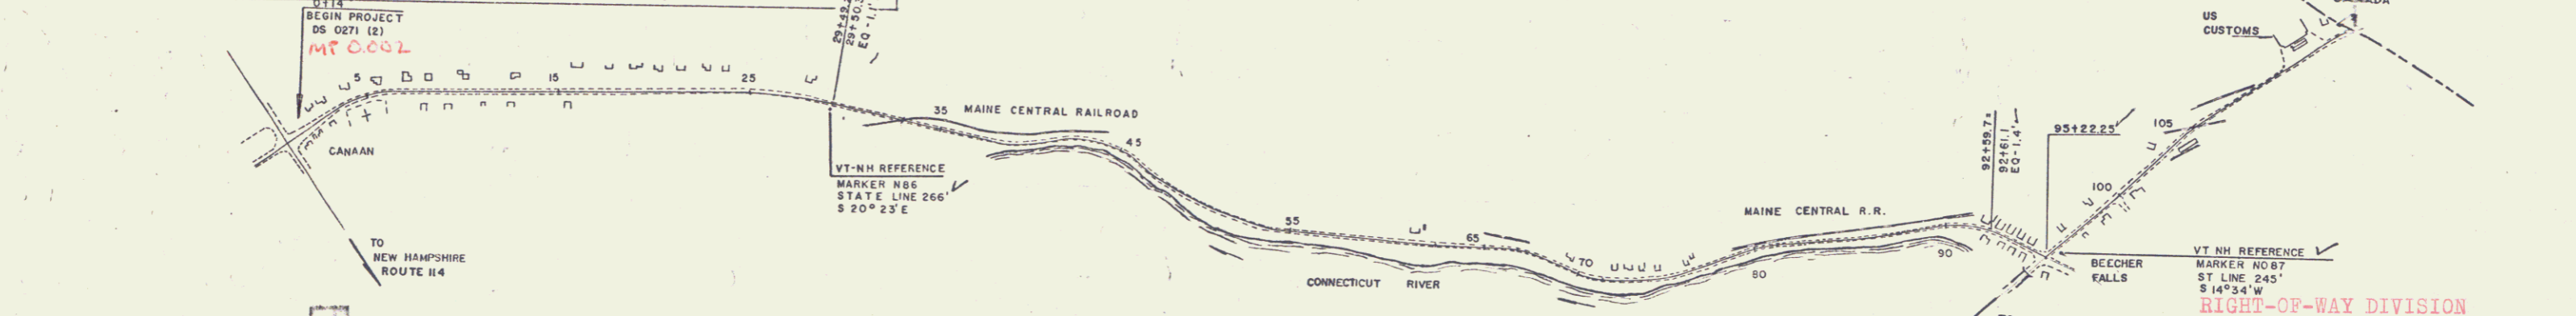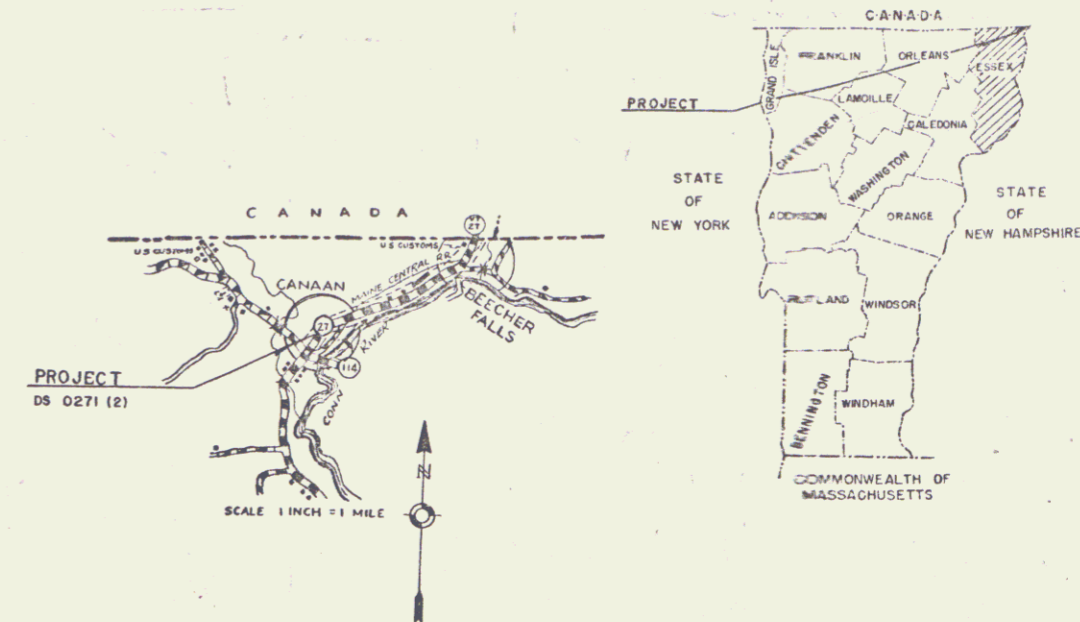

ITEM	QUANTITY	UNIT
GRAVEL SUBBASE	...	...
TAR	...	...
PEASTONE	...	...
...	...	...

ITEM	DATE	LINE
GROUND ELEVATION	DATUM	TEST LINE
GRADE ELEVATION	DATUM	TEST LINE

ITEM	DATE	LINE
...	...	...

ITEM	DATE	LINE
...	...	...

MP 2.156  
END PROJECT DS 0271(2)

RIGHT-OF-WAY DIVISION  
TOWN FILE  
PERPETUAL  
Town of VT 253  
(To Be Returned To R.O.W. Division)

NOTE: ANY FURTHER INFORMATION CONCERNING FINAL QUANTITIES, AMOUNTS OF OTHER DETAILS RELATIVE TO THIS PROJECT MAY BE FOUND IN EITHER THE P.E.D. BOOKS OR THE ESTIMATE FILE.

DEPARTMENT OF COMMERCE  
BUREAU OF PUBLIC ROADS  
APPROVED Pin # 992673

THESE PLANS ARE SUBJECT TO SUCH REVISIONS AS MAY BE REQUIRED BY THE BUREAU OF PUBLIC ROADS OR THE COMMISSIONER OF HIGHWAYS.  
CONSTRUCTION IS TO BE CARRIED ON IN ACCORDANCE WITH THE PLANS AND THE STANDARD SPECIFICATIONS FOR HIGHWAY AND BRIDGE CONSTRUCTION OF JANUARY 1956 SUBMITTED TO THE BUREAU OF PUBLIC ROADS AS APPROVED JANUARY 5, 1956, INCLUDING ALL SUBSEQUENT APPROVED REVISIONS AND SUCH REVISED SPECIFICATIONS AND SPECIAL PROVISIONS AS ARE SUBMITTED WITH THE PLANS.

APPROVED	APPROVED	APPROVED	APPROVED	APPROVED	PROJECT DS	NO.	SHEET
<i>[Signature]</i> CONSTRUCTION ENGINEER	<i>[Signature]</i> SECONDARY ENGINEER	<i>[Signature]</i> DISTRICT ENGINEER	<i>[Signature]</i> HIGHWAY ENGINEER	<i>[Signature]</i> CHIEF ENGINEER	05	0271(2)	1
DATE <u>May 22, 1958</u>	DATE <u>May 23, 1958</u>	DATE <u>May 22, 1958</u>	DATE <u>May 22, 1958</u>	DATE <u>June 2, 1958</u>	SHEET (1) OF 65 SHEETS		

253  
 VT  
 2/27/00