


TOWN OF CANAAN WATER SYSTEM
HOUSE CONNECTION - APPROX. LOCATIONS
TIRNILL 15+50 L9
NELSON 15+95 L9
AMES 17+37 L10
PARISEAU 18+72 L10
POUTRE 19+33 L11
KERSHNER 21+25 L13
HOLMES DEVELOPMENT 21+83 L14
(G.TE) 24+10 L21

RECORDING DATA

PARCEL	GRANTOR	TOWN BOOK	PAGE	DATE
10C	GEORGE CLAYTON & CLARICE S. TIRNILL	CANAAN	T 35-D	8-22-59
19	ARTHUR H. & CATHERINE I. NELSON	"	S 152	8-28-58
20	MARSHALL A. & VELMA C. AMES	"	S 148	8-28-58
21	GERMAIN & ANNETTE PARISEAU	"	S 157	9-7-58
22	GERARD & CARMEN POUTRE	"	S 147	8-28-58
23	BENJAMIN E. & THELMA M. KERSHNER	"	S 151	8-25-58
24	RUSSELL G. & EVELYN H. HOLMES	"	S 142	8-22-58
36A	BEECHER FALLS MANUFACTURING CORP.	T	1-C	2-19-59
27	CHARLES H. & VATTIE RICE	"	S 158	9-10-58
26	LYMAN & KATHERINE D. GIDWAN	"	S 149	8-27-58
28 AB	WALDO A. & LEOTTA PRIGE	T	4-C	3-31-59

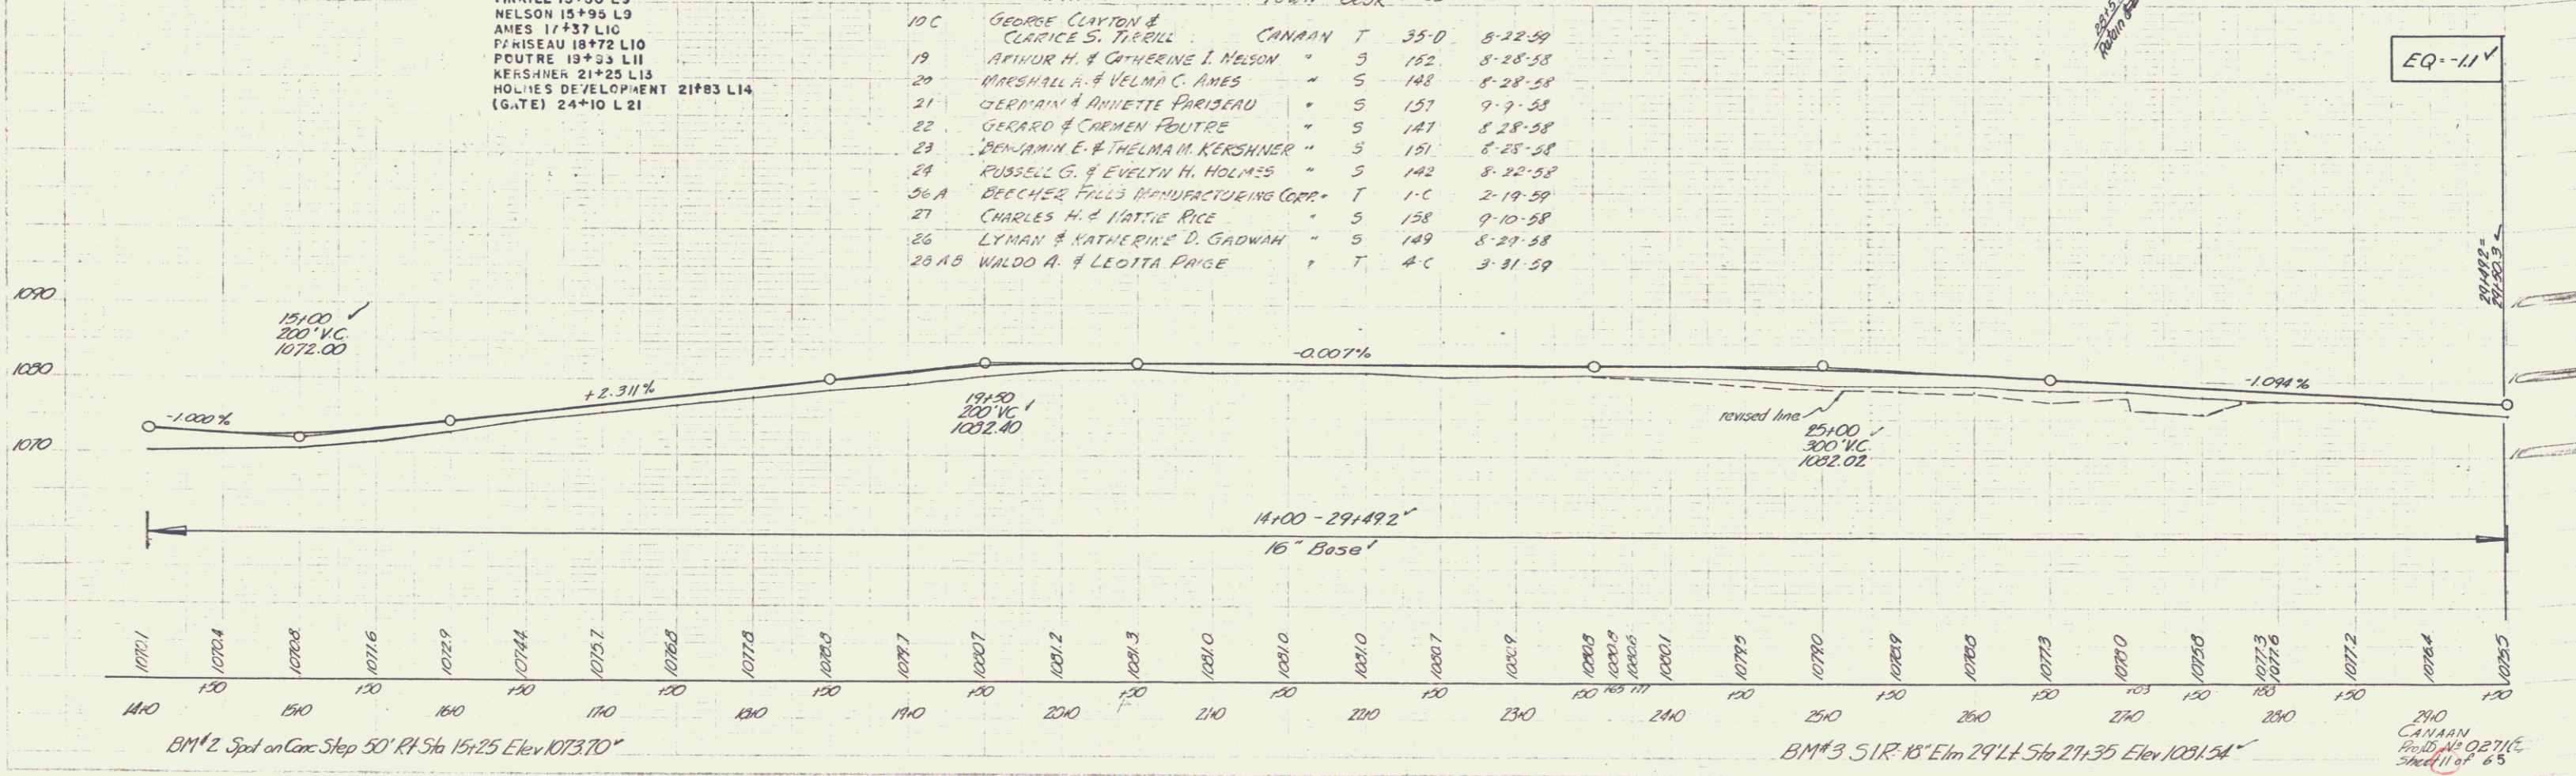

BM#2 Spd on Conc Step 50' RI Sta 15+25 Elev 1073.70'

BM#3 51R 18' Elm 29' Lt Sta 27+35 Elev 1081.54'

210 CANAAN ROAD NO. 027116 sheet 11 of 65