
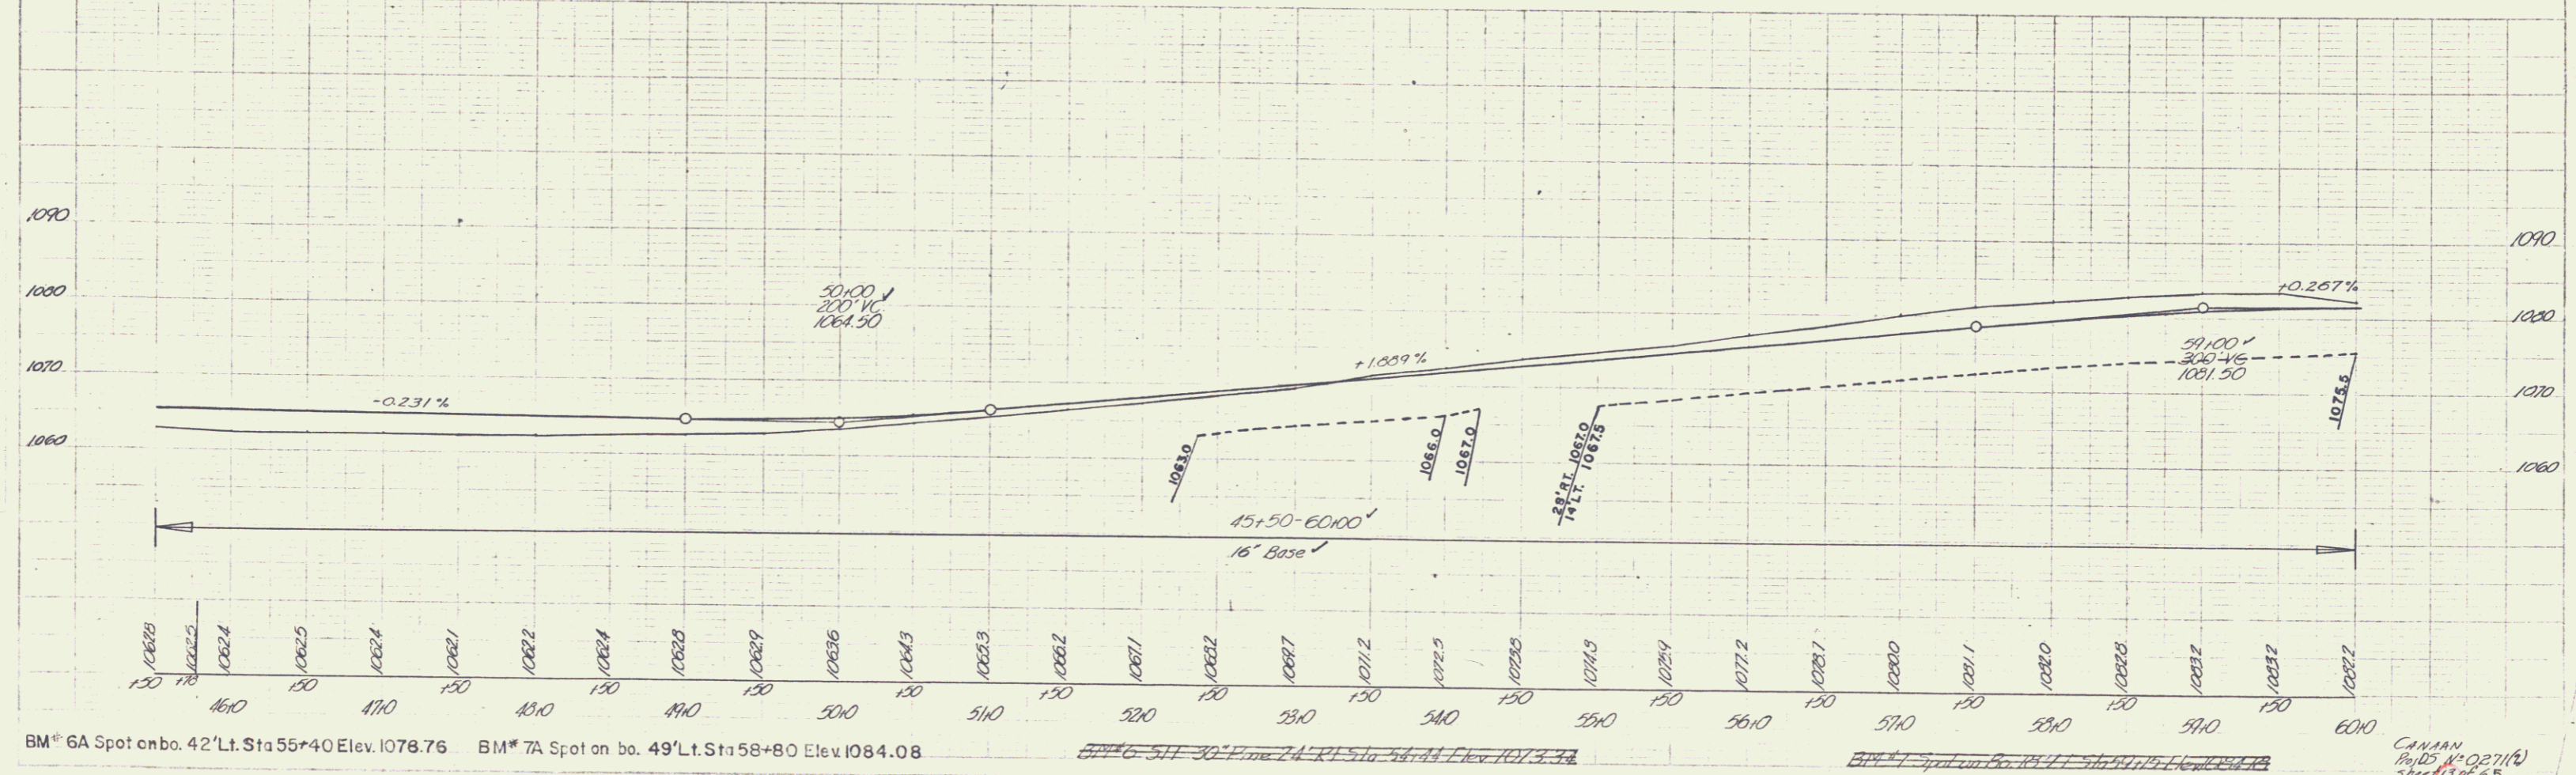


WOOD MARKER POSTS
45+50 - 47+53 LT.
CONSTRUCT DRIVES
14+00 LT. 51+30 LT. 57+25 LT.
TURNOUT
48+00 - 52+00 RT.
TWO CABLE GUARD RAIL
51+20 to 52+50 RT. 47+85
52+42 to 56+00 RT.

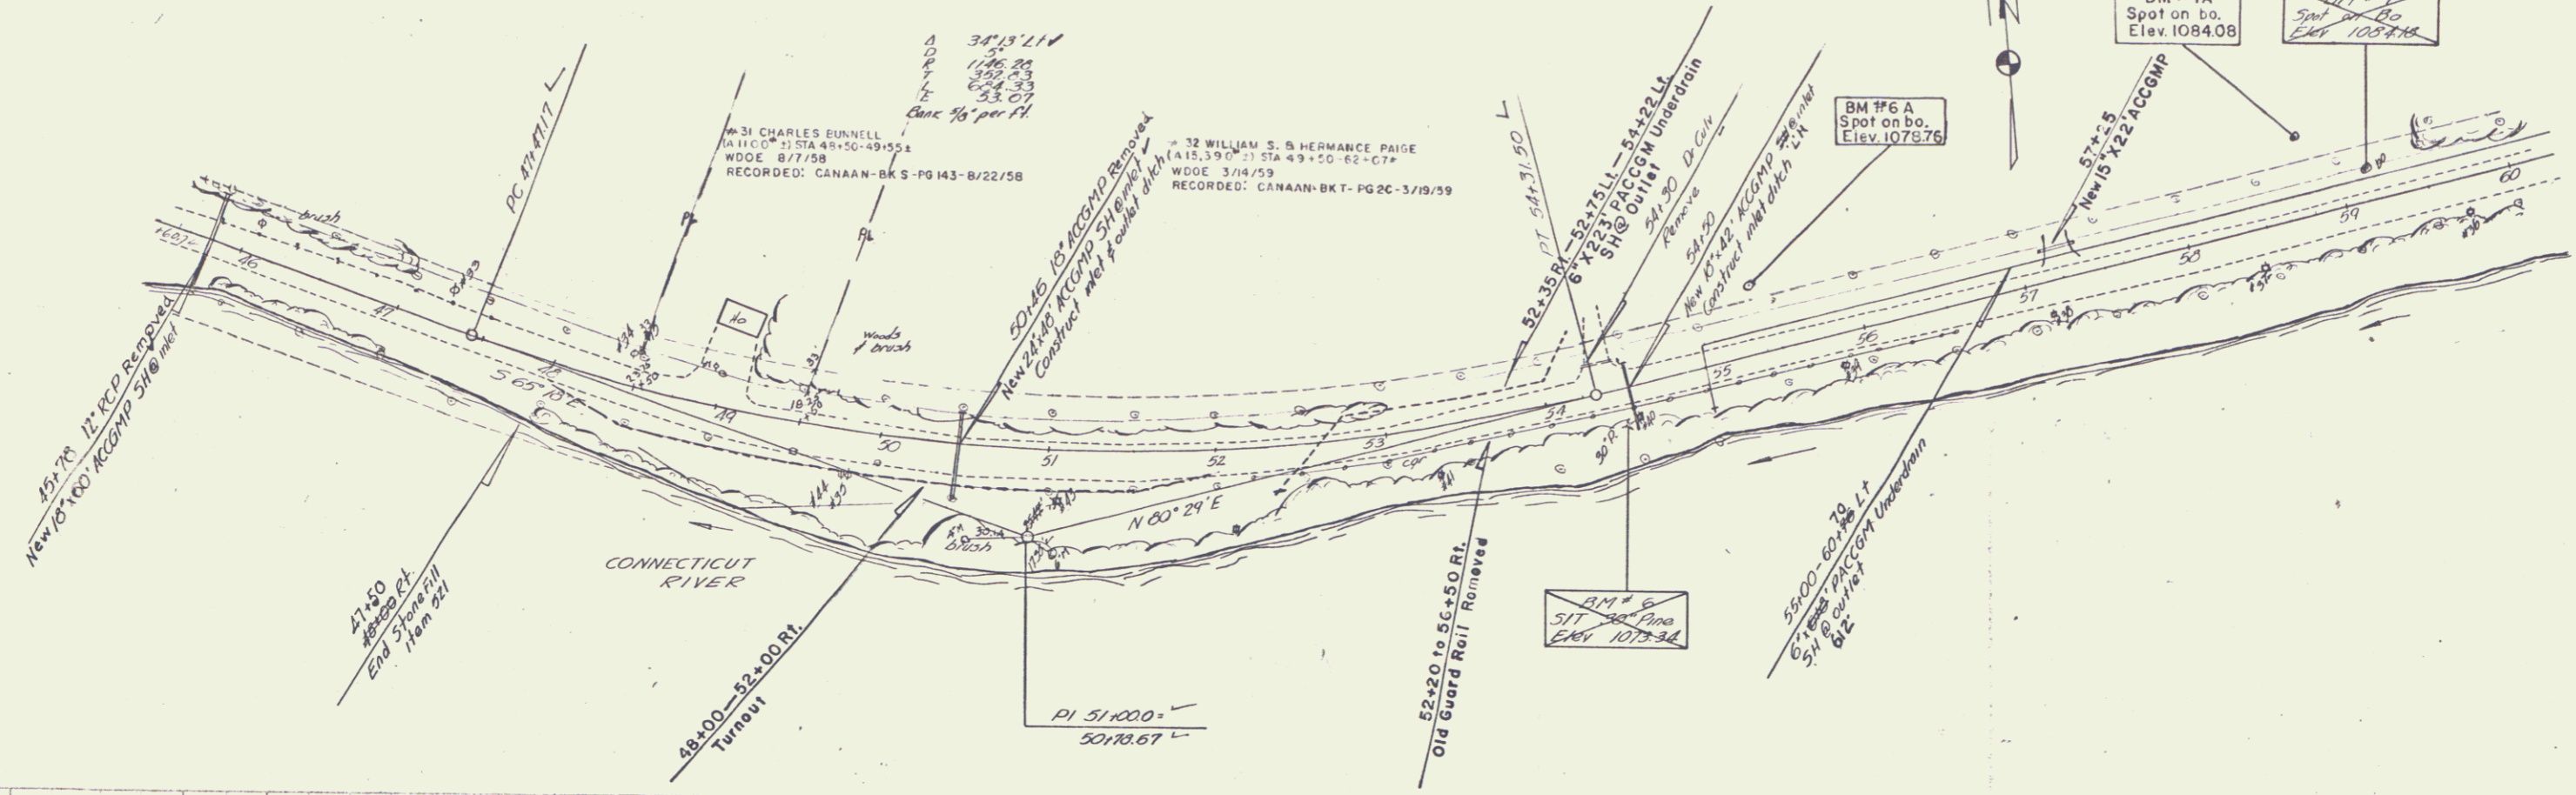

4/57
G.S. Channing
Aug 57

4/57
G.S. Channing
Sep 57

BM # 6A Spot on bo. 42' Lt. Sta 55+40 Elev. 1078.76
BM # 7A Spot on bo. 49' Lt. Sta 58+80 Elev. 1084.08

BM # 6 511 30' Pine 24' Rt. Sta 56+44 Elev. 1078.36

BM # 7 Spot on bo. 49' Lt. Sta 58+80 Elev. 1084.08

CANAAN
Rolls V-0271(R)
Sheet 5 of 6

5