



Class Drawing
Apr 57

Class Drawing
Apr 57

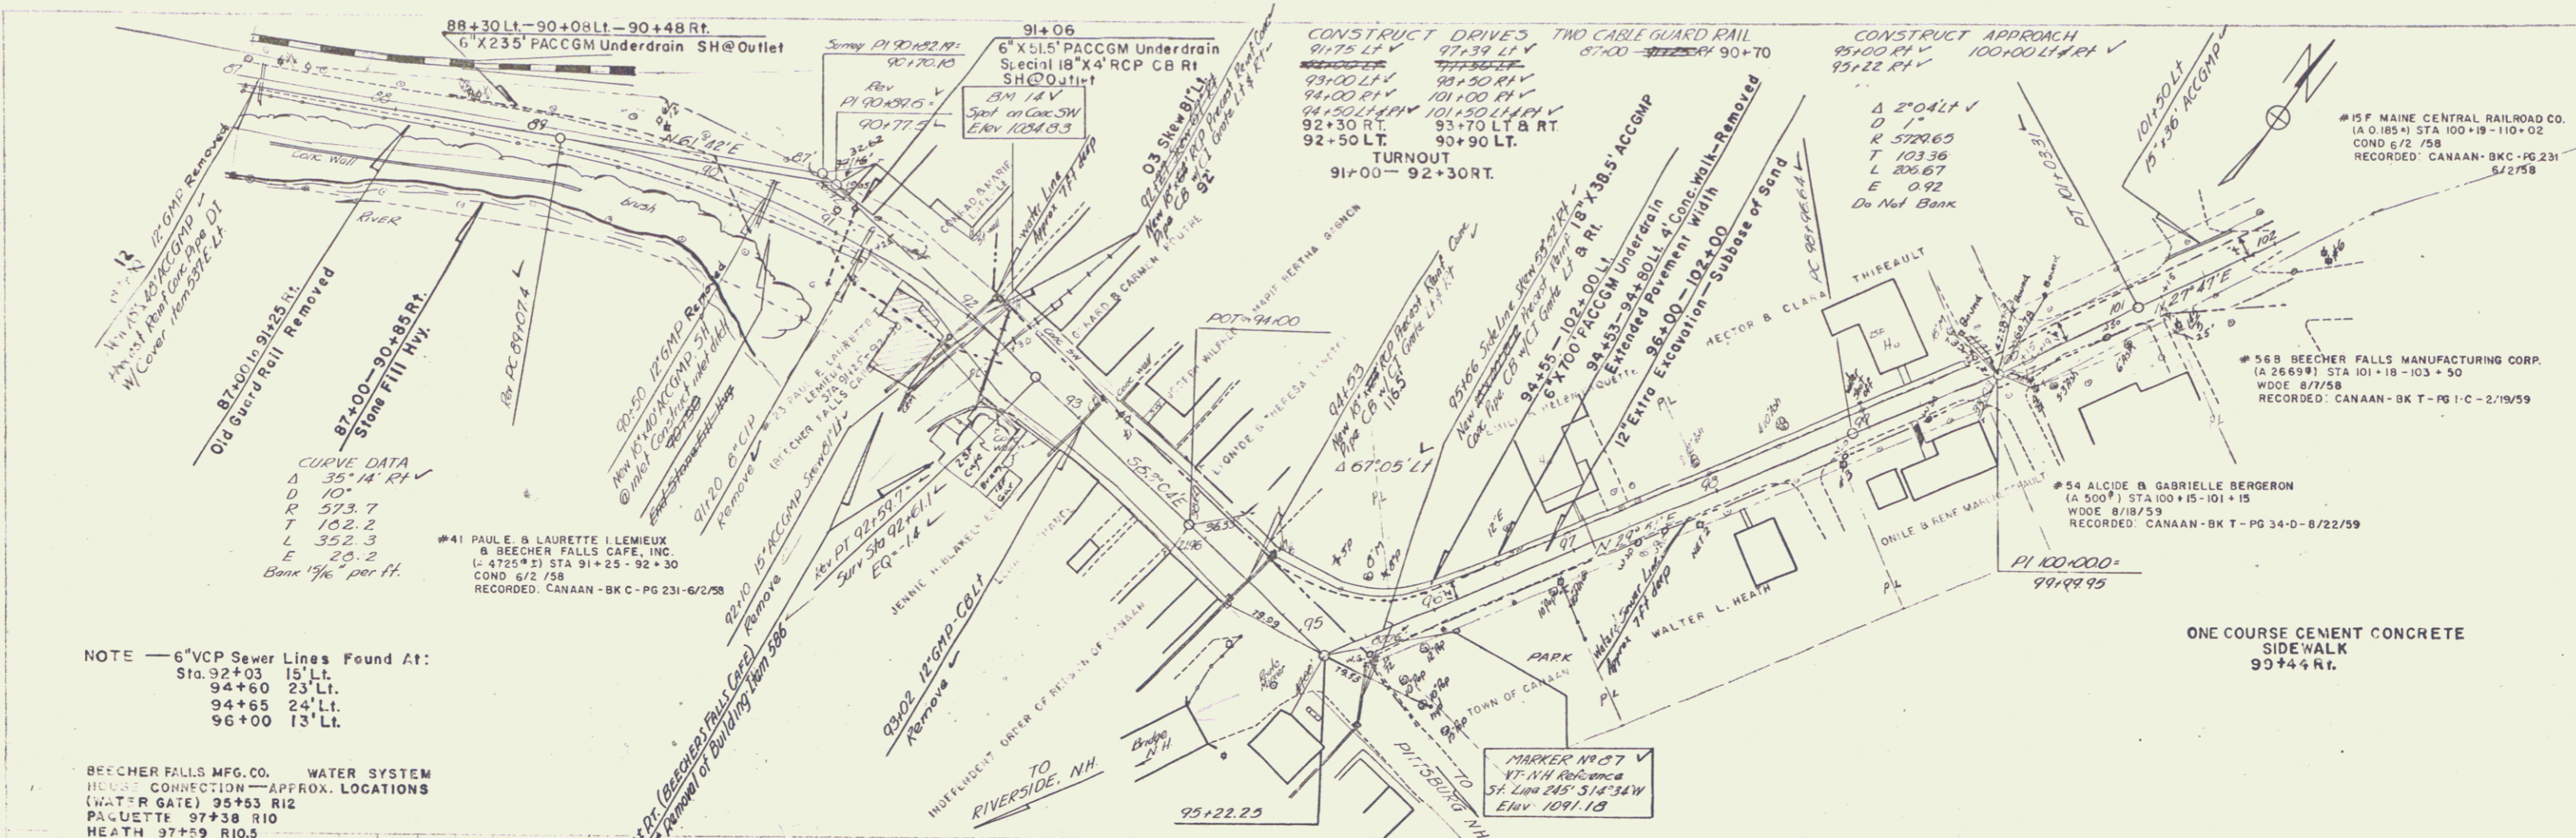

NOTE — 6" VCP Sewer Lines Found At:
Sta. 92+03 15' Lt.
94+60 23' Lt.
94+65 24' Lt.
96+00 13' Lt.

BEECHER FALLS MFG. CO. WATER SYSTEM
HOUSE CONNECTION — APPROX. LOCATIONS
(WATER GATE) 95+53 R12
PAQUETTE 97+38 R10
HEATH 97+59 R10.5
MARCHESSAULT 98+96 R11.5
THIEFAULT 93+46 R 7.5
BERGERON 100+74 R 7.5

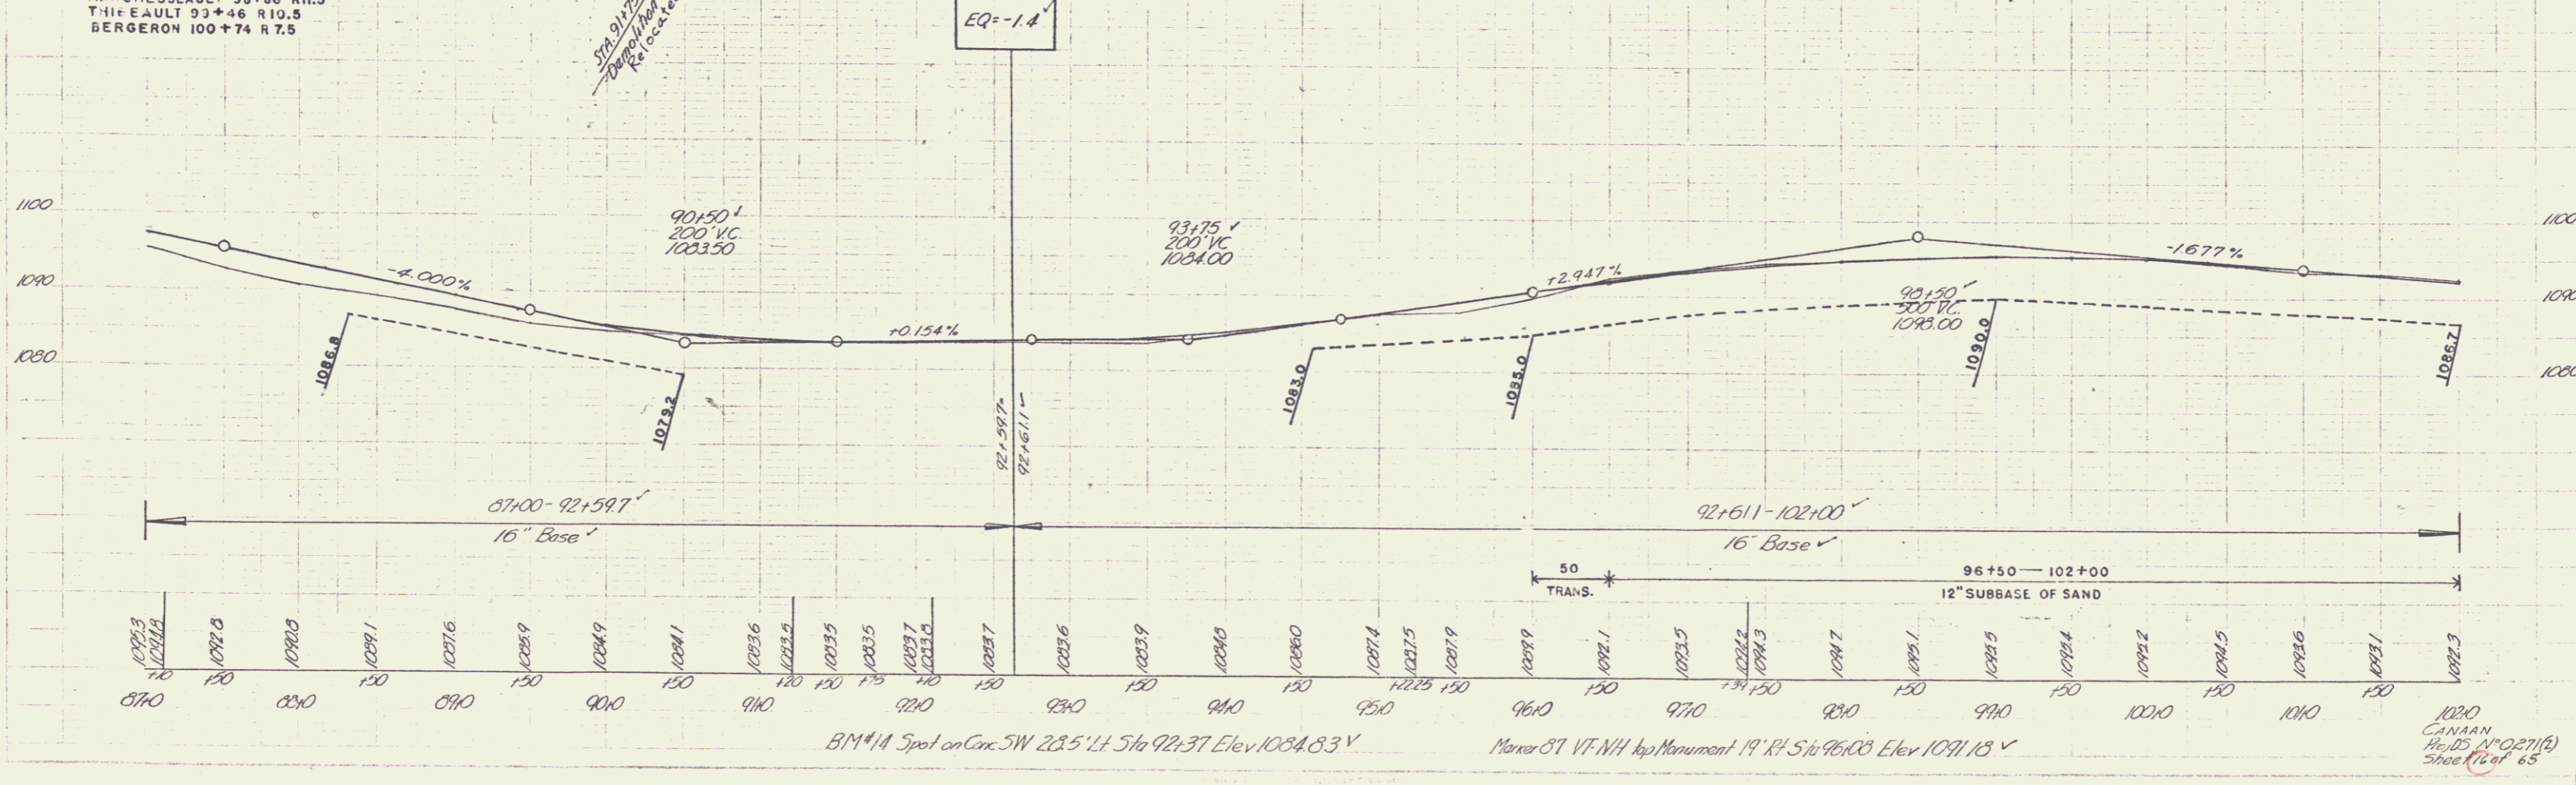

8