


PLAN
 DATE: 10/15/58
 DRAWN BY: [illegible]
 CHECKED BY: [illegible]

PROFILE
 DATE: 10/15/58
 DRAWN BY: [illegible]
 CHECKED BY: [illegible]

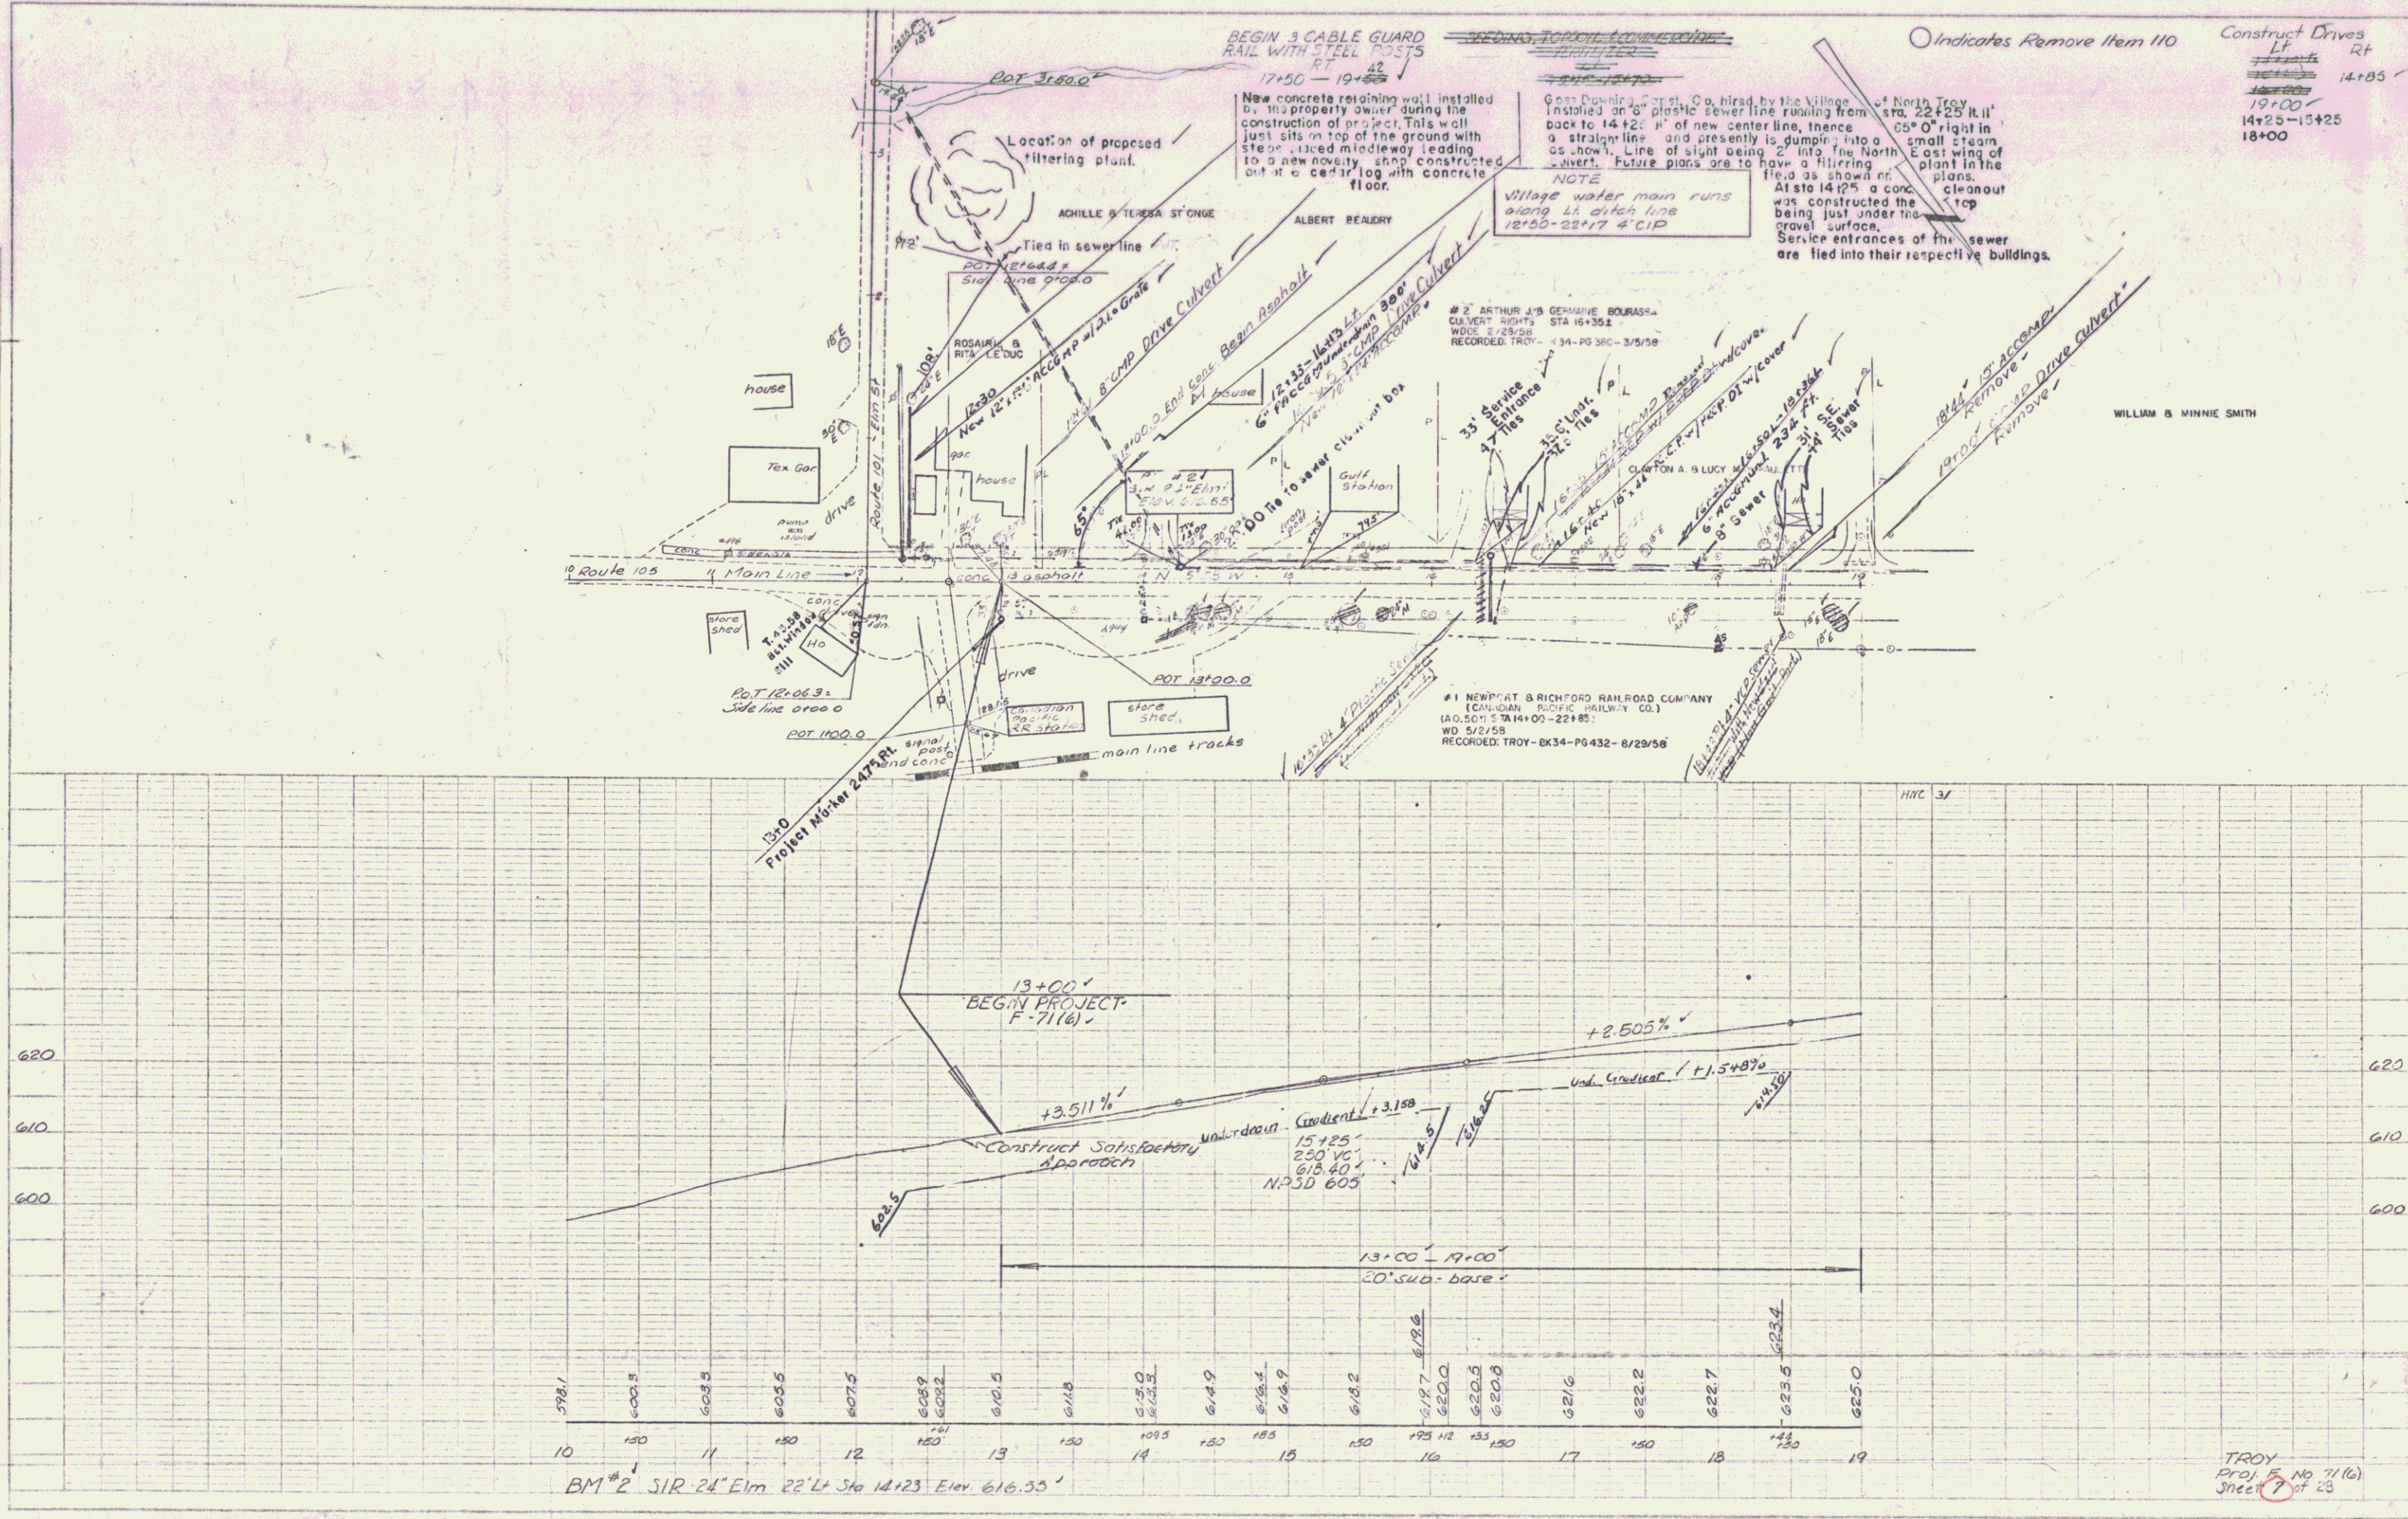

TROY
 Proj. No. 11(6)
 Sheet 7 of 23

2