


A.A. Doe
 P.L. SHAWNS
 4/73
 4/23

A.A. Doe
 P.L. SHAWNS
 4/73
 4/23

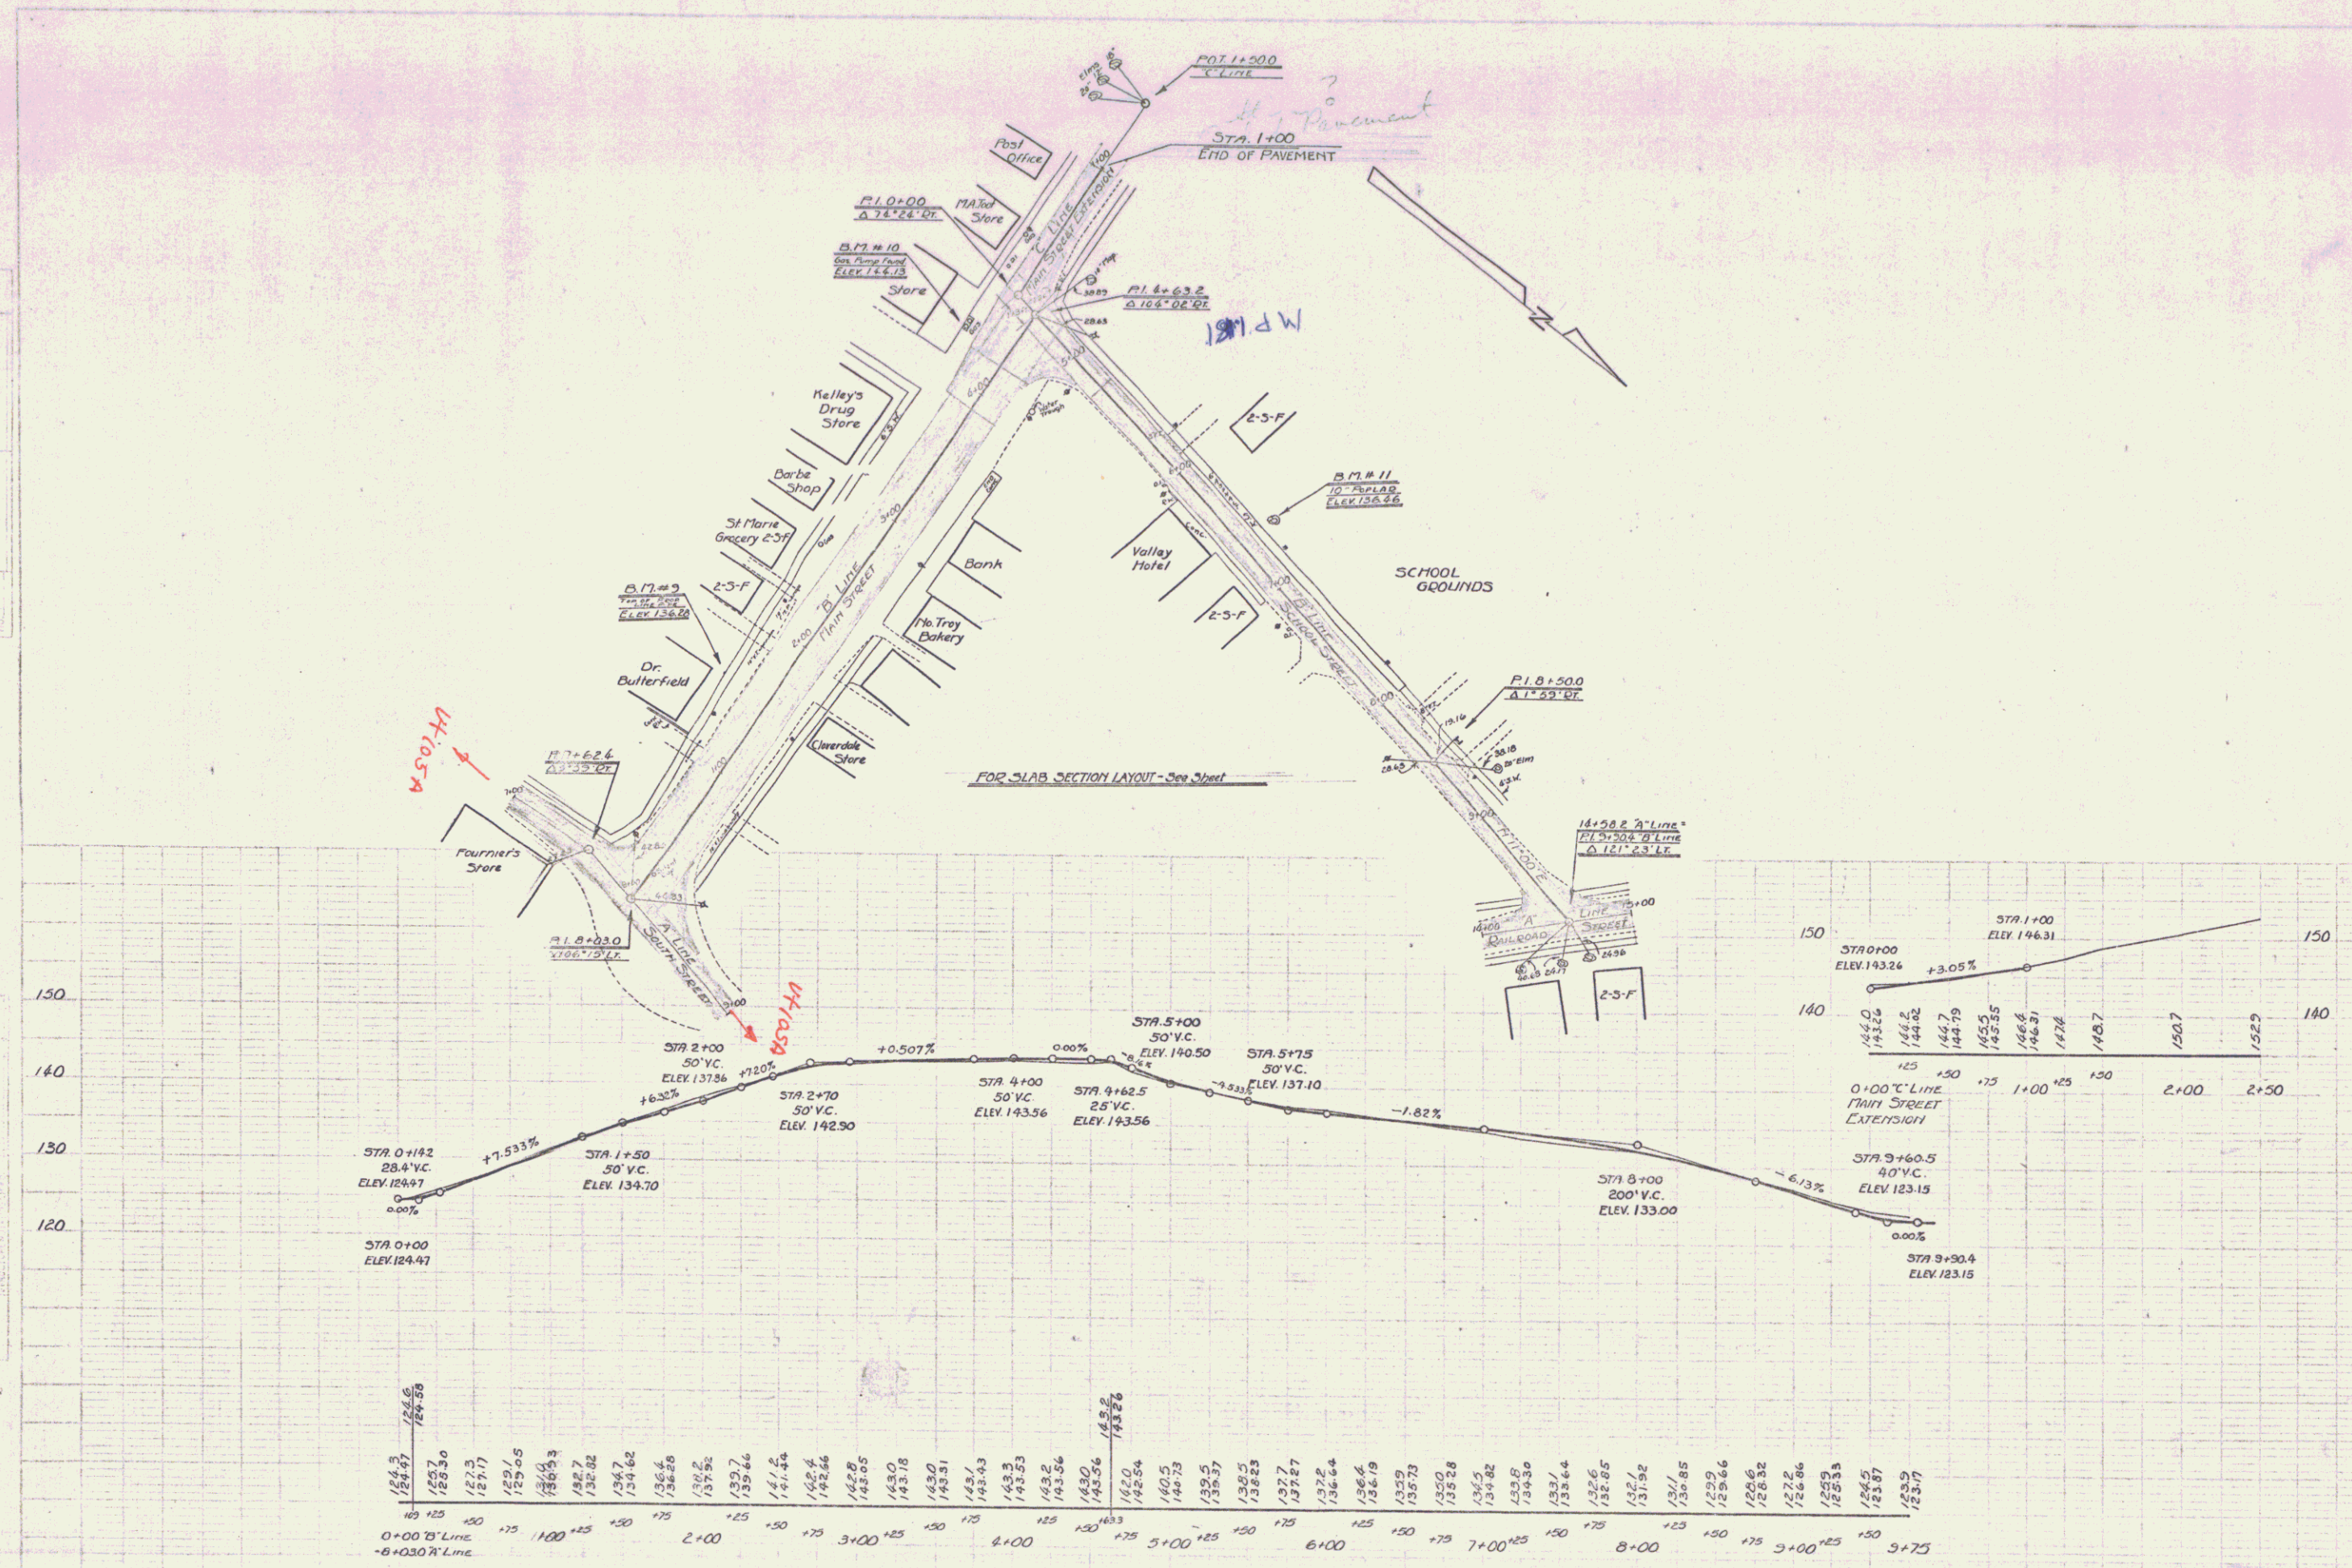

B17#3 TOP OF PROPERTY LINE PIPE 34 FT. LT. OF STA 1+55 ELEV. 136.28
 B17#10 GAS PUMP FOUNDATION 33 FT. LT. OF STA 4+30 ELEV. 144.13
 B17#11 3" x 1" INCH 10" POPLAR 23 FT. LT. OF STA 6+63 ELEV. 136.46

VILLAGE OF
 North Troy
 SHEET 5 OF 13