

INDEX OF SHEETS

SHEET NO. 1	TITLE PAGE
2	TYPICAL CROSS-SECTION OF IMPROVEMENT CRUSHED GRAVEL MIXED-IN-PLACE SURFACE COURSE WITH REFINED TAR, ITEM 341 (MODIFIED)
3	BANKING AND WIDENING TABLES
4	QUANTITY SHEET (ITEMS)
5	QUANTITY SHEET (DRAINAGE)
6-9	EARTHWORK SHEETS
10-19	PLAN AND PROFILE SHEETS
20	CONSTRUCTION DETAILS - GRM. PIPE CULVERTS, MARKERS, GUIDE POSTS.
21	CONSTRUCTION DETAILS - NO. 1, DITCHES, GUARD RAIL POS, SLOPES IN ROCK EXCAV.
22	CONSTRUCTION DETAILS - NO. 2, ROUNDING OF SLOPES, TURNOUTS.
22A	STANDARD STRUCTURE SHEET S 40 BARRIAGES SIGNS AND LIGHTS.
23	STANDARD STRUCTURE SHEET S 45-45 GUARD RAIL.
24	STANDARD STRUCTURE SHEET S 53-48 PG. R.C.P. DROP INLET.
25	CORR. GALV. METAL PLATE PIPE ARCH STA 84+70
26-28	CROSS SECTIONS

STATE	FISCAL YEAR	TOTAL SHEETS
VT.	1952	58

STATE OF VERMONT
STATE HIGHWAY DEPARTMENT


PLAN AND PROFILE OF PROPOSED
STATE HIGHWAY
FEDERAL PROJECT

TOWN OF ARLINGTON
COUNTY OF BENNINGTON Pin# 99R675


VERMONT ROUTE 313
CAMBRIDGE, N.Y.-ARLINGTON, VT. ROAD

BEGINNING AT THE NEW YORK AND VERMONT STATE LINE AND EXTENDING EASTERLY 13,168.7 FEET.

LENGTH OF PROJECT 13,168.7 FEET = 2.494 MILES.

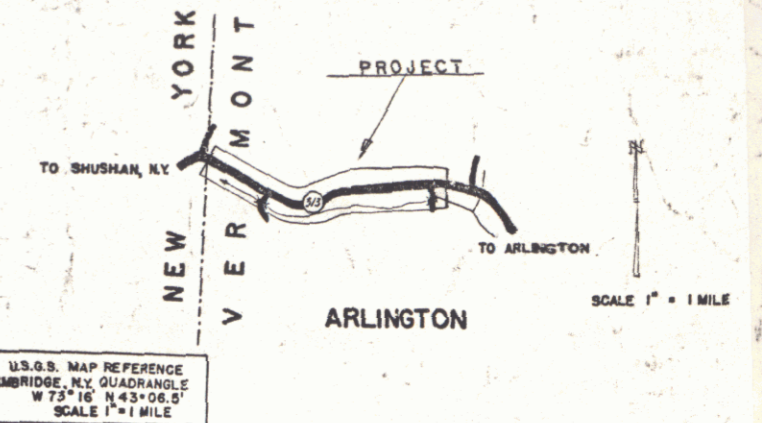

PROJECT NAME & NUMBER	ARLINGTON F 141 (2)	TYPE	MIX-IN-PLACE	PAVEMENT AREA	32190 SY.
RECORD PLANS					
MATERIALS					
SUB-BASE OF GRAVEL	WOODS PT. SUNDELAND AND WOODS KEK PIT, ARLINGTON	RCP	VT. CONC. PIPE CO., WINDSOR		
TAR	AMERICAN TAR CO., SPRINGFIELD, MASS.	ACCGMP	NEW ENG. MET. CULVERT CO., BOSTON, MASS.		
FIBRE DR. PIPE	BROWN CO. BERLIN, N.H.	CONC. AGG.	DAILEY PLANT, S. SHAFTSBURY		
GUARD RAIL AM. STEEL & WIRE CO., N. HAVEN, CT.					
CONTRACTOR	S. V. ROSSI CONSTR. CO.	CONTRACT DATED	AUG. 18, 1952		
RES. ENGINEER	M. VAN KLEEF, JR.	CONTRACT STARTED	SEPT. 16, 1952		
INSPECTOR	M. VAN KLEEF, JR.	CONTRACT COMPLETED	OCT. 22, 1953		
RECORD PLANS	M. VAN KLEEF, JR.	CONTRACT ACCEPTED	OCT. 22, 1953		

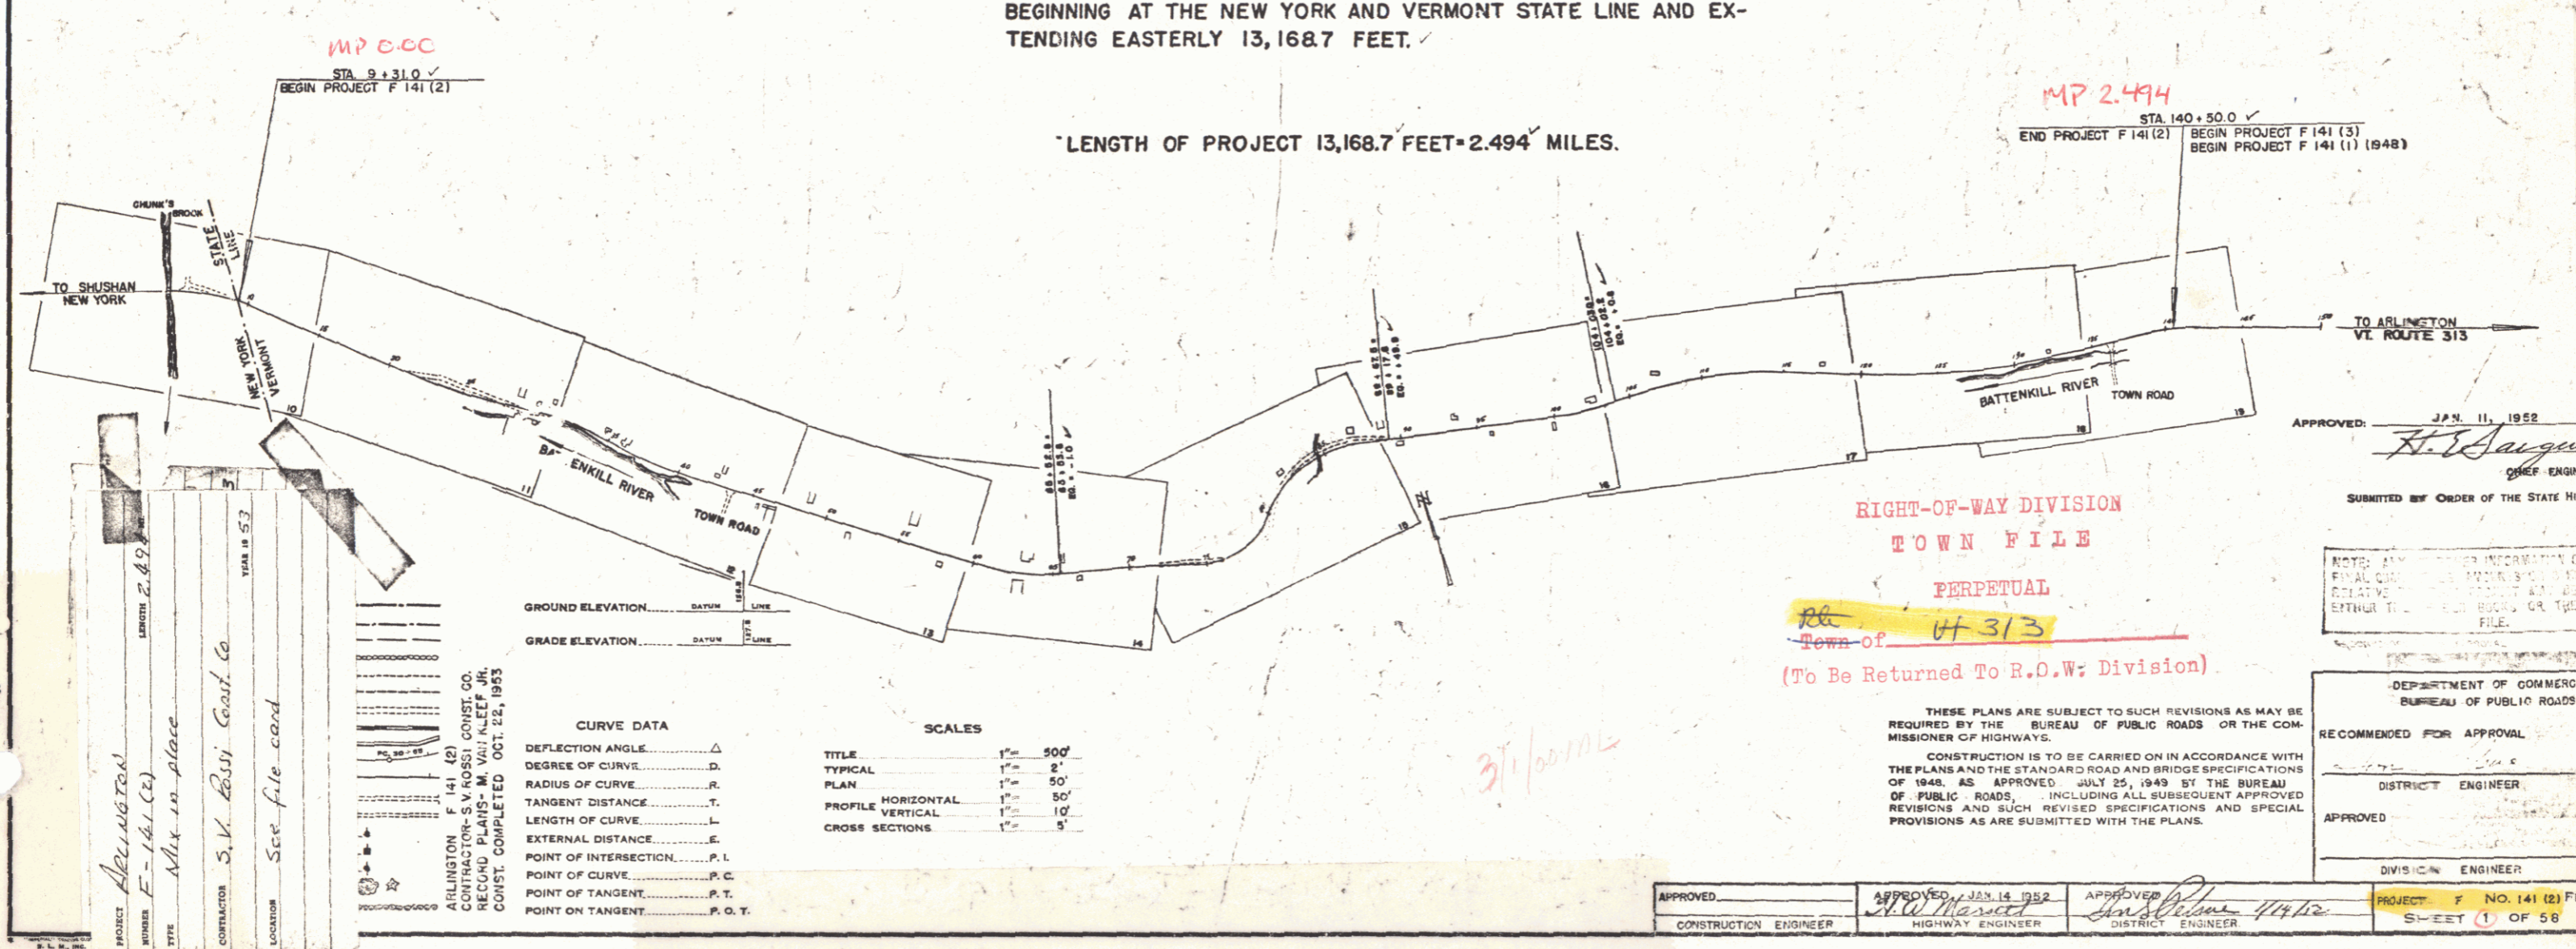

Project: ARLINGTON
Number: F-141 (2)
Type: Mix in place
Contractor: S.V. Rossi Const. Co.
Location: See file card

CURVE DATA

DEFLECTION ANGLE	Δ
DEGREE OF CURVE	D
RADIUS OF CURVE	R
TANGENT DISTANCE	T
LENGTH OF CURVE	L
EXTERNAL DISTANCE	E
POINT OF INTERSECTION	P. I.
POINT OF CURVE	P. C.
POINT OF TANGENT	P. T.
POINT ON TANGENT	P. O. T.

SCALES

TITLE	1" = 500'
TYPICAL	1" = 5'
PLAN	1" = 50'
PROFILE HORIZONTAL	1" = 50'
PROFILE VERTICAL	1" = 10'
CROSS SECTIONS	1" = 5'

RIGHT-OF-WAY DIVISION
TOWN FILE
PERPETUAL
Town of 47313
(To Be Returned To R.O.W. Division)

THESE PLANS ARE SUBJECT TO SUCH REVISIONS AS MAY BE REQUIRED BY THE BUREAU OF PUBLIC ROADS OR THE COMMISSIONER OF HIGHWAYS.
CONSTRUCTION IS TO BE CARRIED ON IN ACCORDANCE WITH THE PLANS AND THE STANDARD ROAD AND BRIDGE SPECIFICATIONS OF 1948, AS APPROVED JULY 25, 1949 BY THE BUREAU OF PUBLIC ROADS, INCLUDING ALL SUBSEQUENT APPROVED REVISIONS AND SUCH REVISED SPECIFICATIONS AND SPECIAL PROVISIONS AS ARE SUBMITTED WITH THE PLANS.

APPROVED	APPROVED JAN. 14 1952 N.W. Maxwell HIGHWAY ENGINEER	APPROVED S. V. Rossi DISTRICT ENGINEER	PROJECT F NO. 141 (2) FILED SHEET 1 OF 58
----------	---	--	--

APPROVED: *H. J. August*
CHIEF ENGINEER
SUBMITTED BY ORDER OF THE STATE HIGHWAY BOARD
DEPARTMENT OF COMMERCE
BUREAU OF PUBLIC ROADS
RECOMMENDED FOR APPROVAL
DISTRICT ENGINEER
APPROVED
DIVISION ENGINEER DATE