



PARCEL INSTR DATE GRANTOR GRANTEE RECORDED BOOK PAGE DATE REMARKS  
 #9 N.D.O.E. 7-24-35 CLARENCE J. & BELLE DECKER Sr & W. ARLINGTON 29 26-27 8-4-52

CONSTRUCT DITCHES  
 Sta 46+00 RI - Sta 53+00 RI  
 Sta 48+00 LI - Sta 51+00 LI  
 Sta 49+11 LI - Sta 52+00 LI  
 Sta 51+75 LI - Sta 57+76 LI  
 Sta 46+75 LI - Sta 54+38 LI  
 Sta 46+59 LI - Sta 57+10 LI

FED. DEV.	STATE	FISCAL YEAR	PROJECT NO.	SHEET NO.	TOTAL SHEETS
			111(2) 5001	12	53

DATE 8-6-52  
 DRAWN BY A. J. J. JR.  
 CHECKED BY A. J. J. JR.  
 PLAN SHEET NO. 12

DATE 8-6-52  
 DRAWN BY A. J. J. JR.  
 CHECKED BY A. J. J. JR.  
 PLAN SHEET NO. 12

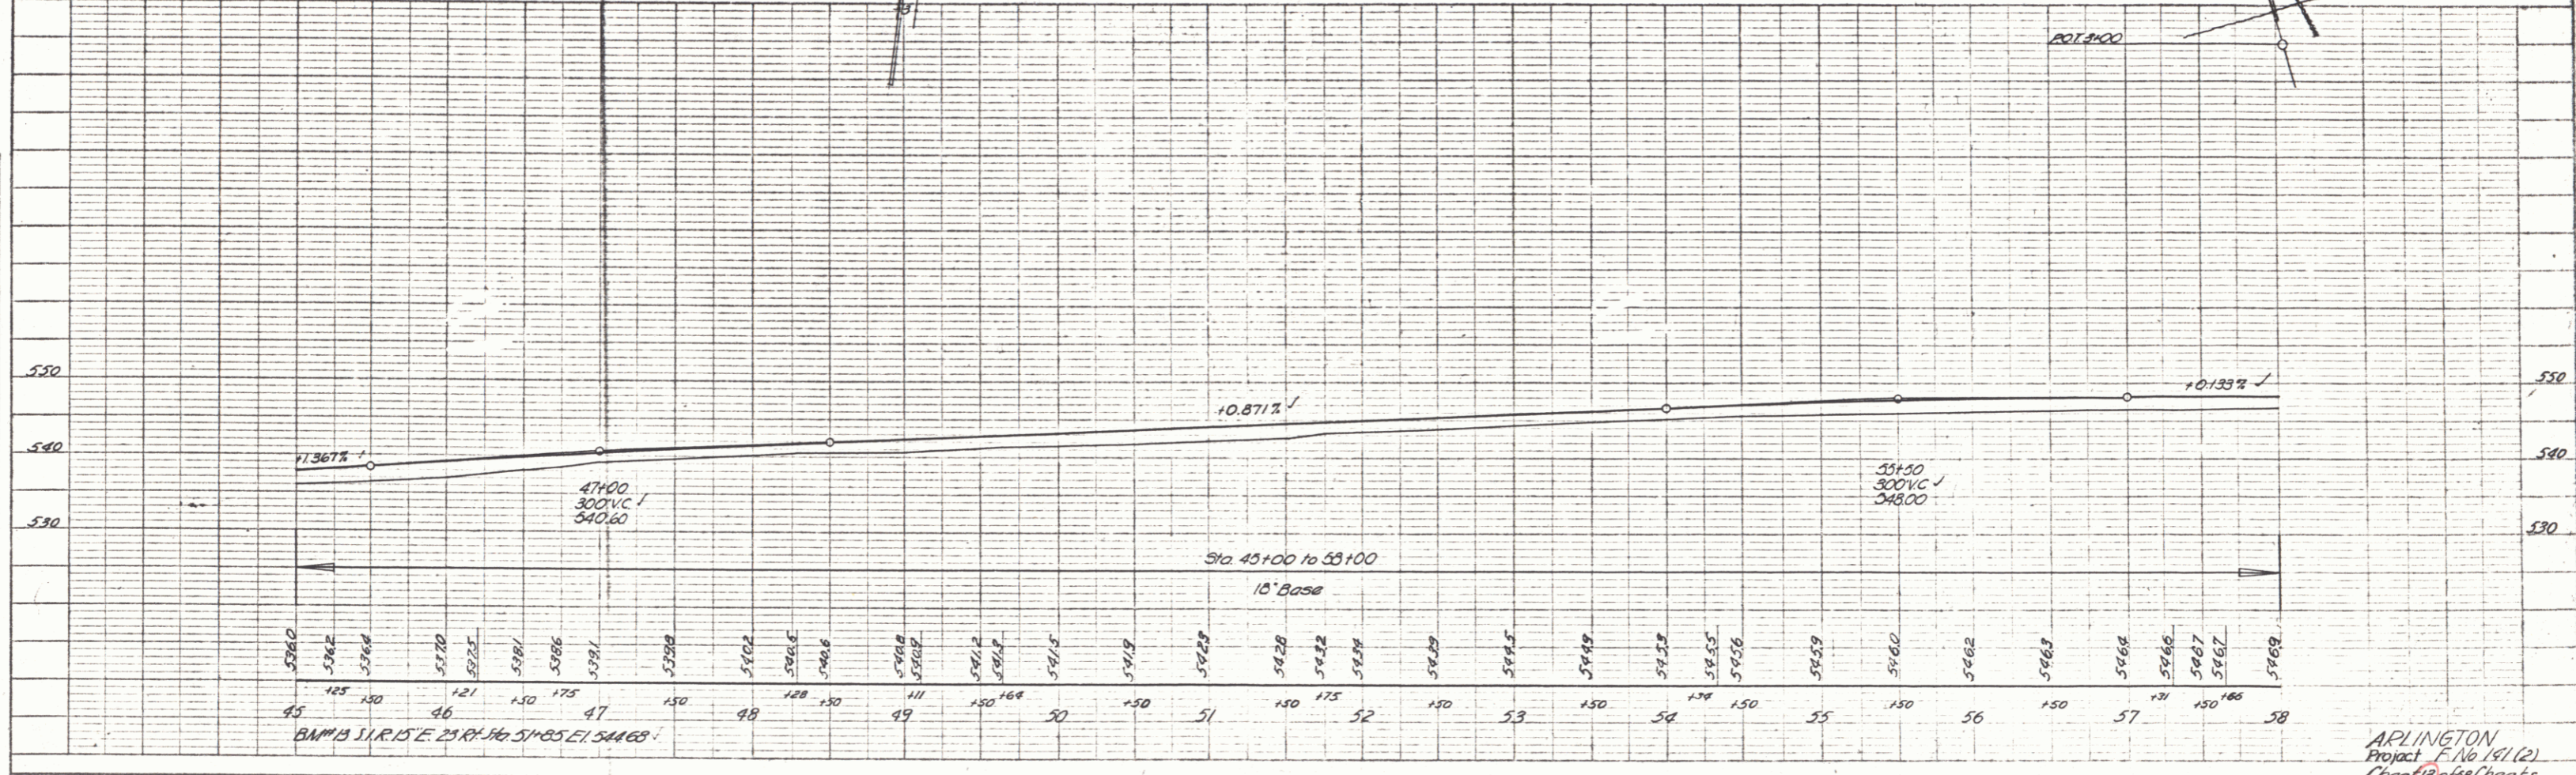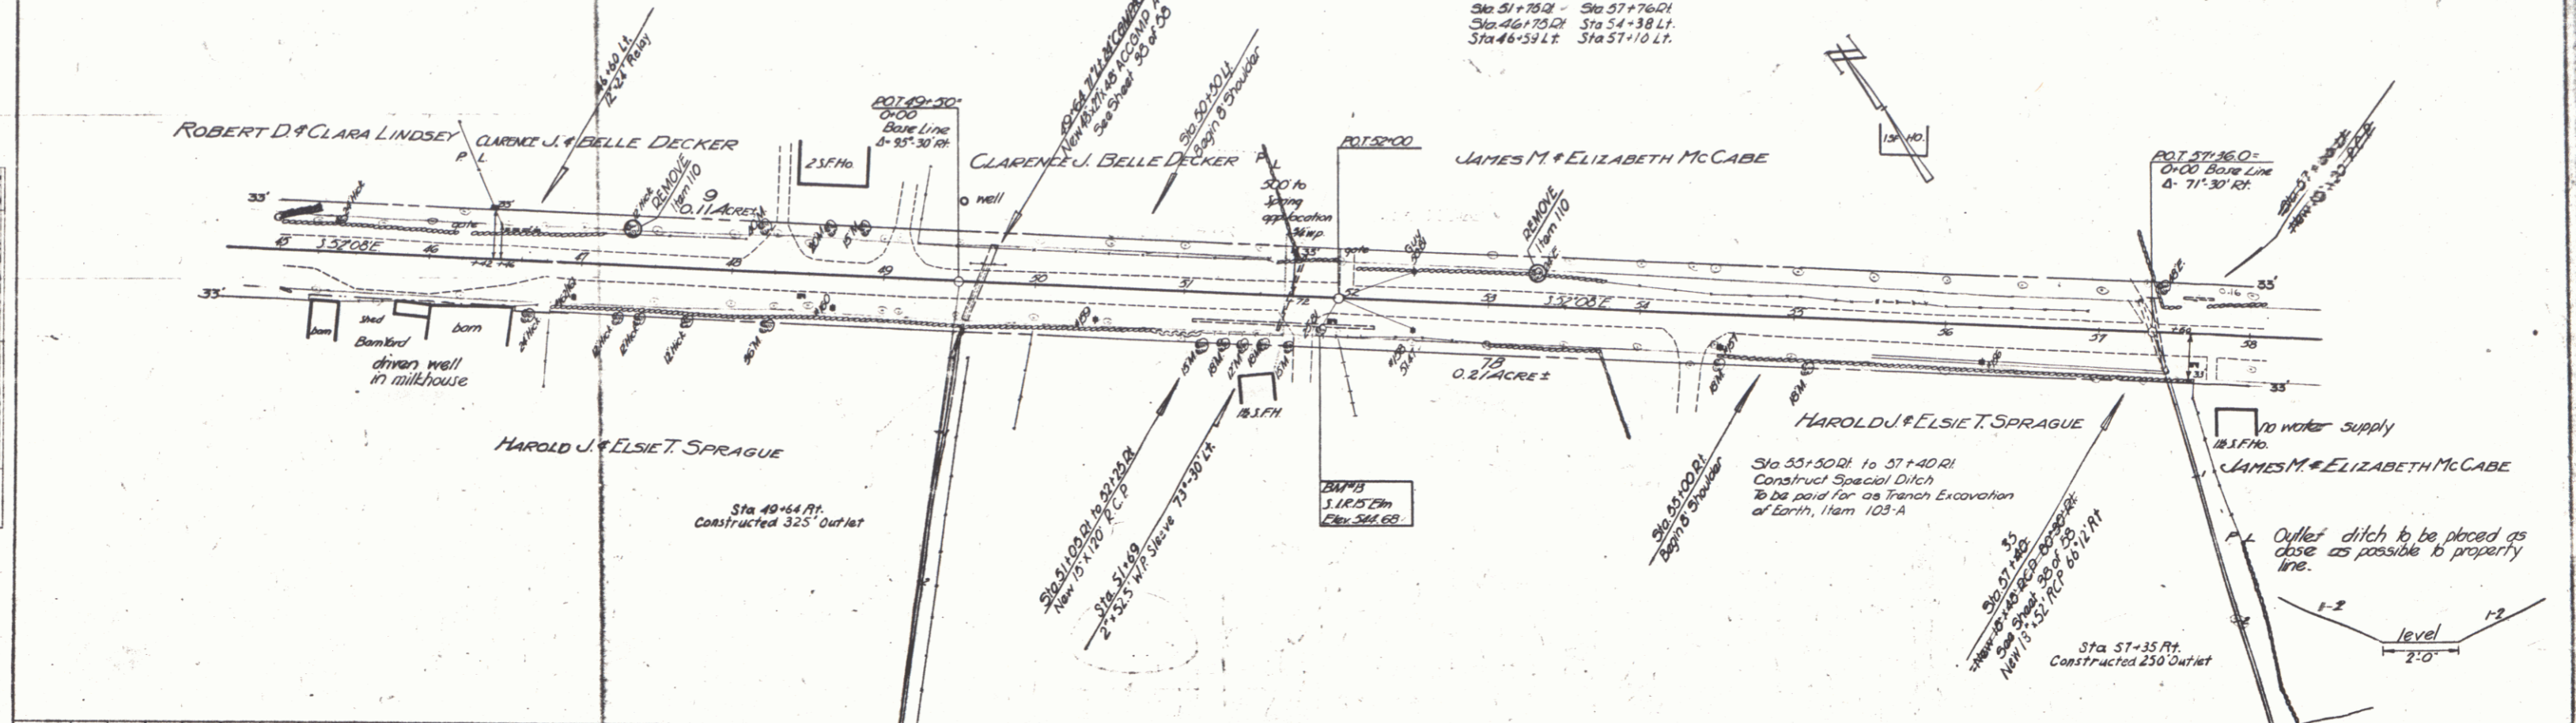

ARLINGTON  
 Project No. 141(2)  
 Sheet 12 of 53 sheets

PLATE 1 - PLAN - PROFILE & P.A.A.R. DRAWING  
 PROJECT & E.G.A. COL. REG. FORM