



PLAN
 DRAWN BY
 CHECKED BY
 DATE
 PROJECT NO.

PROFILE
 DRAWN BY
 CHECKED BY
 DATE
 PROJECT NO.

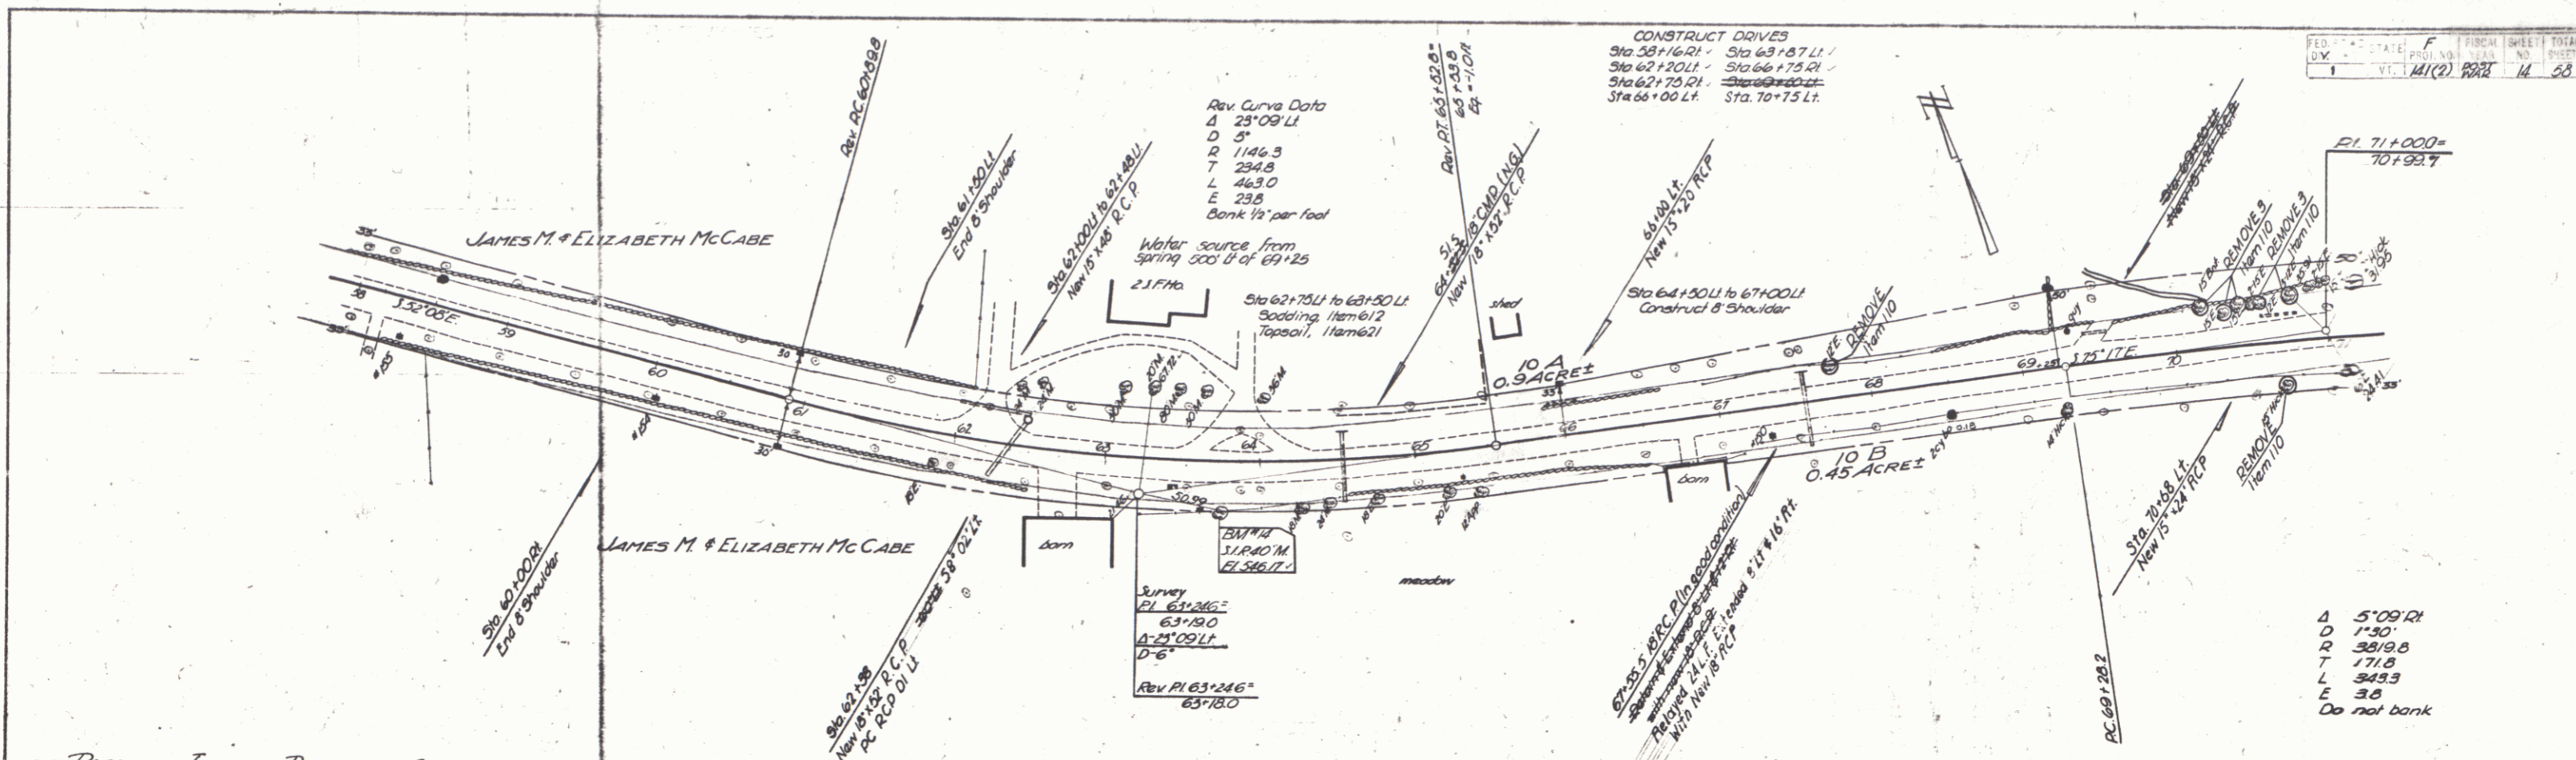

Parcel	Insta	Date	Grantor	Grantee	Recorded	Book	Page	Date	Remarks
#10A, B	N.D.O.E.	7-24-52	JAMES M. & ELIZABETH McCABE & of H.	ARLINGTON	29	28, 29	8-14-52	See Sheets 13 & 15	

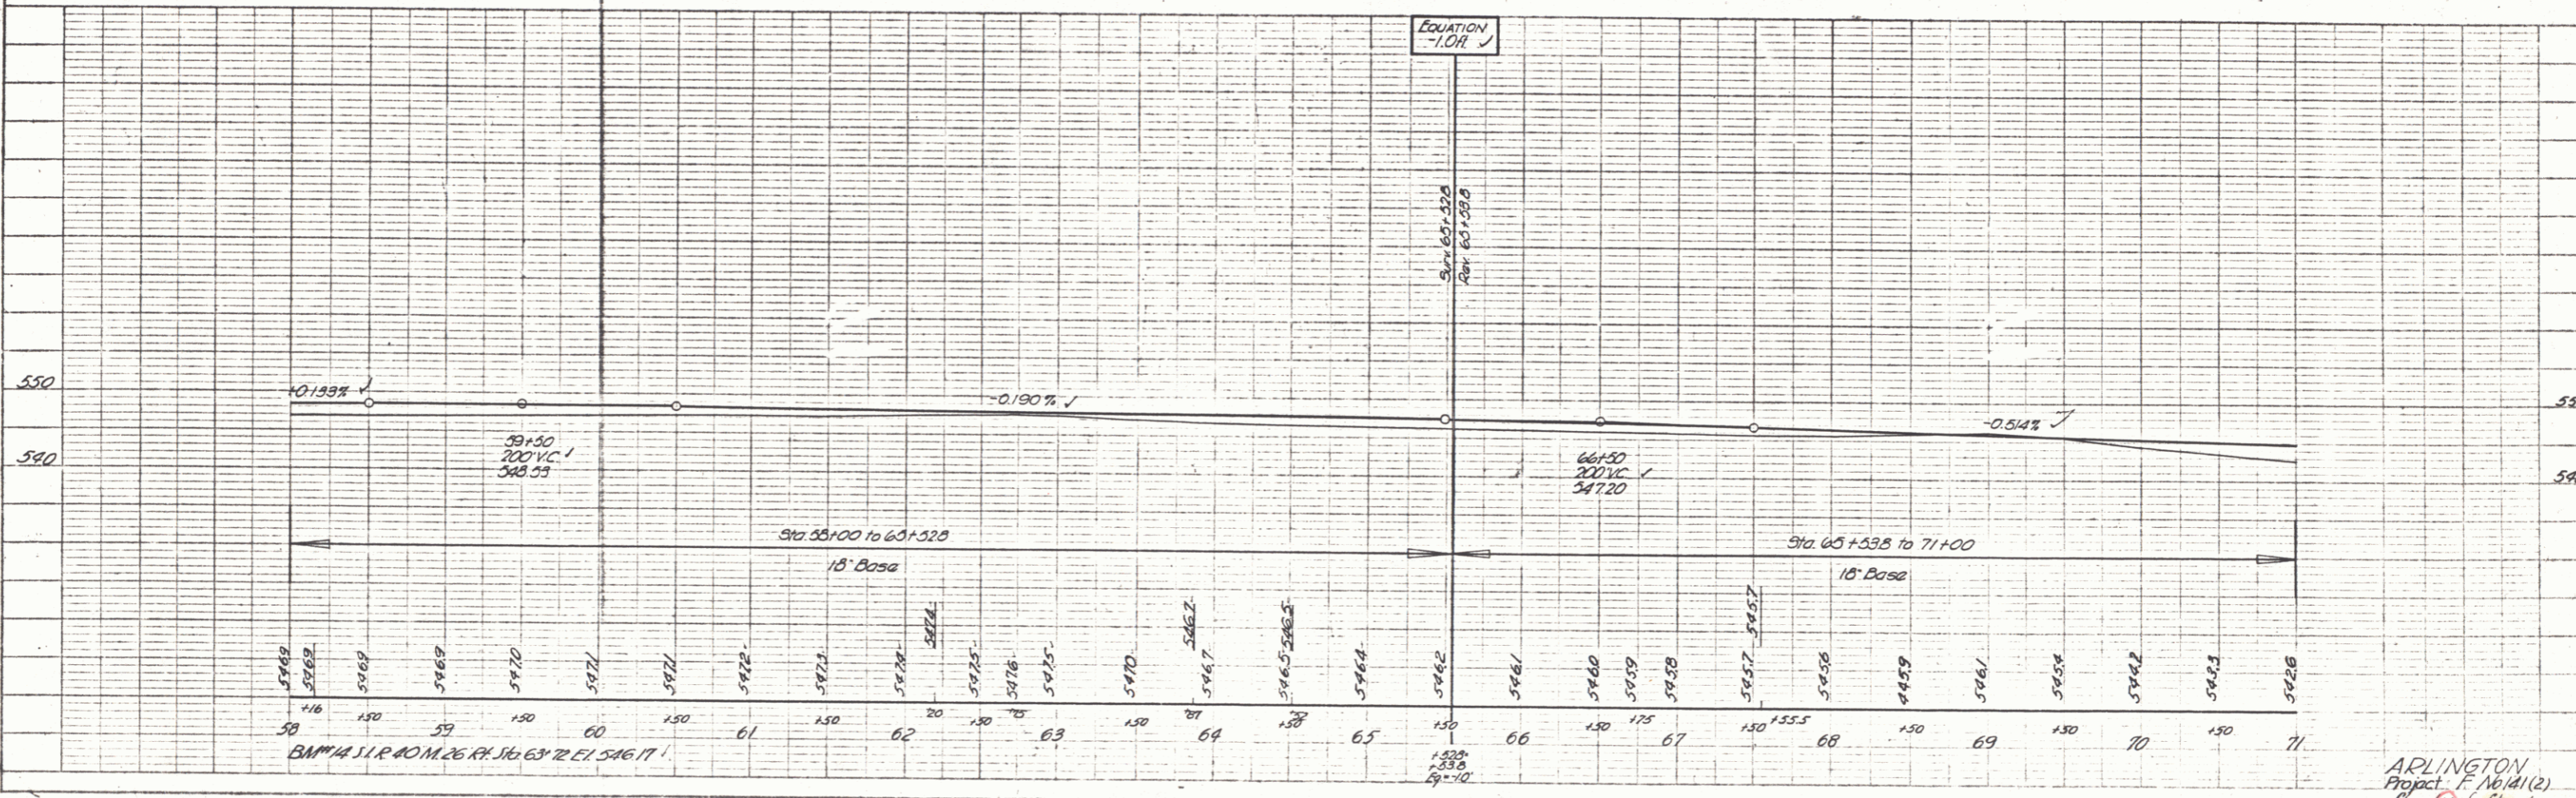

ARLINGTON
 Project F No 141(2)
 Dated 12/10/58
 6