



CONSTRUCT DRIVES	
LEFT	RIGHT
157+50	157+70
159+00	154+50
160+00	156+10
	157+00
	159+00

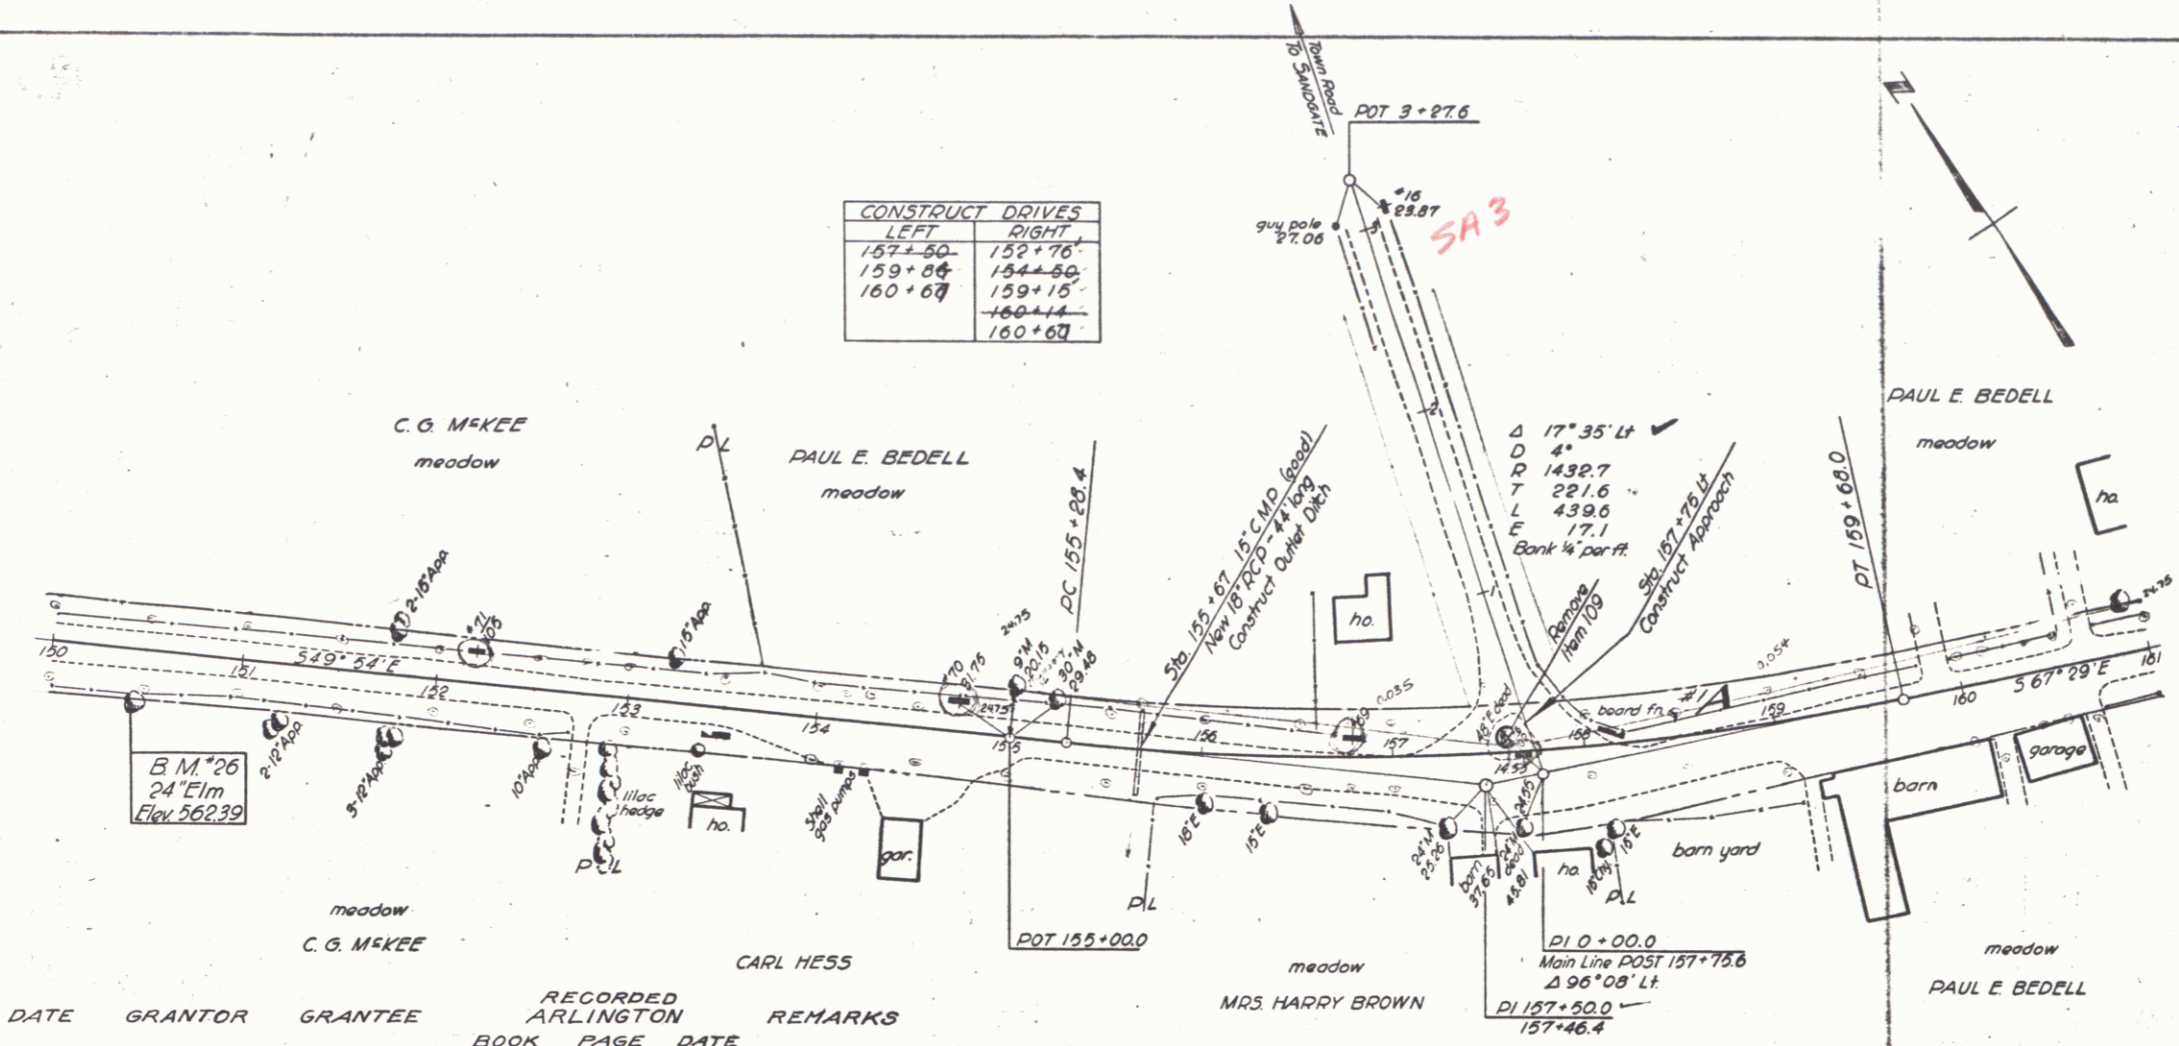

PARCEL	INSTRUMENT	DATE	GRANTOR	GRANTEE	RECORDED ARLINGTON BOOK PAGE DATE	REMARKS
#17	W.D.O.E.	8-11-28	PAUL E. BEDELL	ST. OF VT.	27 495 9-17-28	

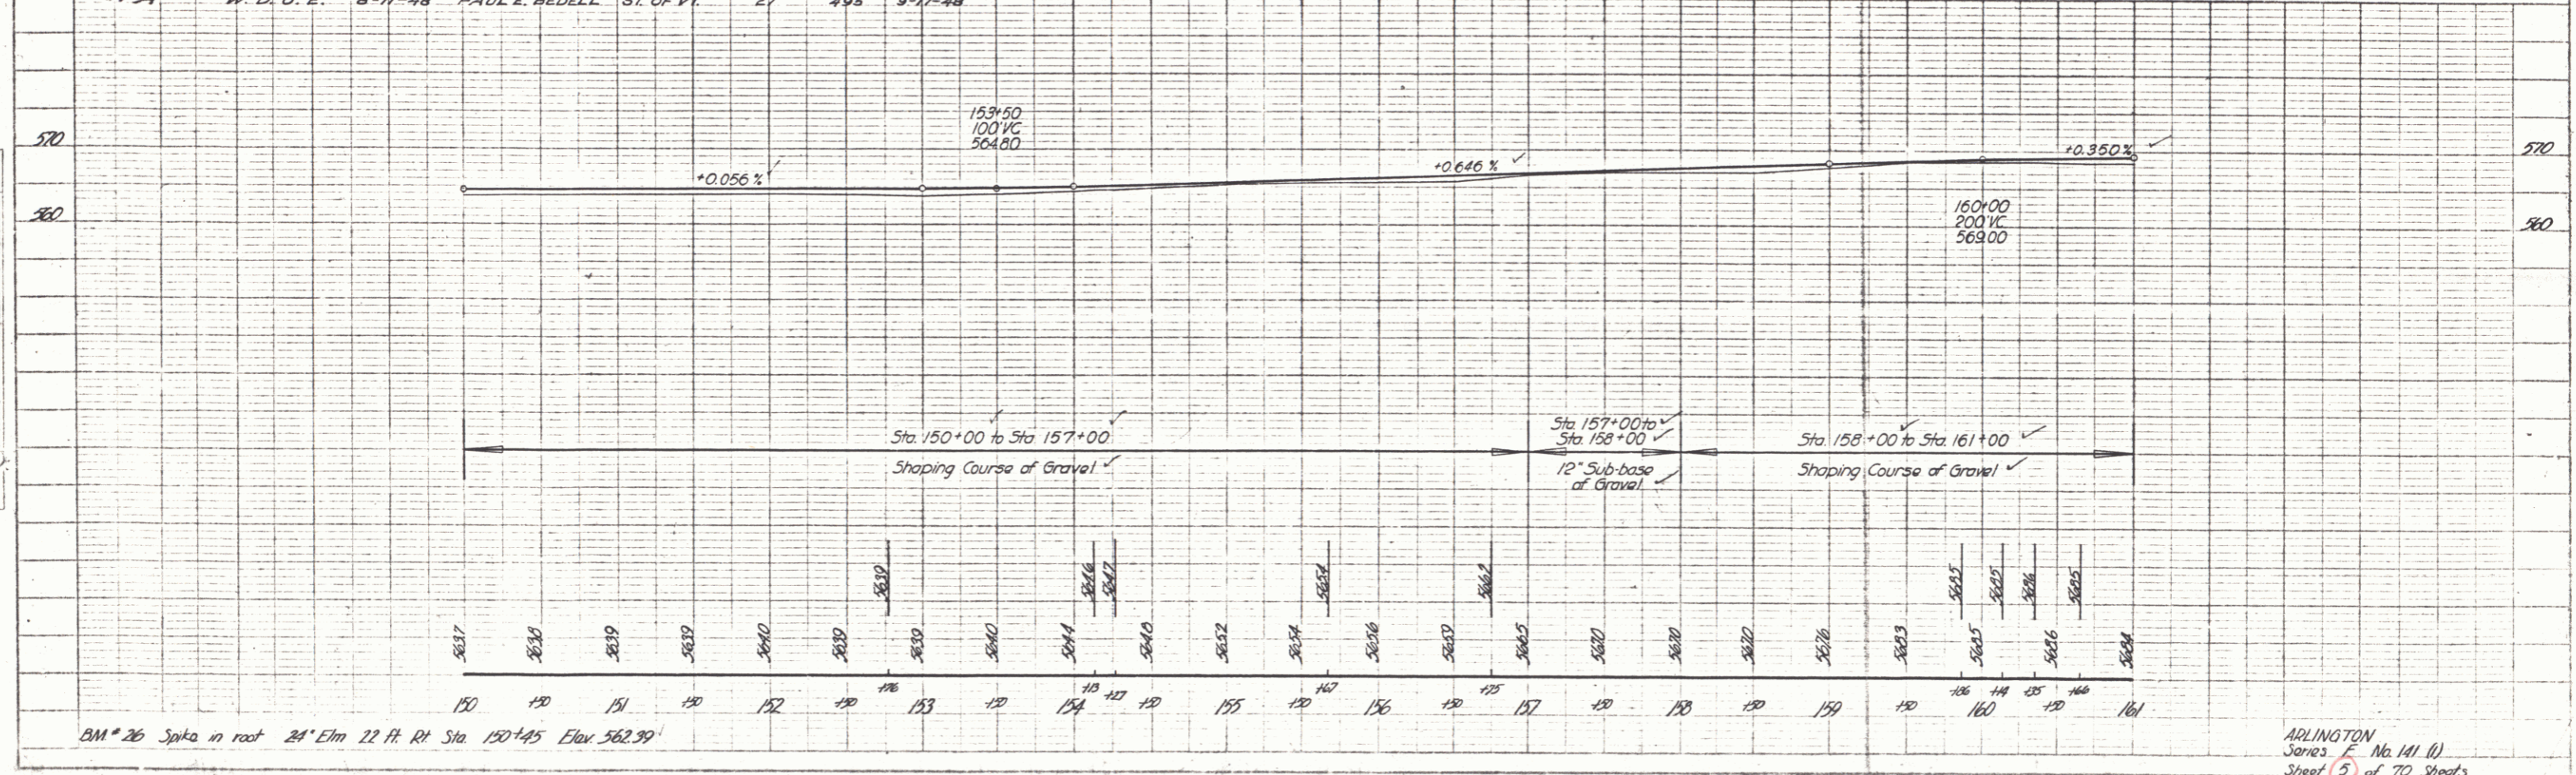

BM #26 Spike in root 24' Elm 22 ft. Rt. Sta. 150+45 Elev. 562.99'

ARLINGTON Series F No. 141 (1) Sheet 5 of 70 Sheets