


PLAN
 PROPERTY: Robert V. Jones
 ENGINEER: L. Jones
 DATE: 1947

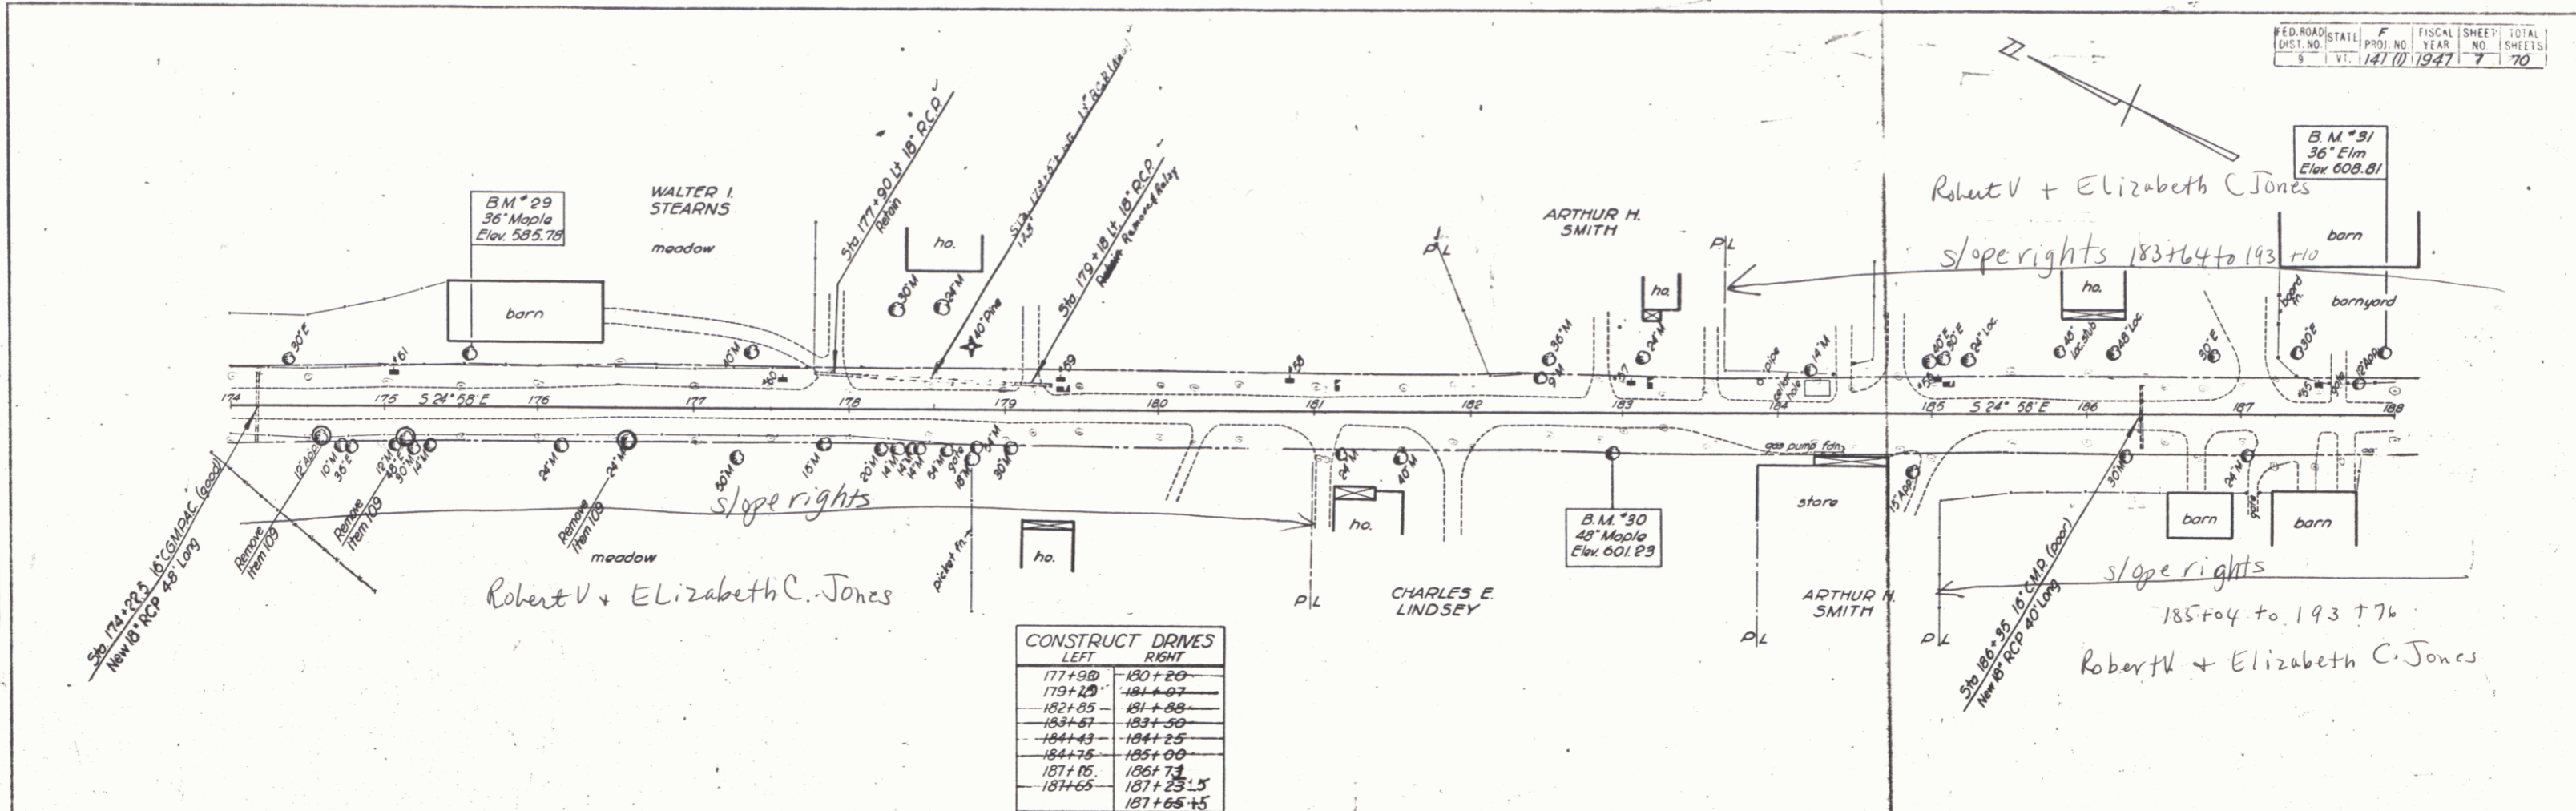

CONSTRUCT DRIVES	
LEFT	RIGHT
177+90	180+20
179+20	181+07
182+05	181+08
183+07	183+50
184+43	184+25
184+75	185+00
187+15	186+73
187+65	187+23.5
	187+65+15

PROFILE
 PROPERTY: Robert V. Jones
 ENGINEER: L. Jones
 DATE: 1947

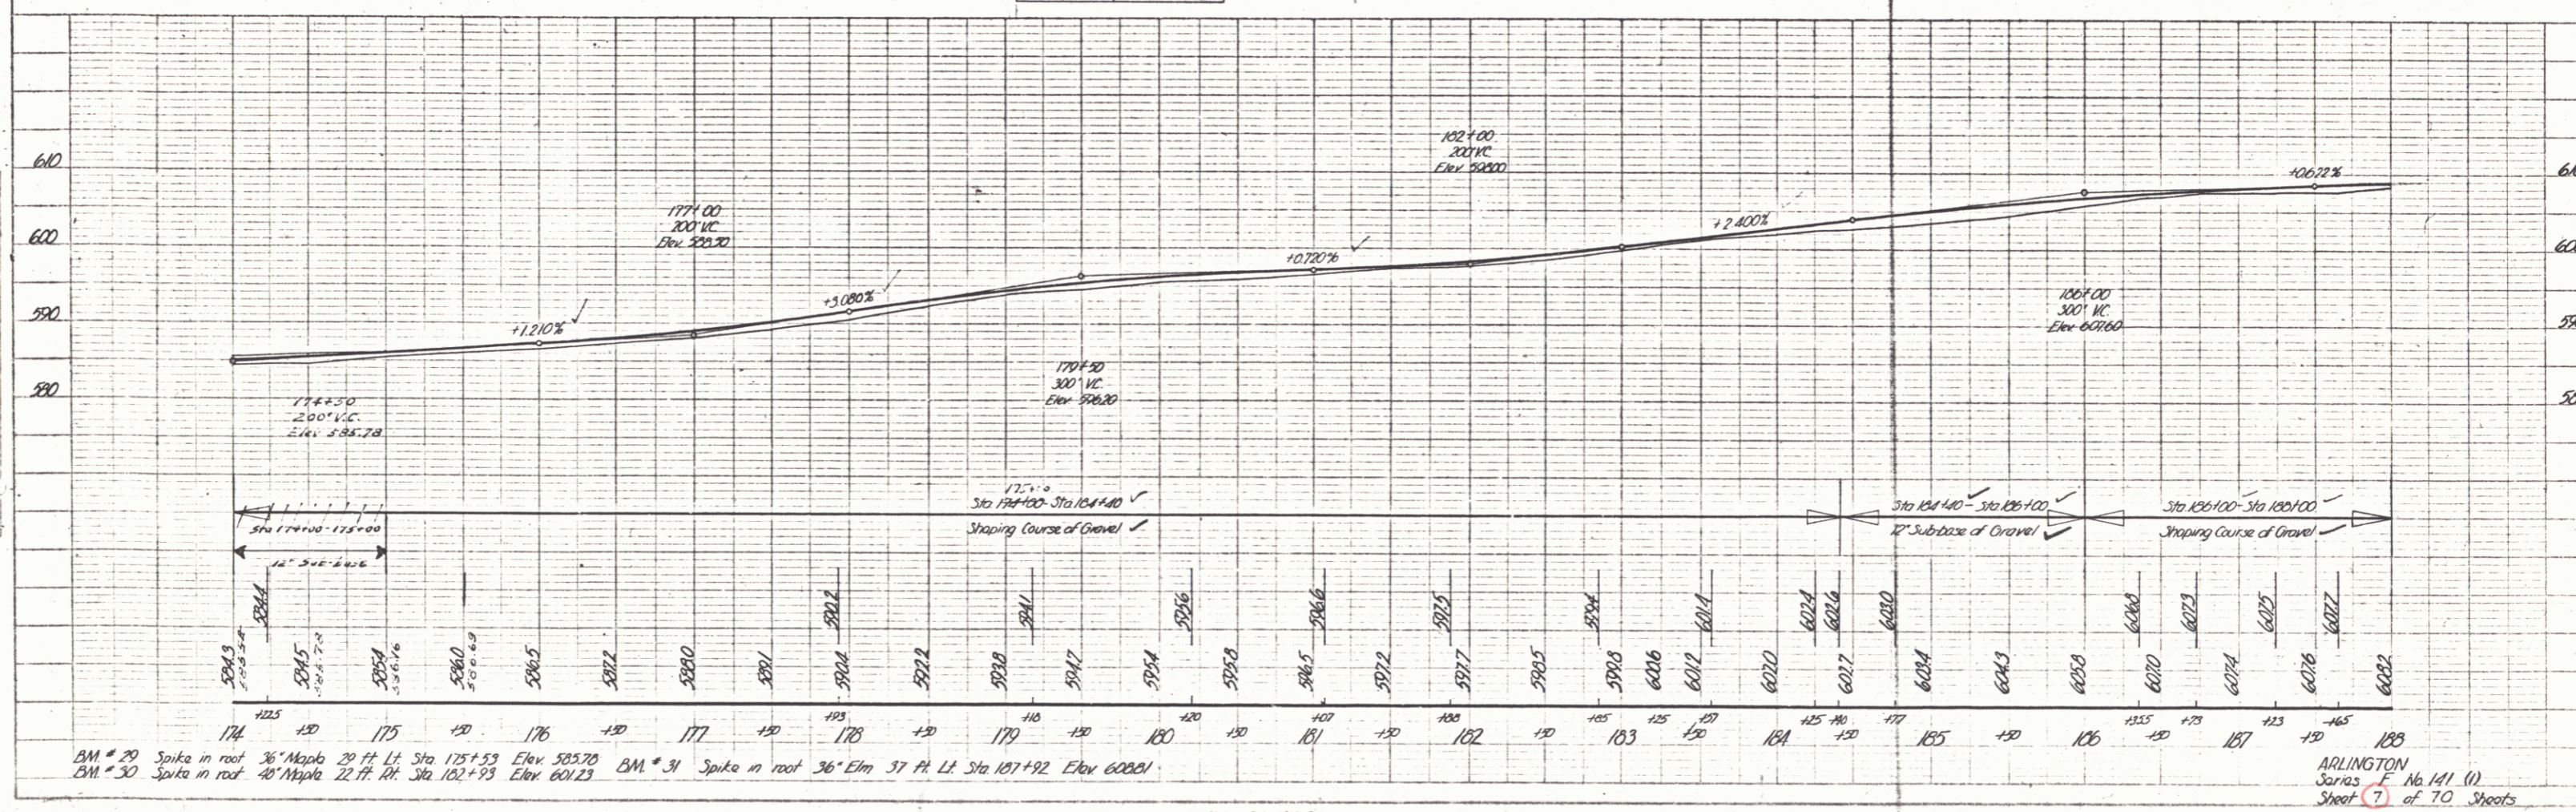


PLATE - PLAN OF THE STATE OF NEW YORK
 ENGINEER: L. Jones
 DATE: 1947