



PLAN
 SHEET NO. 1-4
 DATE 1-1-48
 DRAWN BY L. JONES
 CHECKED BY J. W. JONES

PLAN
 SHEET NO. 1-4
 DATE 1-1-48
 DRAWN BY L. JONES
 CHECKED BY J. W. JONES

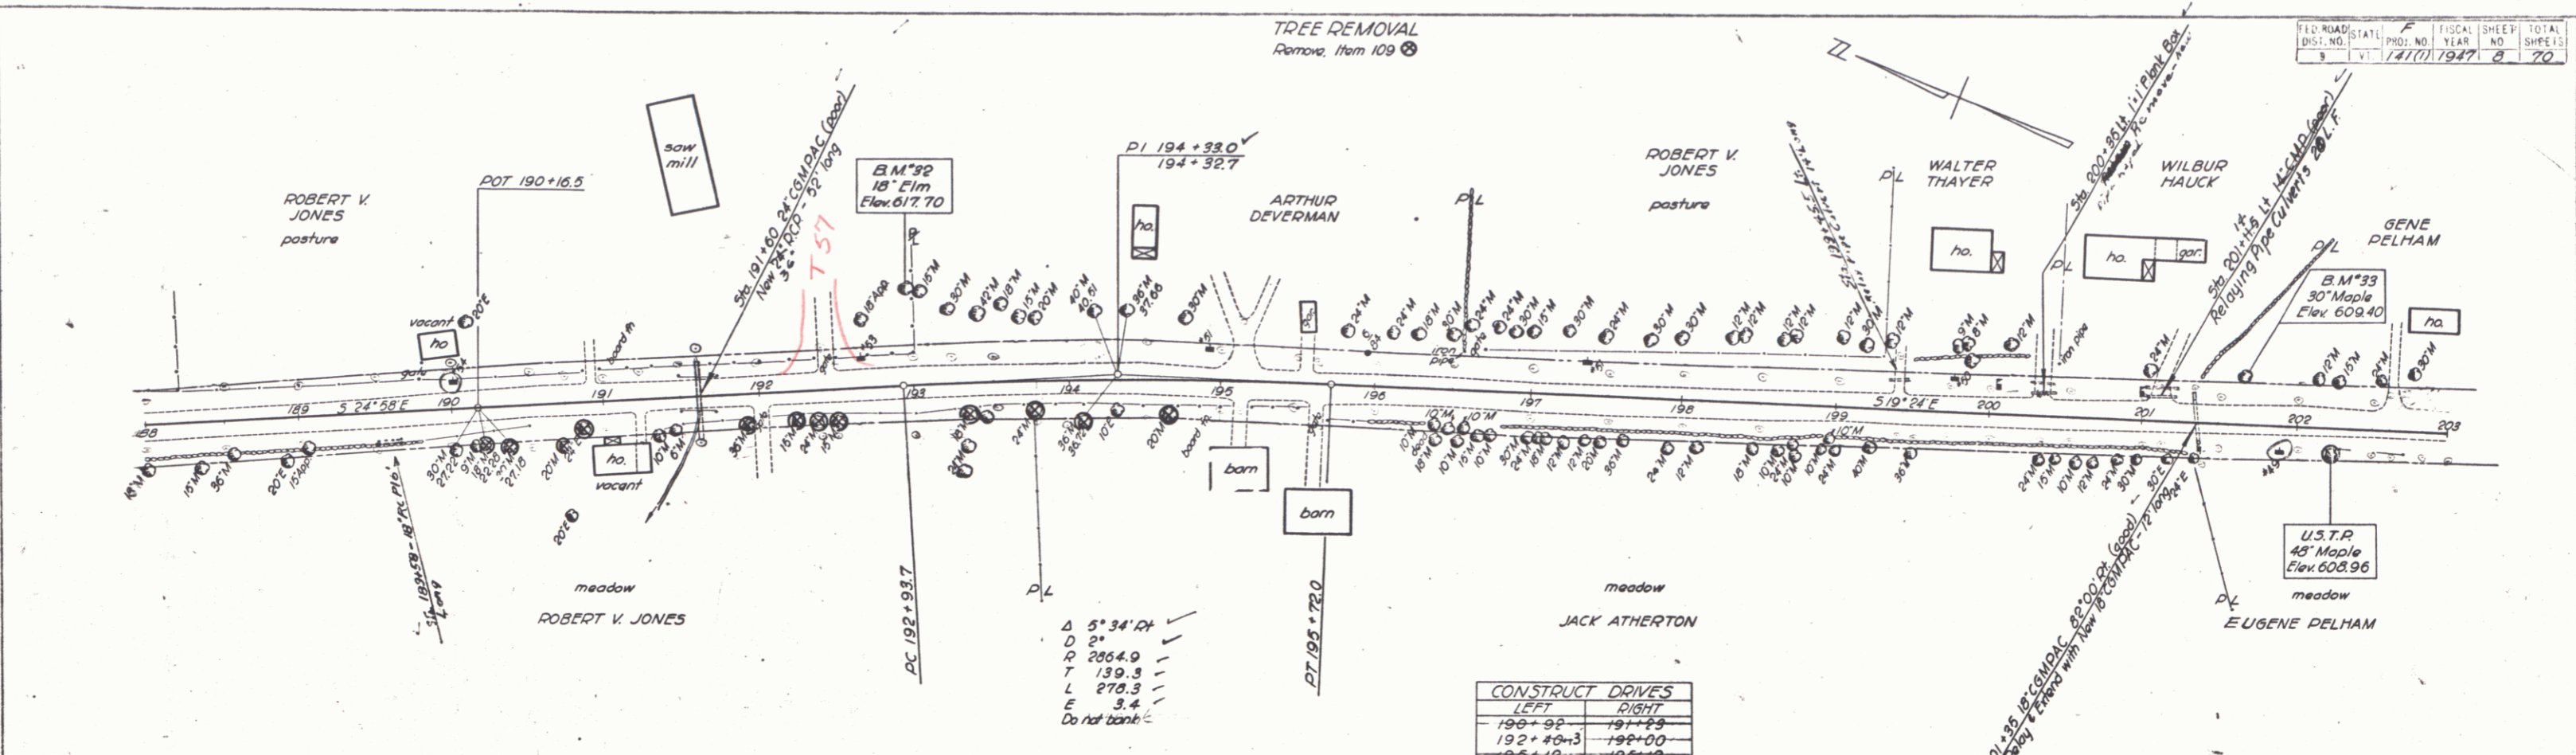

PARCEL	INSTRUMENT	DATE	GRANTOR	GRANTEE	RECORDED ARLINGTON	REMARKS
					BOOK PAGE DATE	
188	W. B. S. E.	7-27-48	ARTHUR DEVERMAN	3/4 8 FT	25 153-253 8-11-48	SCOPE RIGHTS ONLY
189	W. D. O. E.	8-11-48	JOHN ATHERTON	ST. OF VT.	27 185-186 9-3-48	SCOPE RIGHTS STA. 193+75-195+0

CONSTRUCT DRIVES	
LEFT	RIGHT
190+92	191+89
192+40+3	192+00
195+12	195+12
195+55	195+62
199+40	199+53
200+34+3	196+85
201+13+2	
202+66	

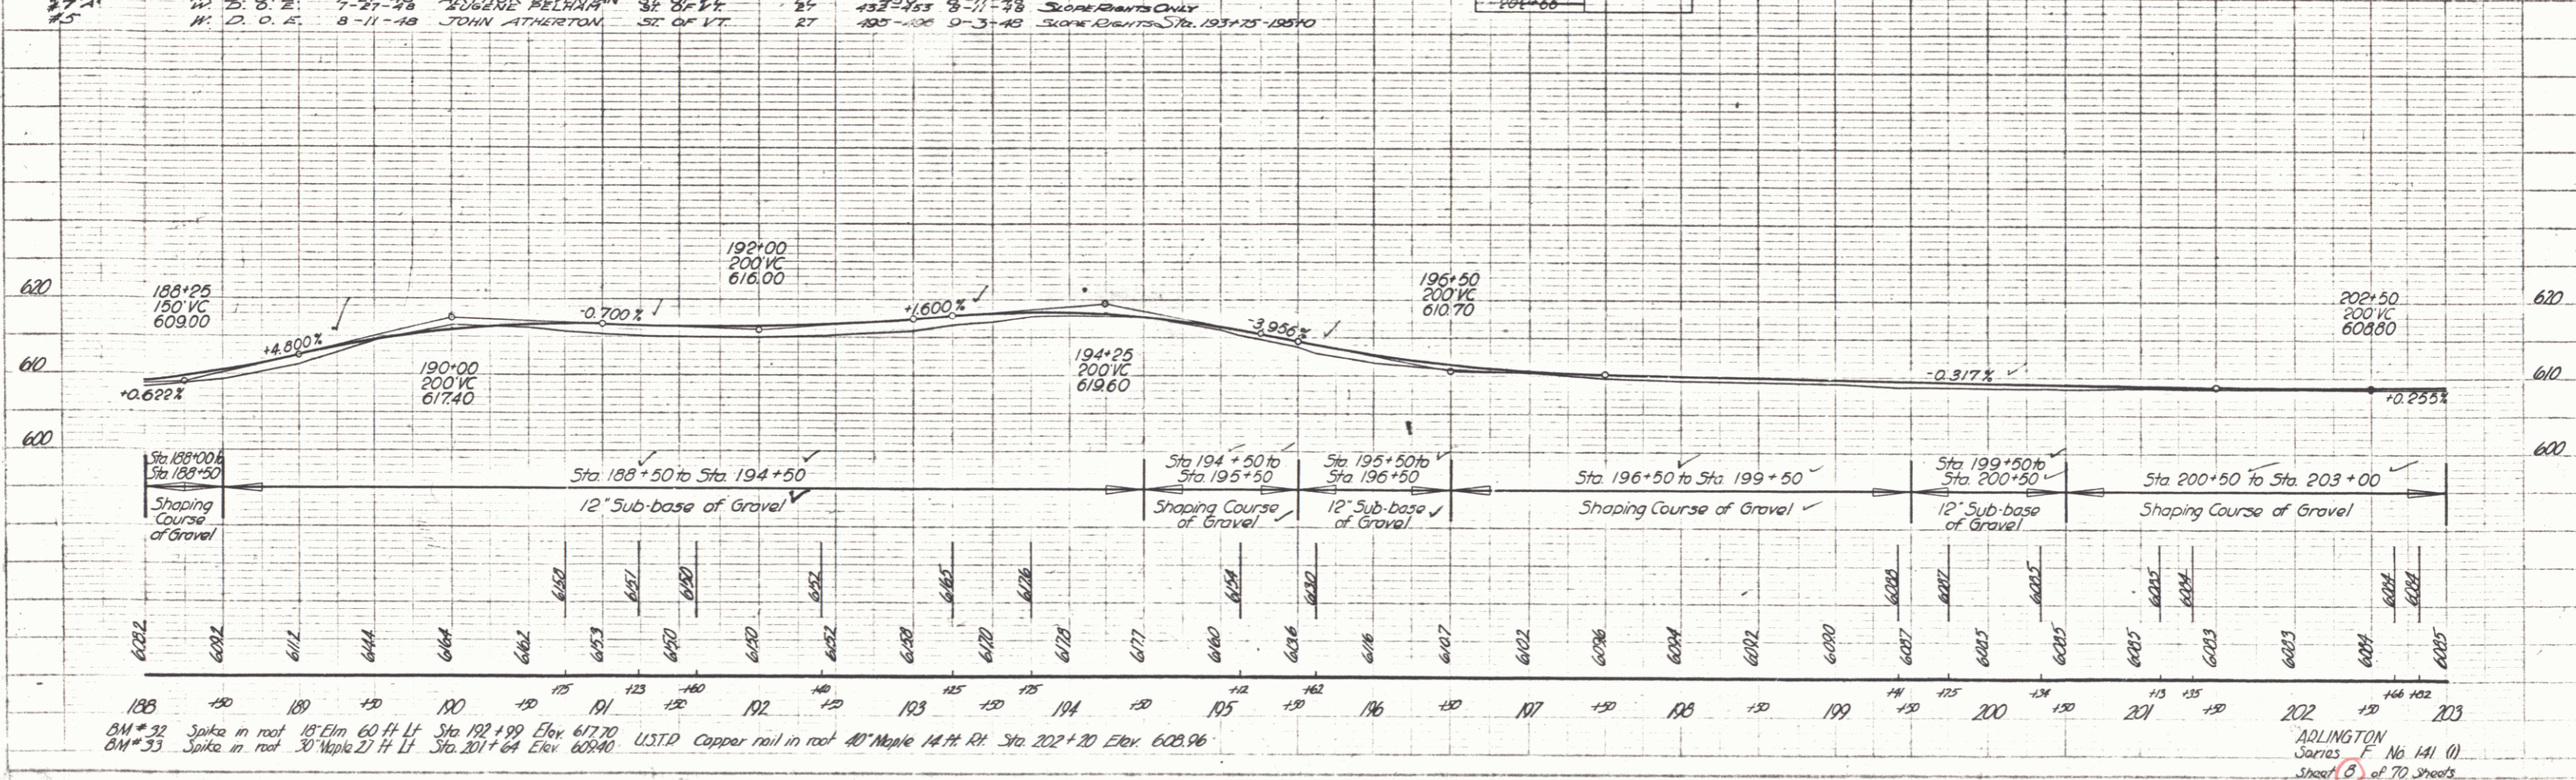

BM#32 Spike in roof 18' Elm 60 ft Lt Sta 192+99 Elev 617.70
 BM#33 Spike in roof 30' Maple 27 ft Lt Sta 201+64 Elev 608.90
 U.S.T.P. Copper nail in roof 40' Maple 14 ft Rt Sta 202+20 Elev 608.96

ARLINGTON
 Series F No 141 (1)
 Sheet 8 of 70 Sheets