



FED. ROAD DIST. NO.	STATE	FISCAL YEAR	SHEET NO.	TOTAL SHEETS
9	VI.	1947	9	70

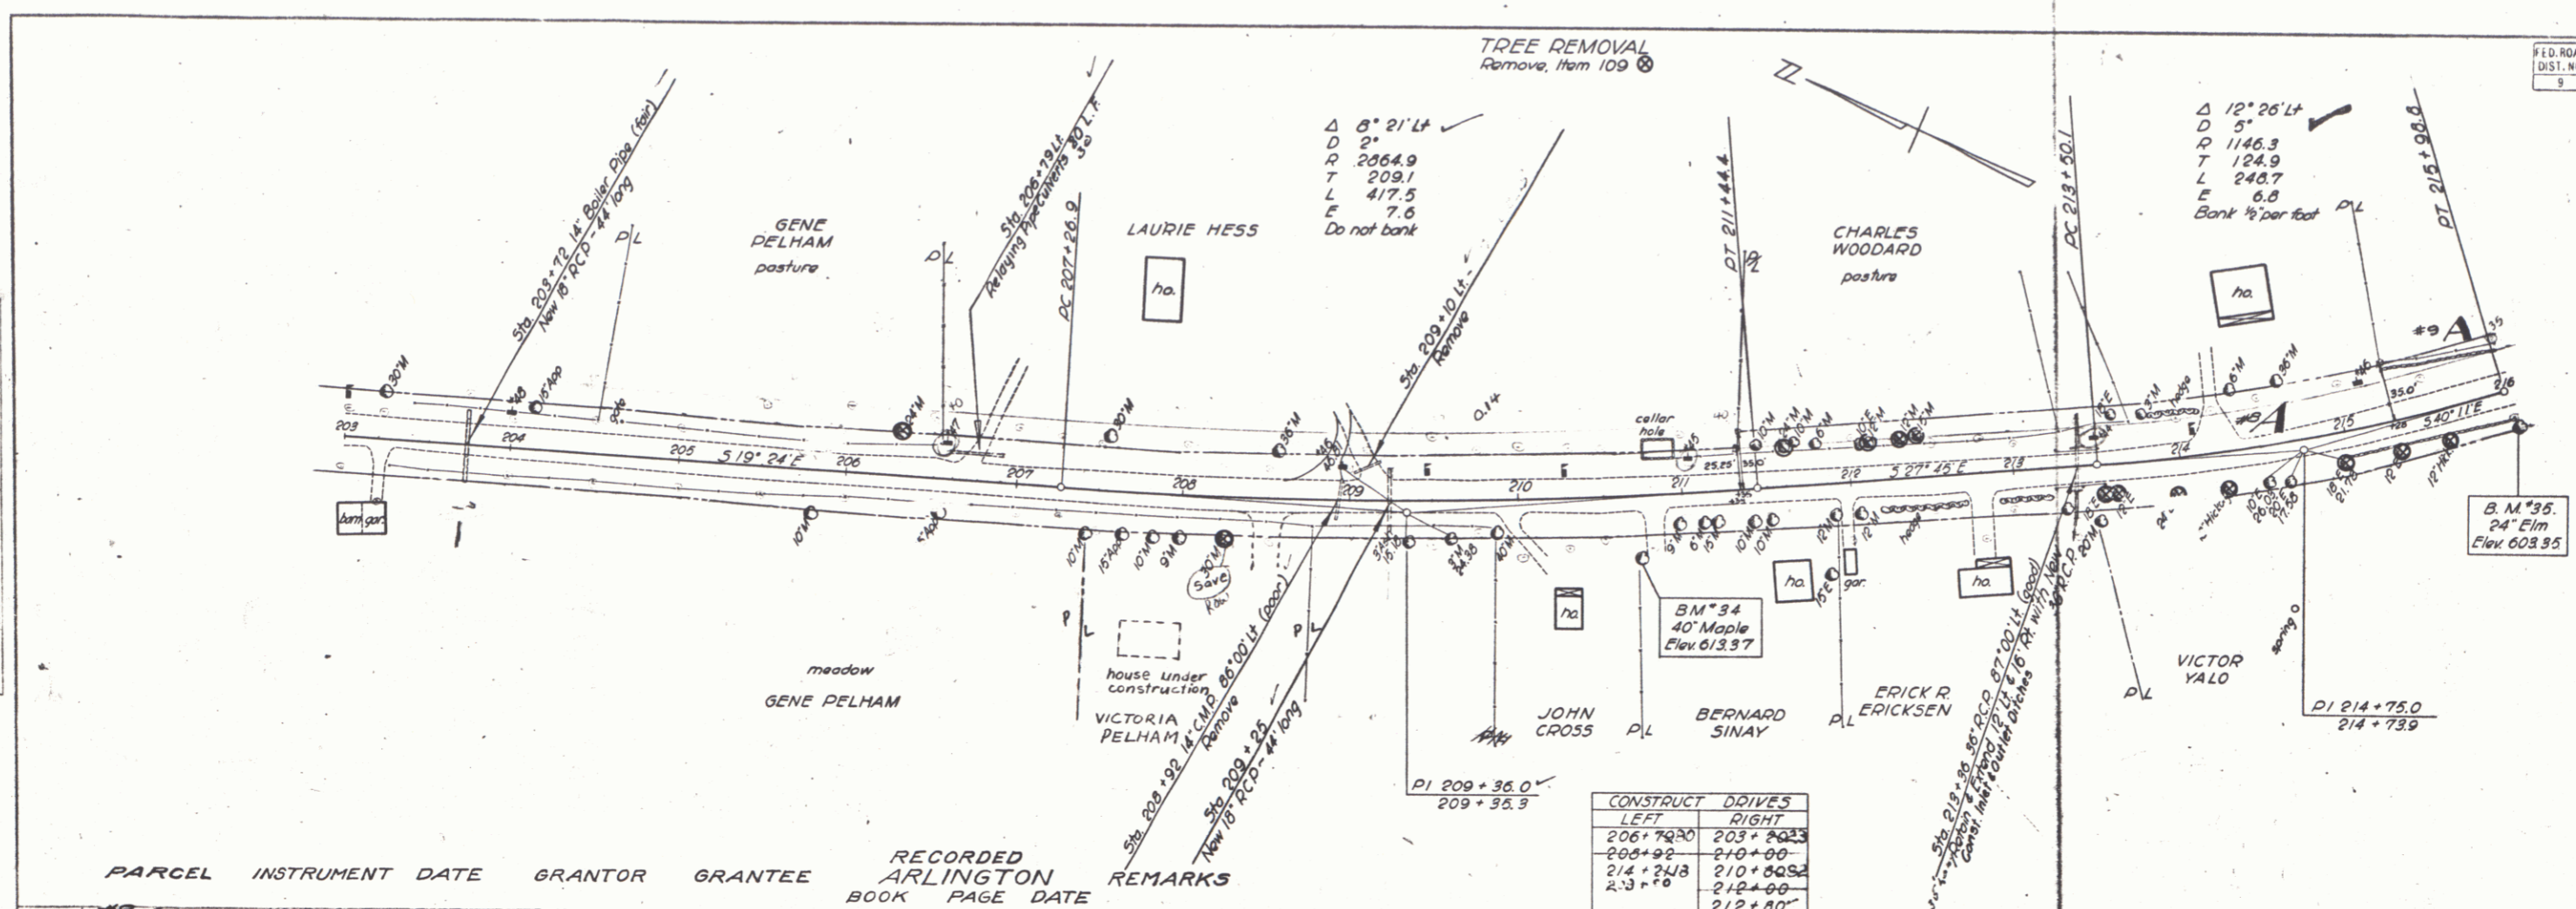

CONSTRUCT DIVES	
LEFT	RIGHT
206+79.20	203+20.23
206+92	210+00
214+24.8	210+80.52
213+7.8	212+00
	212+80
	208+64
	209+97
	211+28
	213+88

PARCEL	INSTRUMENT DATE	GRANTOR	GRANTEE	RECORDED ARLINGTON BOOK PAGE DATE	REMARKS
W.D.D.E.	7-27-48	CHARLES WOODARD	ST. OF VI.	27 146-447 8-11-48	

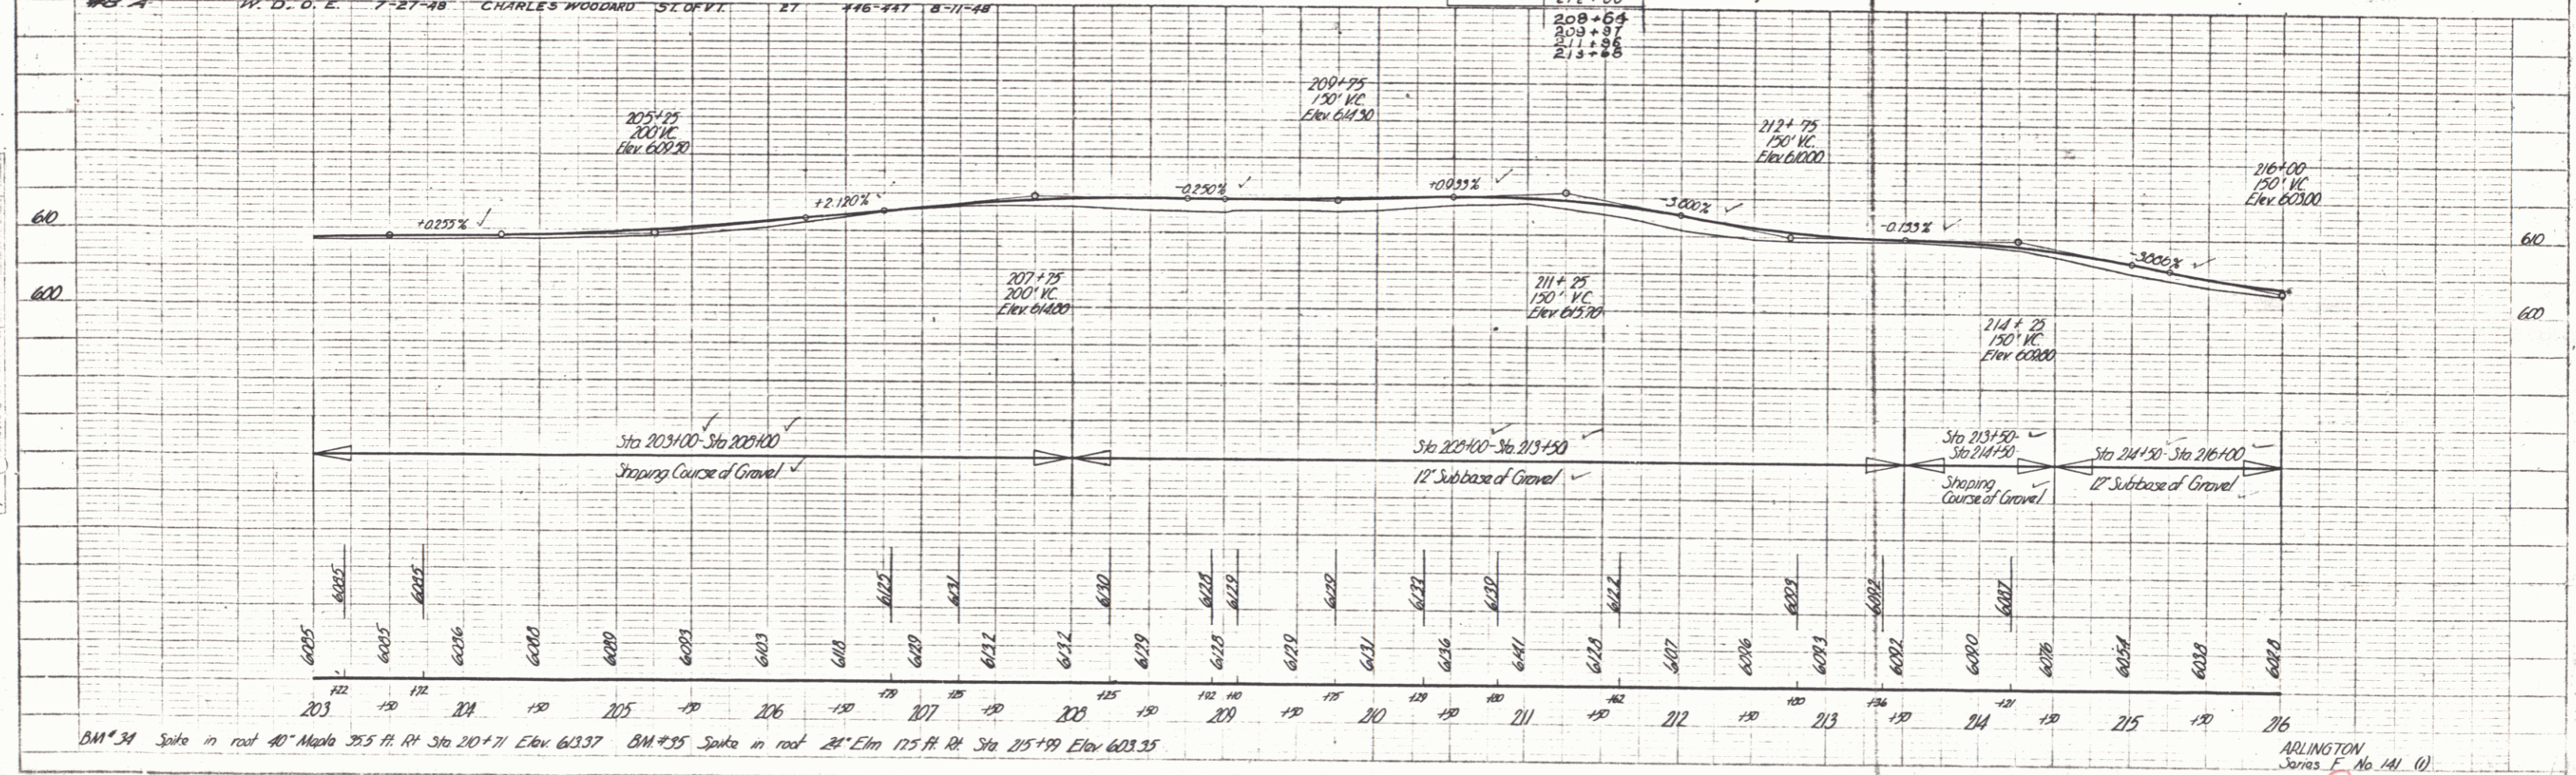

BM*34 Spike in root 40' Maple 35.5 ft. Rt Sta 20+71 Elev 613.37 BM*35 Spike in root 24' Elm 17.5 ft. Rt Sta 215+99 Elev 603.95

ARLINGTON Series F No. 141 (1) Sheet 9 of 70 Sheets

PLAN
DATE
BY
CHECKED
DATE

Scale
1" = 40'
1" = 100'

PLANS FOR THE...
N.E. & S.W. CORNERS