


CONSTRUCT DRIVES

11	11
219+10	219+10
Side Slope	220+10
1:2.5	1:1.5

TREE REMOVAL
 Item 109

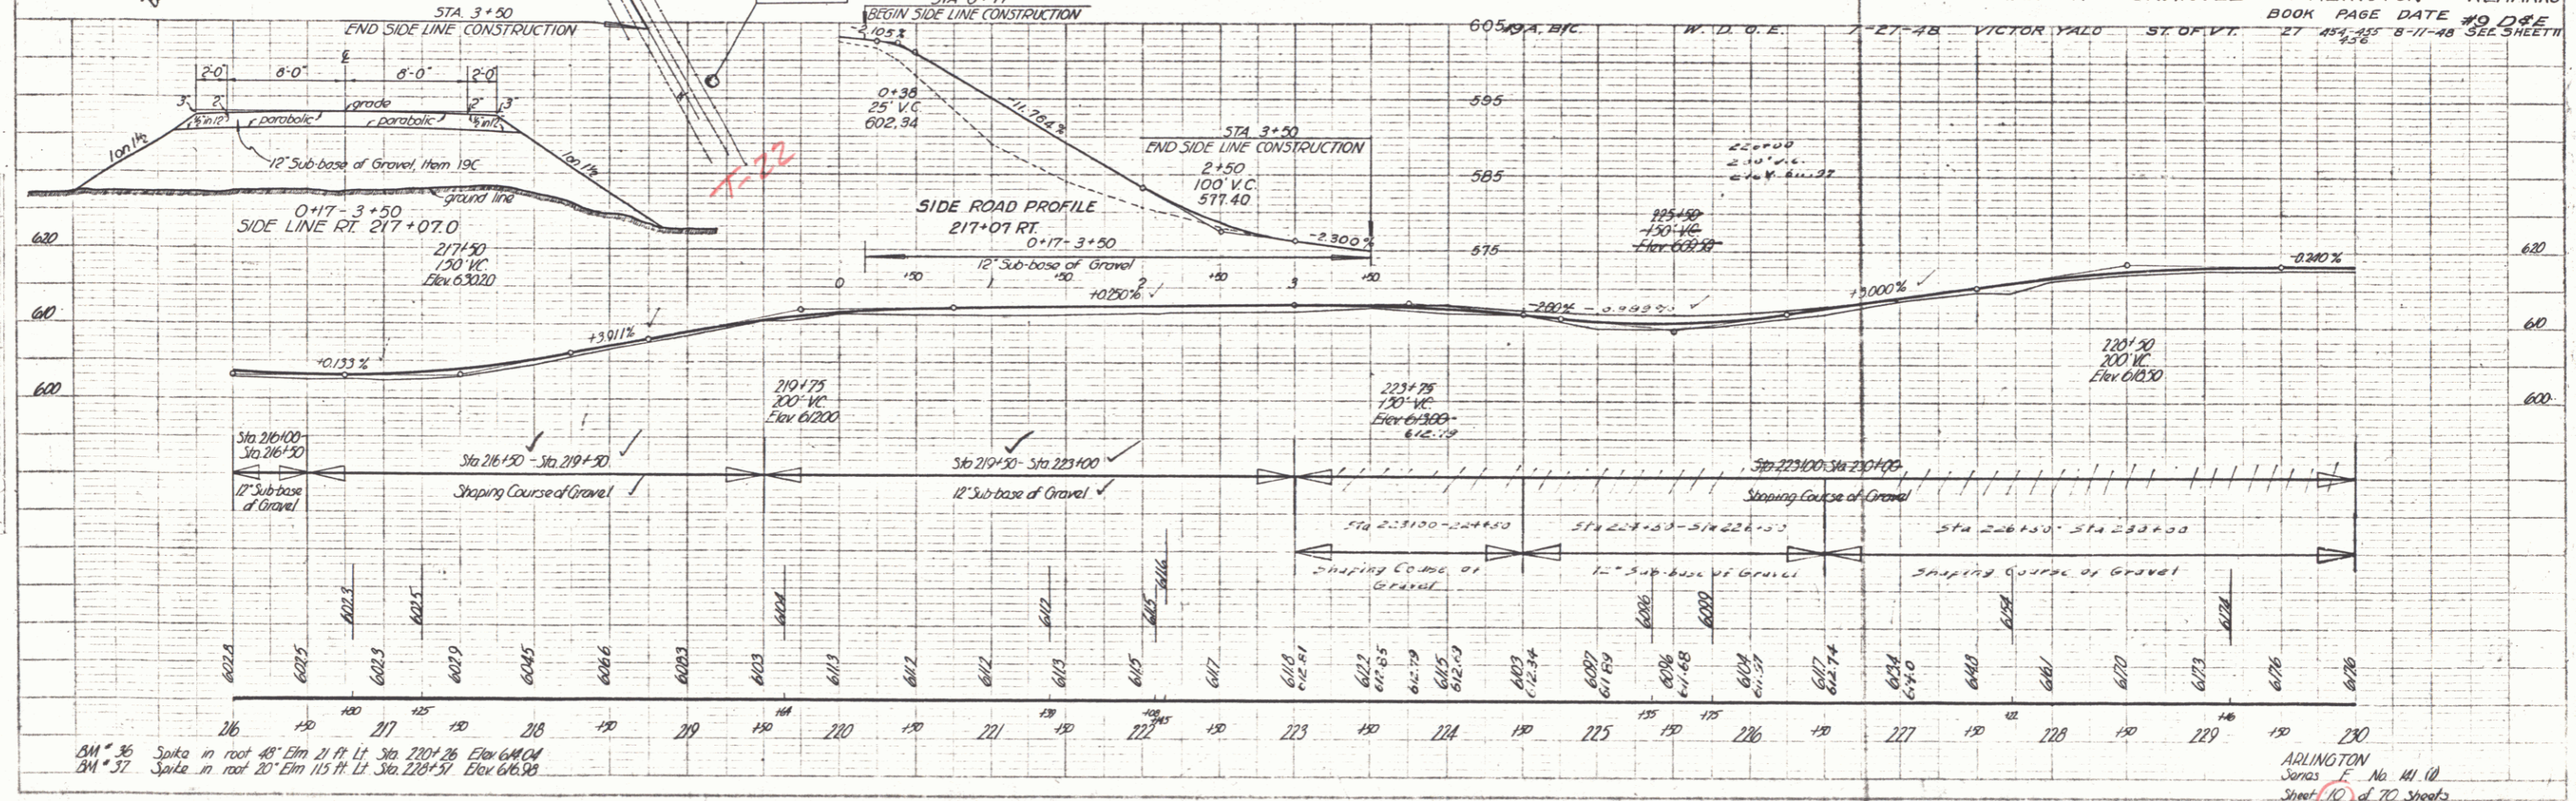

PLAN
 DATE: 1/10/27
 DRAWN BY: J. L. LAMM
 CHECKED BY: J. L. LAMM

PROFILE
 DATE: 1/10/27
 DRAWN BY: J. L. LAMM
 CHECKED BY: J. L. LAMM