


PARCEL	INSTRUMENT	DATE	GRANTOR	GRANTEE	RECORDED	ARLINGTON	REMARKS
#11 A & B	W. D. O. E.	7-27-48	CHARLES DYER	ST. OF VT.	27	453-454	8-11-48
#12 A	W. D. O. E.	8-13-48	WINFIELD SCOTT	ST. OF VT.	27	493-494	9-17-48

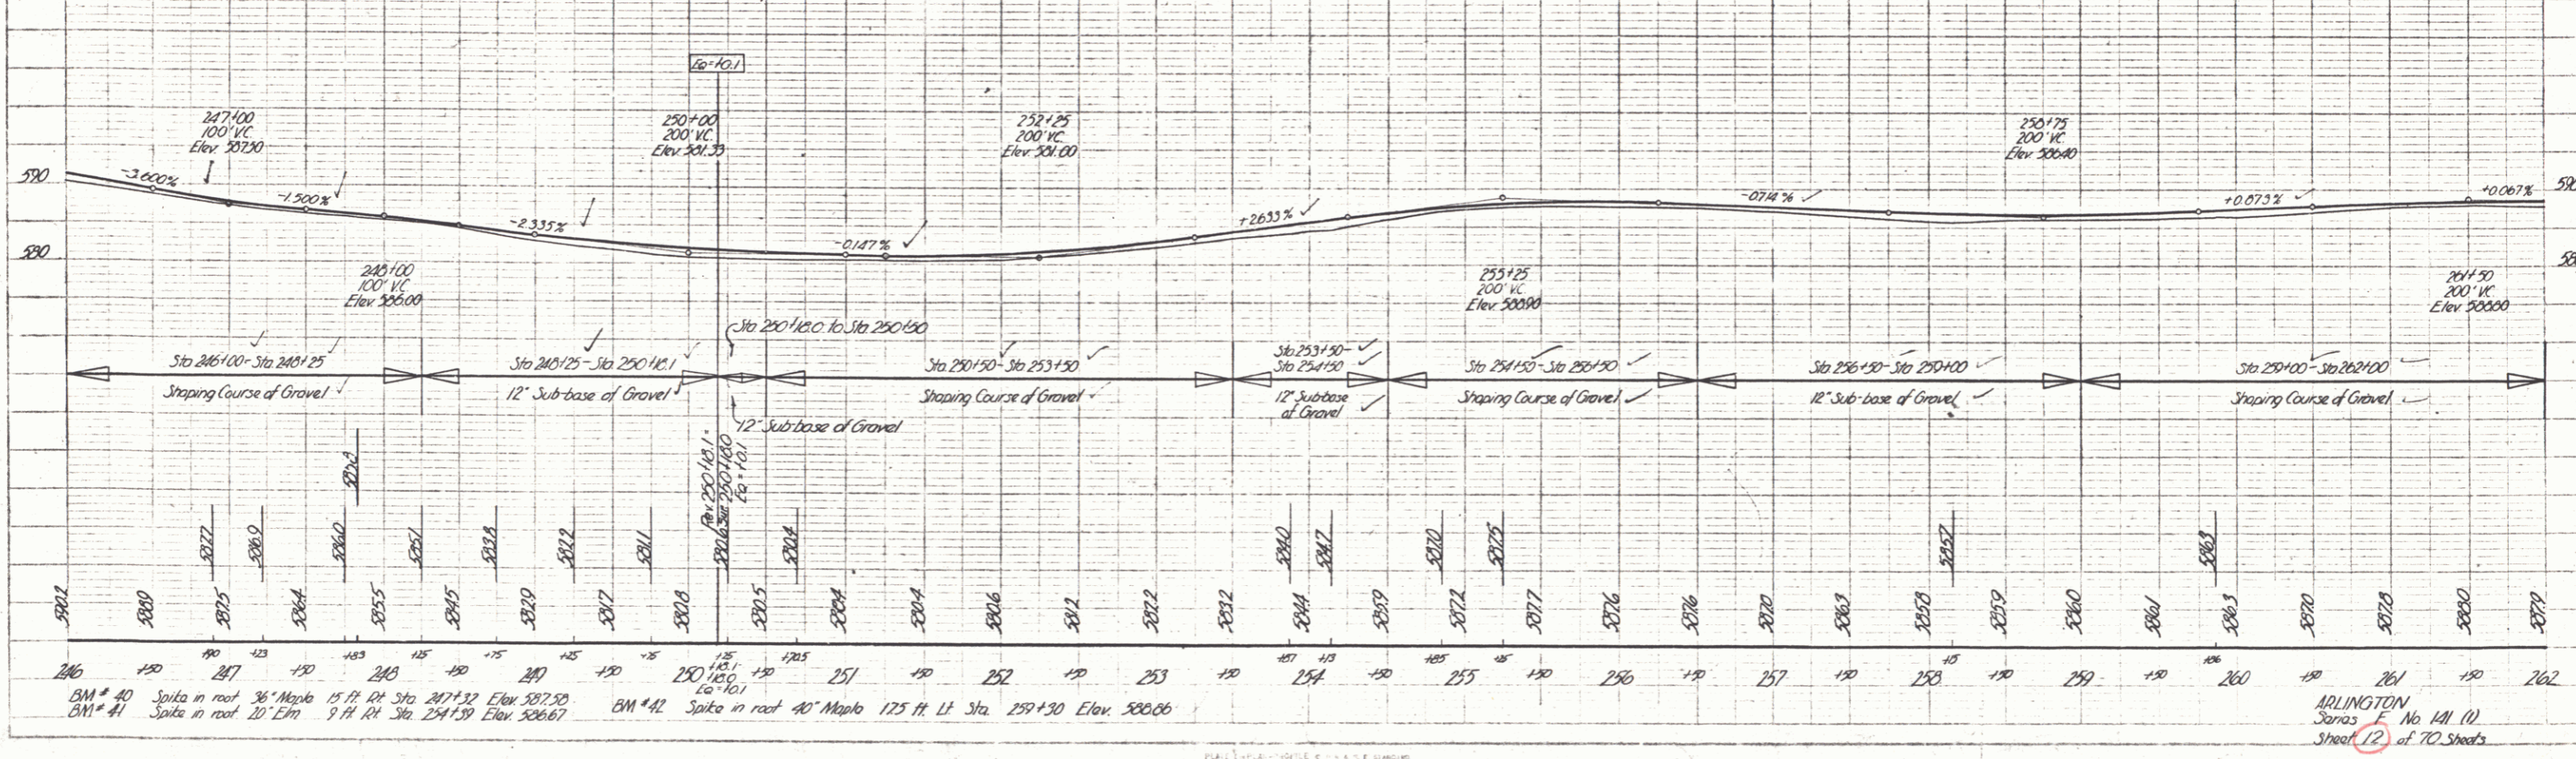

PLAN
 SCALE: HORIZ. 1" = 40'
 VERT. 1" = 10'
 DATE: 12/20/47
 DRAWN BY: [Signature]

PROFILE
 SCALE: HORIZ. 1" = 40'
 VERT. 1" = 10'
 DATE: 12/20/47
 DRAWN BY: [Signature]