
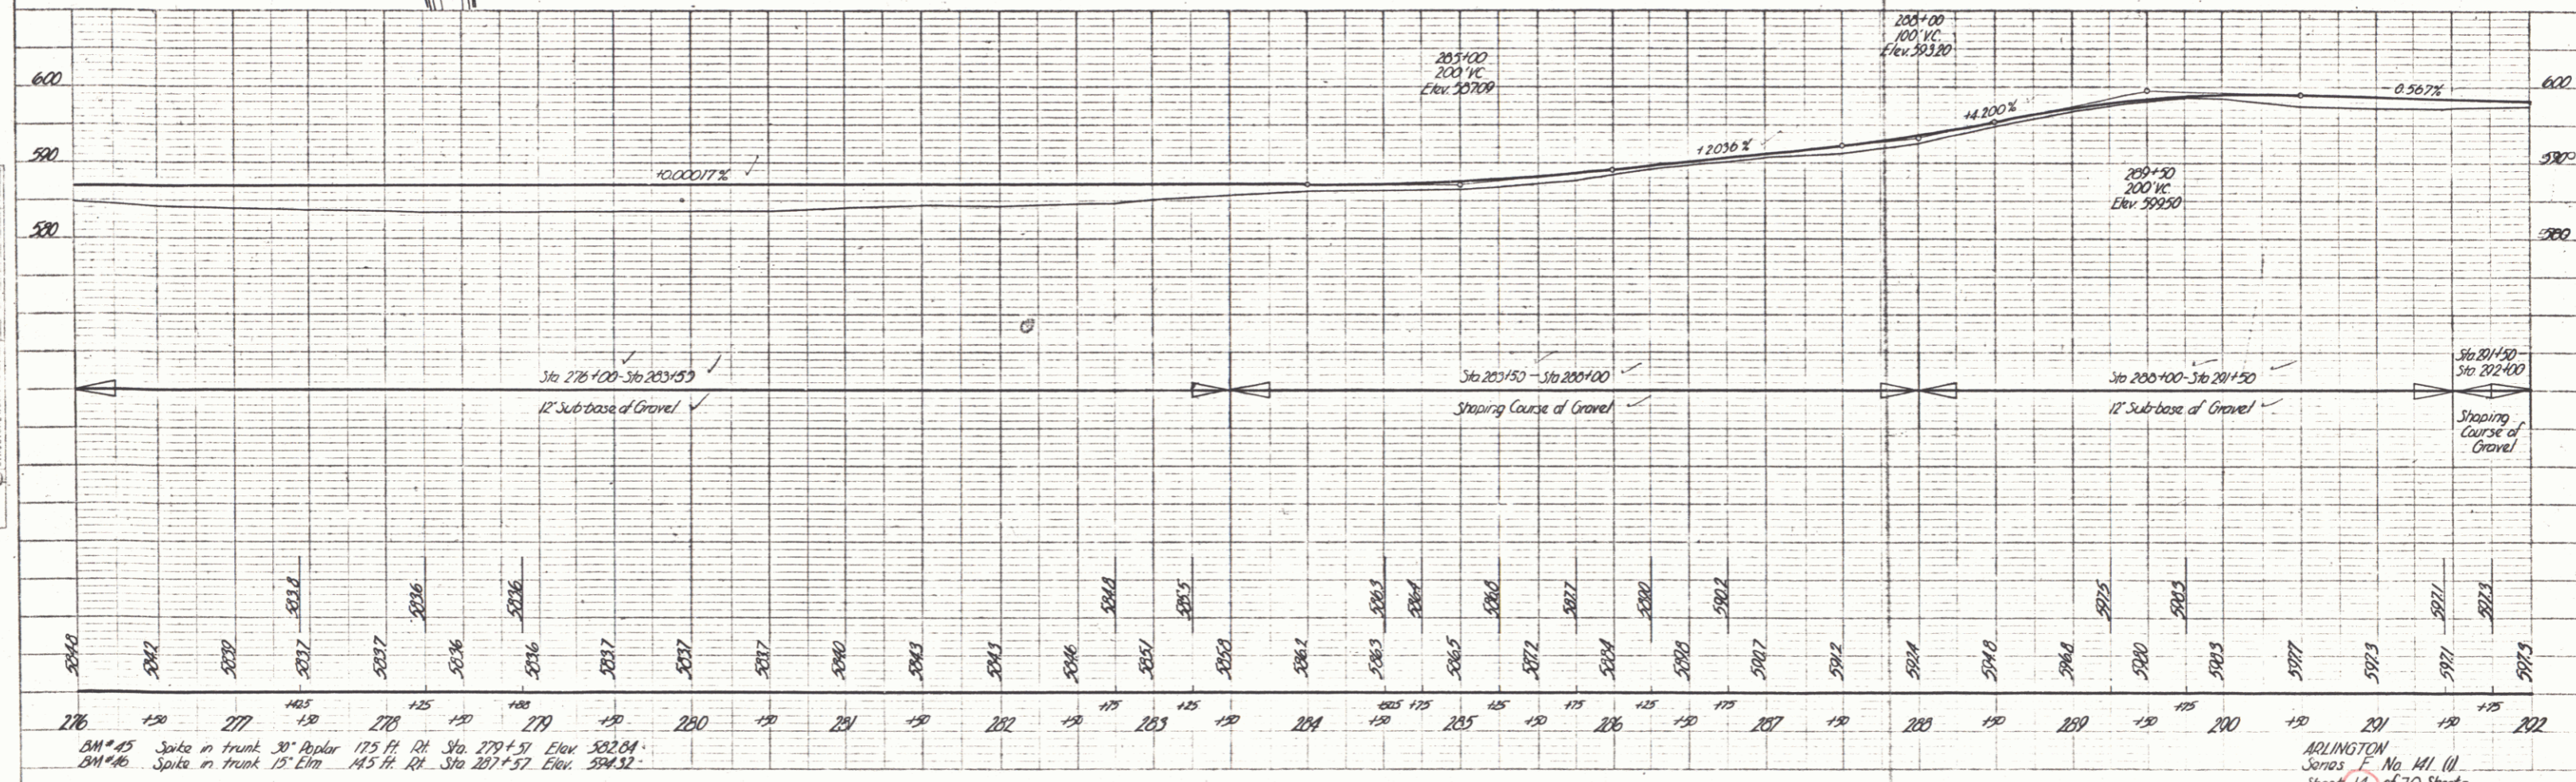


STATE	FISCAL YEAR	SHEET NO.	TOTAL SHEETS
VT	1947	74	70

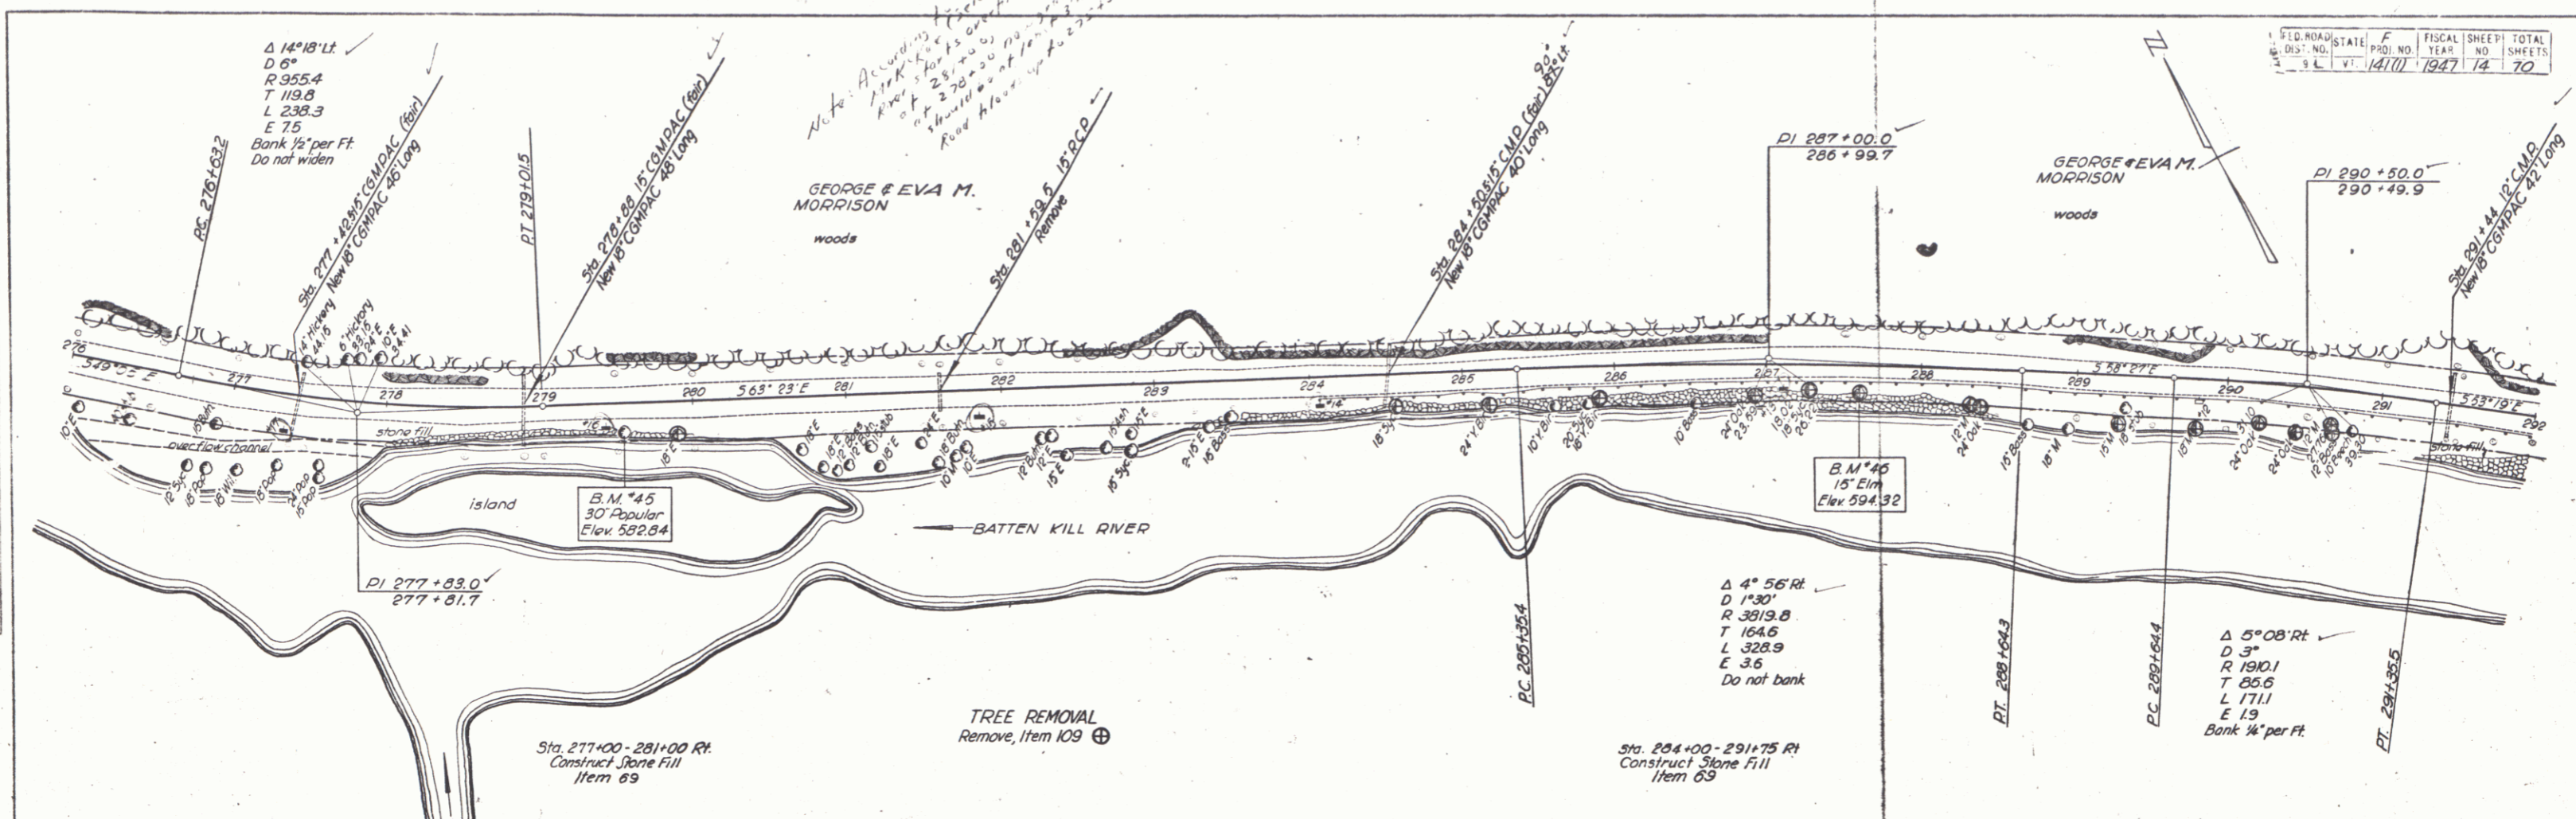

PLAN
 DATE: 11-17-46
 DRAWN BY: L. J. LAMON
 CHECKED BY: L. J. LAMON

PROFILE
 DATE: 11-17-46
 DRAWN BY: L. J. LAMON
 CHECKED BY: L. J. LAMON

B.M. #45 Spike in trunk 30" Poplar 175 Ft. Rt. Sta. 277+57 Elev. 582.84
 B.M. #46 Spike in trunk 15" Elm 145 Ft. Rt. Sta. 287+57 Elev. 594.32

ARLINGTON
 Series E No. 141 (I)
 Sheet 14 of 10 Sheets

PLATE 1 - PLAN - PROFILE & P.A.S. & STANDARDS
 REVISIONS
 N.E. CO. NO. 540-10