


CONSTRUCT DRIVES	
LEFT	RIGHT
311+50	315+00
317+60	317+50
317+65	317+30
316+75	

TREE REMOVAL	PARCEL INSTRUMENT DATE	GRANTOR	GRANTEE	RECORDED ARLINGTON	BOOK	PAGE	DATE	REMARKS
Remove Item 109	7-27-48	G. H. LATHROP	ST. OVY	27	449-450	5-11-48	SEE SHEET 15	

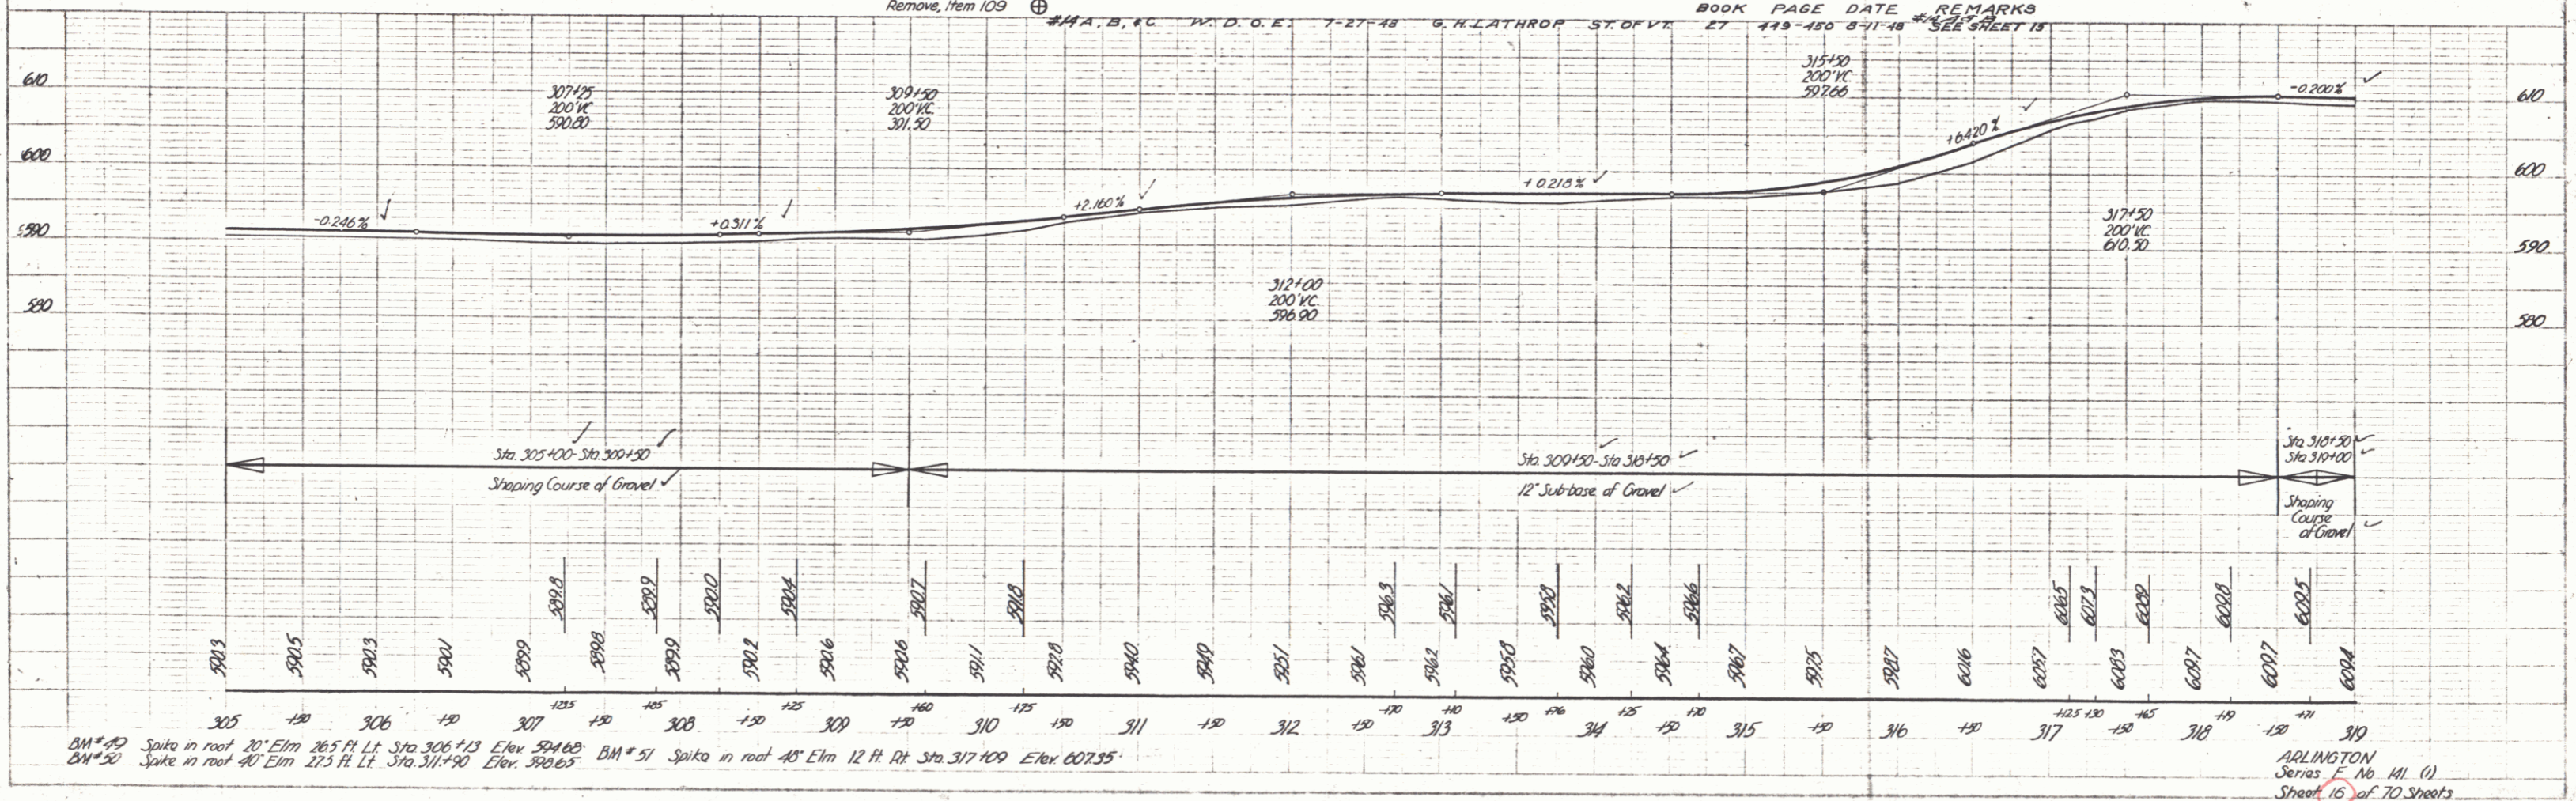

B.M. #49 Spike in root 20" Elm 26.5 Ft Lt Sta 306+13 Elev 594.68
 B.M. #50 Spike in root 40" Elm 27.5 Ft Lt Sta 311+90 Elev 598.65
 B.M. #51 Spike in root 48" Elm 12 Ft Rt Sta 317+09 Elev 607.35