

OF SHEETS

CROSS-SECTION OF IMPROVEMENT AND WIDENING TABLES
 PROFILE
 STATION STA 96104
 STRUCTURE SHEET

- 28 PIPE CULVERTS
- 30 GUARD RAIL
- 30A DRAINAGE STRUCTURES
- 40 BARRICADES, SIGNS & LIGHTS
- 41 ROUNDING OF SLOPES

STRUCTURE SHEETS APPROVED BY THE CHIEF VERMONT STATE DEPARTMENT OF HIGHWAYS

- 28 APRIL 26, 1941
- 30 NOVEMBER 10, 1947
- 30A APRIL 19, 1941
- 40 DECEMBER 18, 1945

STATE OF VERMONT
 STATE HIGHWAY DEPARTMENT


PLAN AND PROFILE OF PROPOSED
 STATE HIGHWAY
 SECONDARY PROJECT.

TOWNS SO. HERO-GRAND ISLE


ROUTE F 3
 ROOSEVELT FERRY ROAD Pin#99R683

BEGINNING AT THE INTERSECTION OF ROUTE US 2 AND ROUTE F 3 IN THE TOWN OF SOUTH HERO AND EXTENDING NORTHWESTERLY 12042.5 FT. LENGTH OF PROJECT 12042.5FT=2.281 MILES

FED. ROAD DIST. NO.	STATE	PROJ. NO.	SHEET NO.	TOTAL SHEETS
9	Vt.	67(2)	7	37

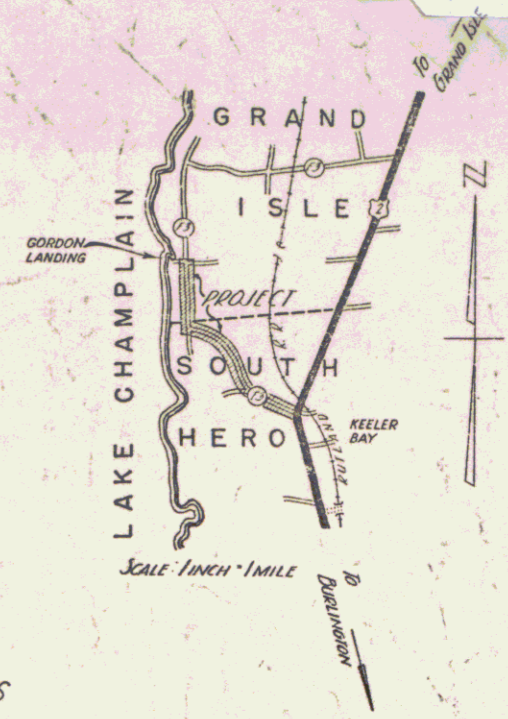

RECORD PLANS
 Prepared by A. W. Lane
 Resident Engineer F. W. Badger

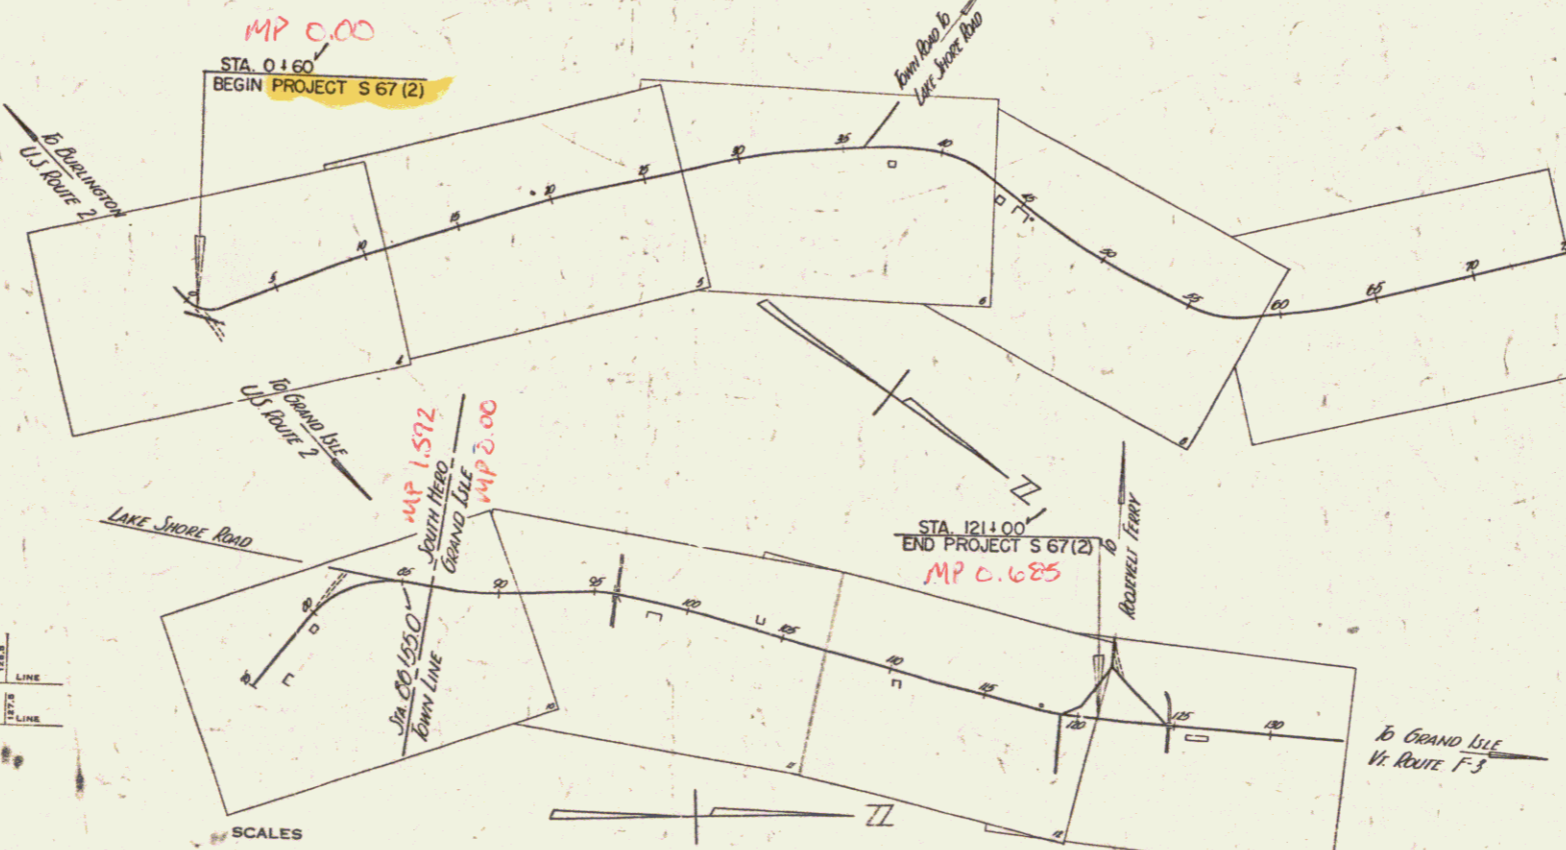

RIGHT-OF-WAY DIVISION
 TOWN FILE
 PERPETUAL.

Town of VT 314
 (To Be Returned To R.O.W. Division)

APPROVED: 14 Feb. 1948
 H. E. August
 COMMISSIONER OF HIGHWAYS

SUBMITTED BY ORDER OF THE STATE HIGHWAY BOARD

RECOMMENDED FOR APPROVAL
 DISTRICT ENGINEER
 PUBLIC ROADS ADMINISTRATION
 FEDERAL WORKS AGENCY

THESE PLANS ARE SUBJECT TO SUCH REVISIONS AS MAY BE REQUIRED BY THE PUBLIC ROADS ADMINISTRATION OR THE COMMISSIONER OF HIGHWAYS.
 CONSTRUCTION IS TO BE CARRIED ON IN ACCORDANCE WITH THE PLANS AND THE STANDARD ROAD AND BRIDGE SPECIFICATIONS OF 1936, AS APPROVED DECEMBER 29TH, 1936 BY THE PUBLIC ROADS ADMINISTRATION, INCLUDING ALL SUBSEQUENT APPROVED REVISIONS AND SUCH REVISED SPECIFICATIONS AND SPECIAL PROVISIONS AS ARE SUBMITTED WITH THE PLANS.

APPROVED: 13 Feb. 1948 Highway Engineer
 APPROVED: 14 Feb. 1948 District Highway Commissioner
 SERIES 5 No. 67(2) FILED SHEET 1 OF 37

4314

S

GROUND ELEVATION DATUM LINE
 GRADE ELEVATION DATUM LINE

CURVE DATA

DEFLECTION ANGLE	Δ
DEGREE OF CURVE	D
RADIUS OF CURVE	R
TANGENT DISTANCE	T
LENGTH OF CURVE	L
EXTERNAL DISTANCE	E
POINT OF INTERSECTION	P. I.
POINT OF CURVE	P. C.
POINT OF TANGENT	P. T.
POINT ON TANGENT	P. O. T.

SOUTH HERO-GRAND ISLE S 67(2)
 RECORD PLANS
 Contractor - R. F. Carpenter
 Construction Completed Oct. 22, 1948

SCALES

TITLE	1" = 500'
TYPICAL	1" = 2'
PLAN	1" = 50'
PROFILE HORIZONTAL	1" = 50'
PROFILE VERTICAL	1" = 10'
CROSS SECTIONS	1" = 5'

314/100 P.M.L.

314