


INDEX OF SHEETS

SHEET NO	
1	TITLE SHEET
2	TYPICAL CROSS-SECTION OF IMPROVEMENT (TACK COAT - TYPE X)
3	QUANTITY SHEET
4	ITEM DETAIL AND DRAINAGE SHEET
5-7	EARTHWORK SHEETS
8	A-61 (SLOPES IN SOLID ROCK EXCAVATION)
9	B-1 (BANKING TABLES)
10	B-5 (TYPICAL SLOPE GRADING)
11	B-10 (EMBANKMENT ON A SLOPE)
12	B-11 (USE OF UNDERDRAIN WITH SHATTERED ROCK SUBGRADE)
13	D-2 (HEADWALLS AND UNDERDRAIN)
14	D-4 (FLUSHING BASINS)
15	D-17 (DROP INLET - TYPE III)
16	E-1 (BARRICADES, SIGNS, AND LIGHTS)
17	E-31 (FEDERAL AID CONSTRUCTION IDENTIFICATION SIGNS)
18	G-2a (TWO CABLE GUARD RAIL AND ANCHORS)
19	G-4 (MARKER POSTS, GUIDE POSTS)
20	J-1 (PROJECT MARKERS, BOUNDARY MARKERS)
21-29	PLAN AND PROFILE SHEETS
30-36	BLANK
37-39	RIGHT-OF-WAY DETAIL SHEETS
40	DETAILS OF 6'x6' R.C. BOX EXTENSION AT STA. 124+70
41	REINFORCING DETAILS OF R.C. BOX EXTENSION
42	STEEL SCHEDULE, R.C. BOX EXTENSION
43-69	CROSS-SECTIONS
70	CURVE BANKING TRANSITION DIAGRAMS
SHEETS ADDED IN FINALS	
1-15	DRAINAGE
1-3	FINAL EARTHWORK SHEETS

STATE OF VERMONT
DEPARTMENT OF HIGHWAYS
PROPOSED IMPROVEMENT

FEDERAL AID SECONDARY PROJECT

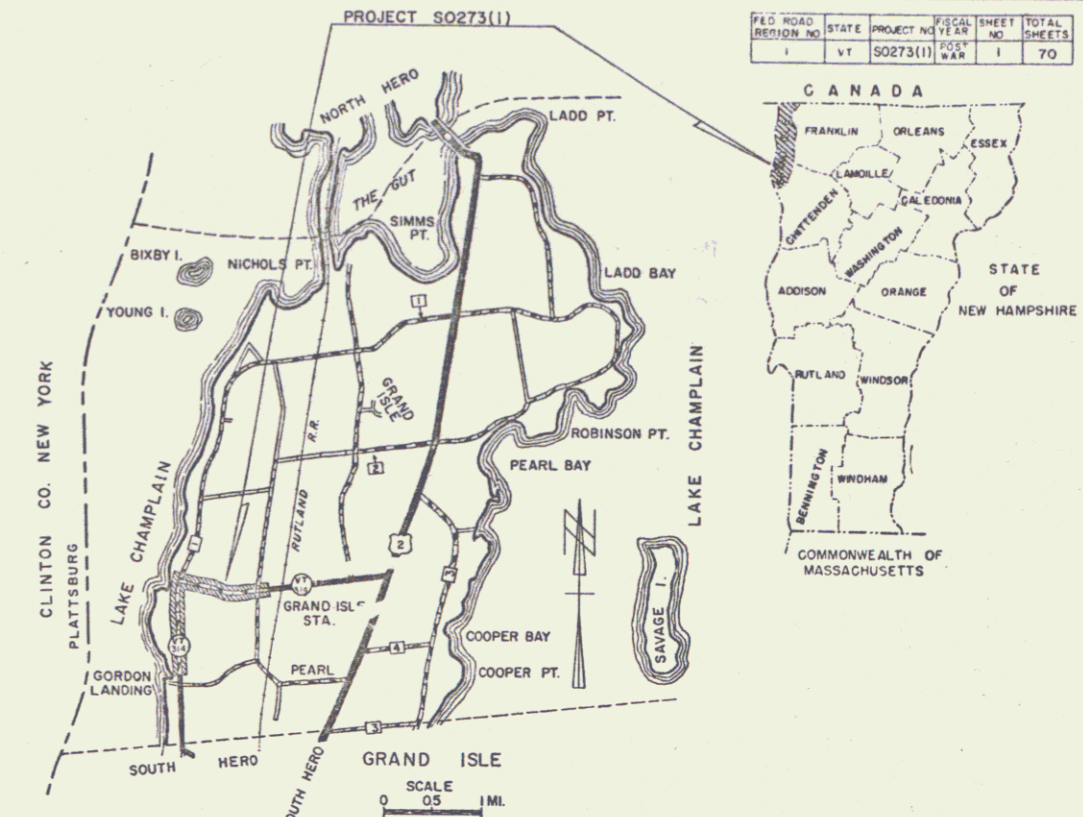

NOTE: FOR RIGHT-OF-WAY DETAILS SEE RIGHT-OF-WAY PLANS FOR THIS PROJECT.

BENCH MARK DATA BASED ON ASSUMED ELEVATIONS

CONTRACTOR: FLOW & COTE, INC. & E.O. MORTIN
RESIDENT ENGINEER: R.W. JENSEN
INSPECTORS: R. FULLER & R. PETERS
RECORD PLANS: R.R. RUSSELL & R.W. JENSEN
CONTRACT DATED: DEC 22, 1965
STARTED: APRIL 4, 1966
COMPLETED: SEPT 7, 1966
ACCEPTED: SEPT 9, 1966

TOWN OF GRAND ISLE
COUNTY OF GRAND ISLE
VERMONT ROUTE 314
SOUTH HERO - GRAND ISLE STATION ROAD

BEGINNING AT A POINT 0.6 MILE NORTHERLY OF THE SOUTH HERO - GRAND ISLE TOWN LINE AND EXTENDING NORTHEASTERLY 2.013 MILES
LENGTH OF PROJECT: 10,628.6 FEET = 2.013 MILES

RIGHT-OF-WAY DIVISION
TOWN FILE
PERPETUAL

Pin# 99R684
Town of Grand Isle
(To Be Returned To R.O.W. Division)

CONVENTIONAL SIGNS

RIGHT-OF-WAY	SR	GR
SLOPE RIGHTS		
COUNTY LINE		
TOWN LINE		
FENCE LINE		
STONE WALL		
UNFENCED PROPERTY		
GUARD RAIL		
TRAVELED WAY		
RAILROAD		
RETAINING WALL		
CENTER LINE		
SURVEY LINE		
CULVERT		
DROP INLET		
TROLLEY POLE		
POWER POLE		
TELEPHONE POLE		
TREES		
HEDGE		

CONTRACTOR	FLOW & COTE, INC. & E.O. MORTIN
RESIDENT ENGINEER	R.W. JENSEN
INSPECTORS	R. FULLER & R. PETERS
RECORD PLANS	R.R. RUSSELL & R.W. JENSEN
CONTRACT DATED	DEC 22, 1965
STARTED	APRIL 4, 1966
COMPLETED	SEPT 7, 1966
ACCEPTED	SEPT 9, 1966
PROJECT	GRAND ISLE
NUMBER	S 0273 (1)
TYPE	TACK COAT TYPE X
LENGTH	2.013 MI.
LOCATION	South Hero - Grand Isle Station Road
LOCATION BEGINNING AT	0.6 mile northerly of the South Hero - Grand Isle Town Line
LOCATION ENDING AT	2.013 miles northeasterly

SOUTH EAST OF SA-1 OF SA-1	
1964 ADT	150 - 120
1985 ADT	250 - 200
1985 DMV	50 - 50
V	40 MPH
D	69
T	4

121+00 - 232+26
CONSTRUCTION AREA

PLAN SCALE
0 500 FEET

METAL CULVERT PIPE - NORTHEASTERN CULVERT CORP., WESTMINSTER, VT.
GUARD RAIL ITEM/S - S.T. CRISWOLD & CO., WINOOSKI, VERMONT
COPPER WATER TUBE - SCOVILLE MFG., WATERBURY, CONN.

PROJECT NAME & NUMBER	TYPE	PAYMT AREA
GRAND ISLE S 0273(1)	TACK COAT TYPE X	23.61751
RECORD PLANS		
MATERIALS		
SUBBASE OF SAND - WILCOT PIT, COLCHESTER, VT.		
CEMENT - MARQUETTE CEMENT CO. CATSKILL, N.Y.		
CONCRETE - A.G. ANDERSON READY MIX, SWANTON, VT.		
TAR - WITCO CHEMICAL CO., WORCESTER, MASS.		
ASPHALT - ATLANTIC REFINING, ALBANY, N.Y.		
PEA STONE, SAND, GRITS - DFMER'S FIT. WINOOSKI, VT.		
REINF. STEEL - VERMONT STRUCT. STEEL CORP. BURLINGTON, VERMONT		

THESE PLANS ARE SUBJECT TO SUCH REVISIONS AS MAY BE REQUIRED BY THE BUREAU OF PUBLIC ROADS OR THE COMMISSIONER OF HIGHWAYS.
CONSTRUCTION IS TO BE CARRIED ON IN ACCORDANCE WITH THESE PLANS AND THE STANDARD SPECIFICATIONS FOR HIGHWAY AND BRIDGE CONSTRUCTION, DATED APRIL 1964, AS APPROVED BY THE BUREAU OF PUBLIC ROADS ON OCTOBER 12, 1964, INCLUDING ALL SUBSEQUENT APPROVED REVISIONS AND SUCH REVISED SPECIFICATIONS AND SPECIAL PROVISIONS AS ARE INCORPORATED IN THESE PLANS.

APPROVED: <i>[Signature]</i> ASST. CHIEF ENGINEER DATE: 9/22/66	APPROVED: <i>[Signature]</i> SECONDARY ENGINEER DATE: 9/22/66	APPROVED: <i>[Signature]</i> DISTRICT ENGINEER DATE: 9/23/66	APPROVED: <i>[Signature]</i> BRIDGE ENGINEER DATE: 9/23/66	APPROVED: <i>[Signature]</i> DISTRICT ENGINEER DATE: 9/24/66	APPROVED: <i>[Signature]</i> SUPERVISOR DATE: 9/24/66	APPROVED: <i>[Signature]</i> CHIEF ENGINEER DATE: 9/24/66
---	---	--	--	--	---	---

DEPARTMENT OF COMMERCE BUREAU OF PUBLIC ROADS	
APPROVED	DATE
DIVISION ENGINEER	DATE
PROJECT S NO. 0273(1)	
SHEET 1 OF 70 SHEETS	