


CONSTRUCT DRIVE
 136+50
 141+50
 149+21

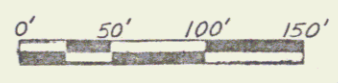

VERMONT DEPARTMENT OF HIGHWAYS
 RIGHT - OF - WAY PLANS
 PROJECT: GRAND ISLE
 No. S.0273(1)
 SHEET 9 OF 23

5