
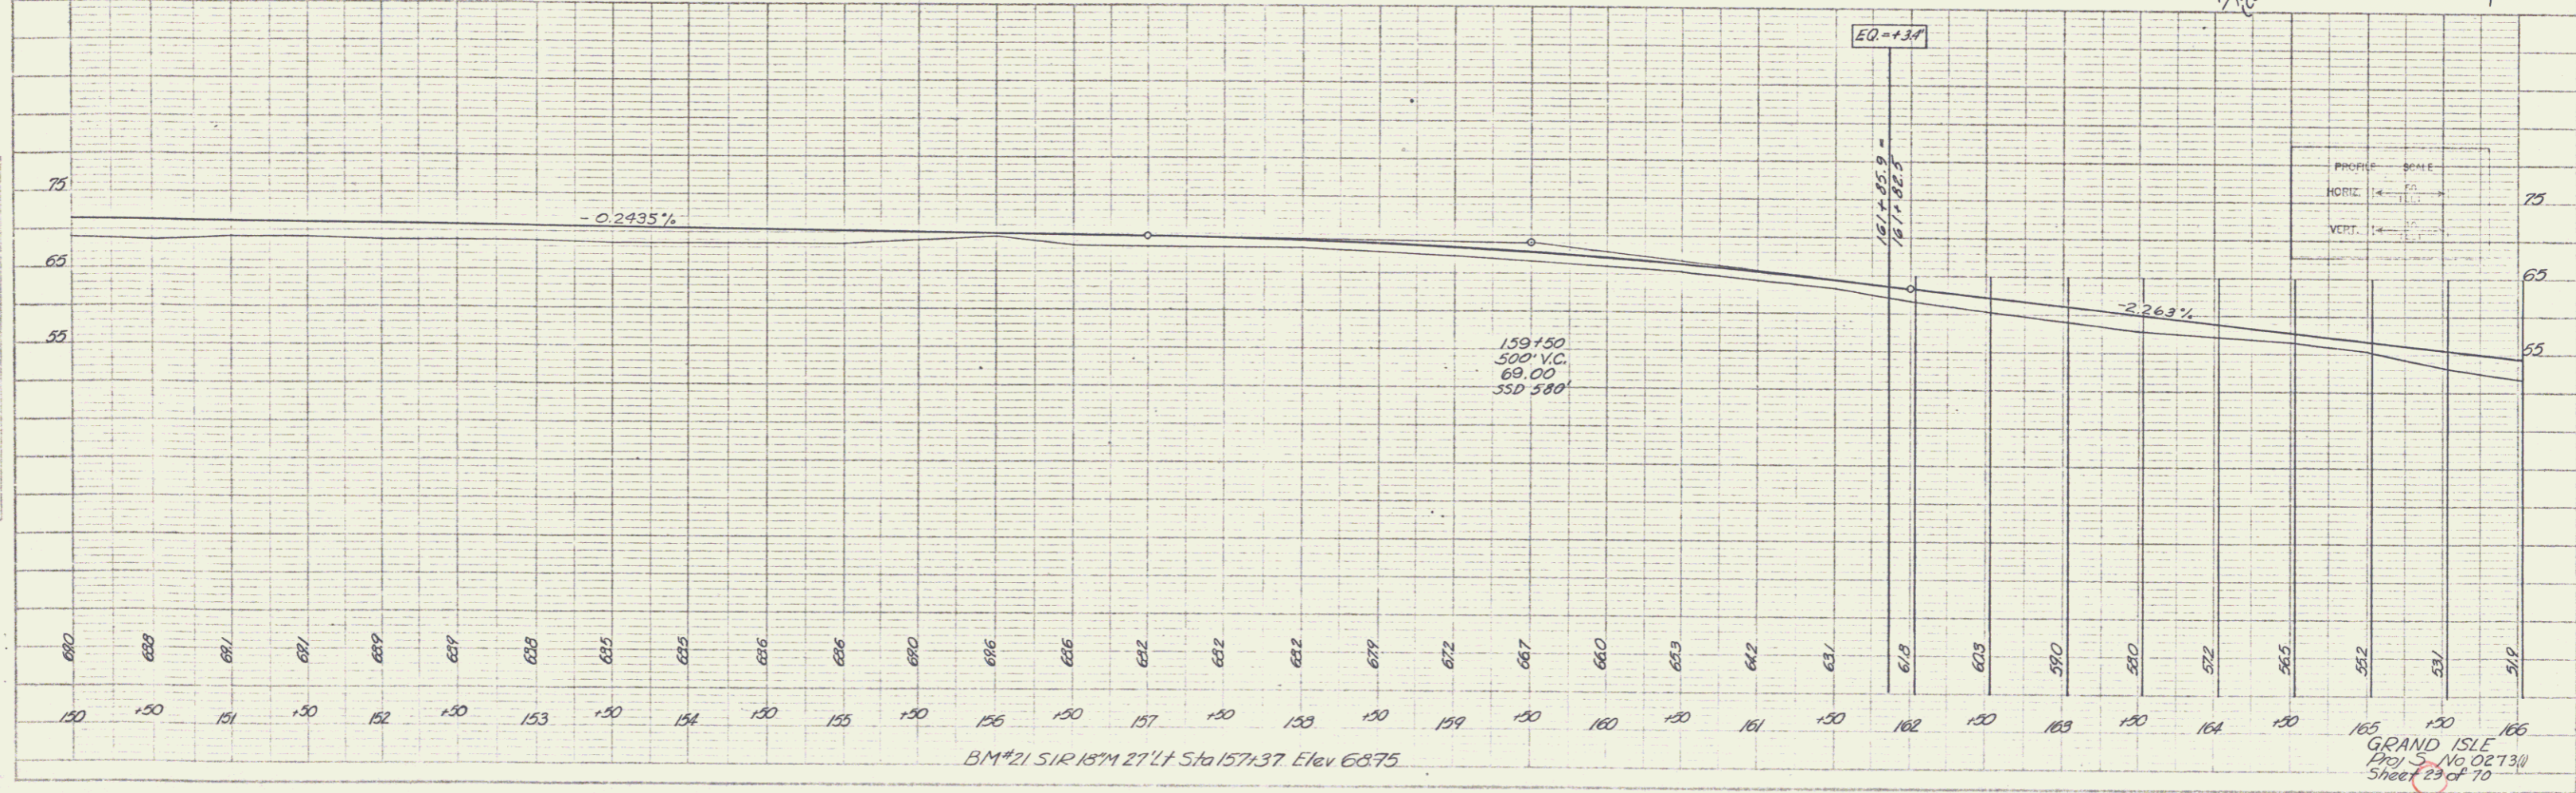


PLAN
 DATE 1/15
 DRAWN BY Duino
 CHECKED BY Camarero
 SCALE 1/15

PROFILE
 DATE 1/15
 DRAWN BY Duino
 CHECKED BY Camarero
 SCALE 1/15

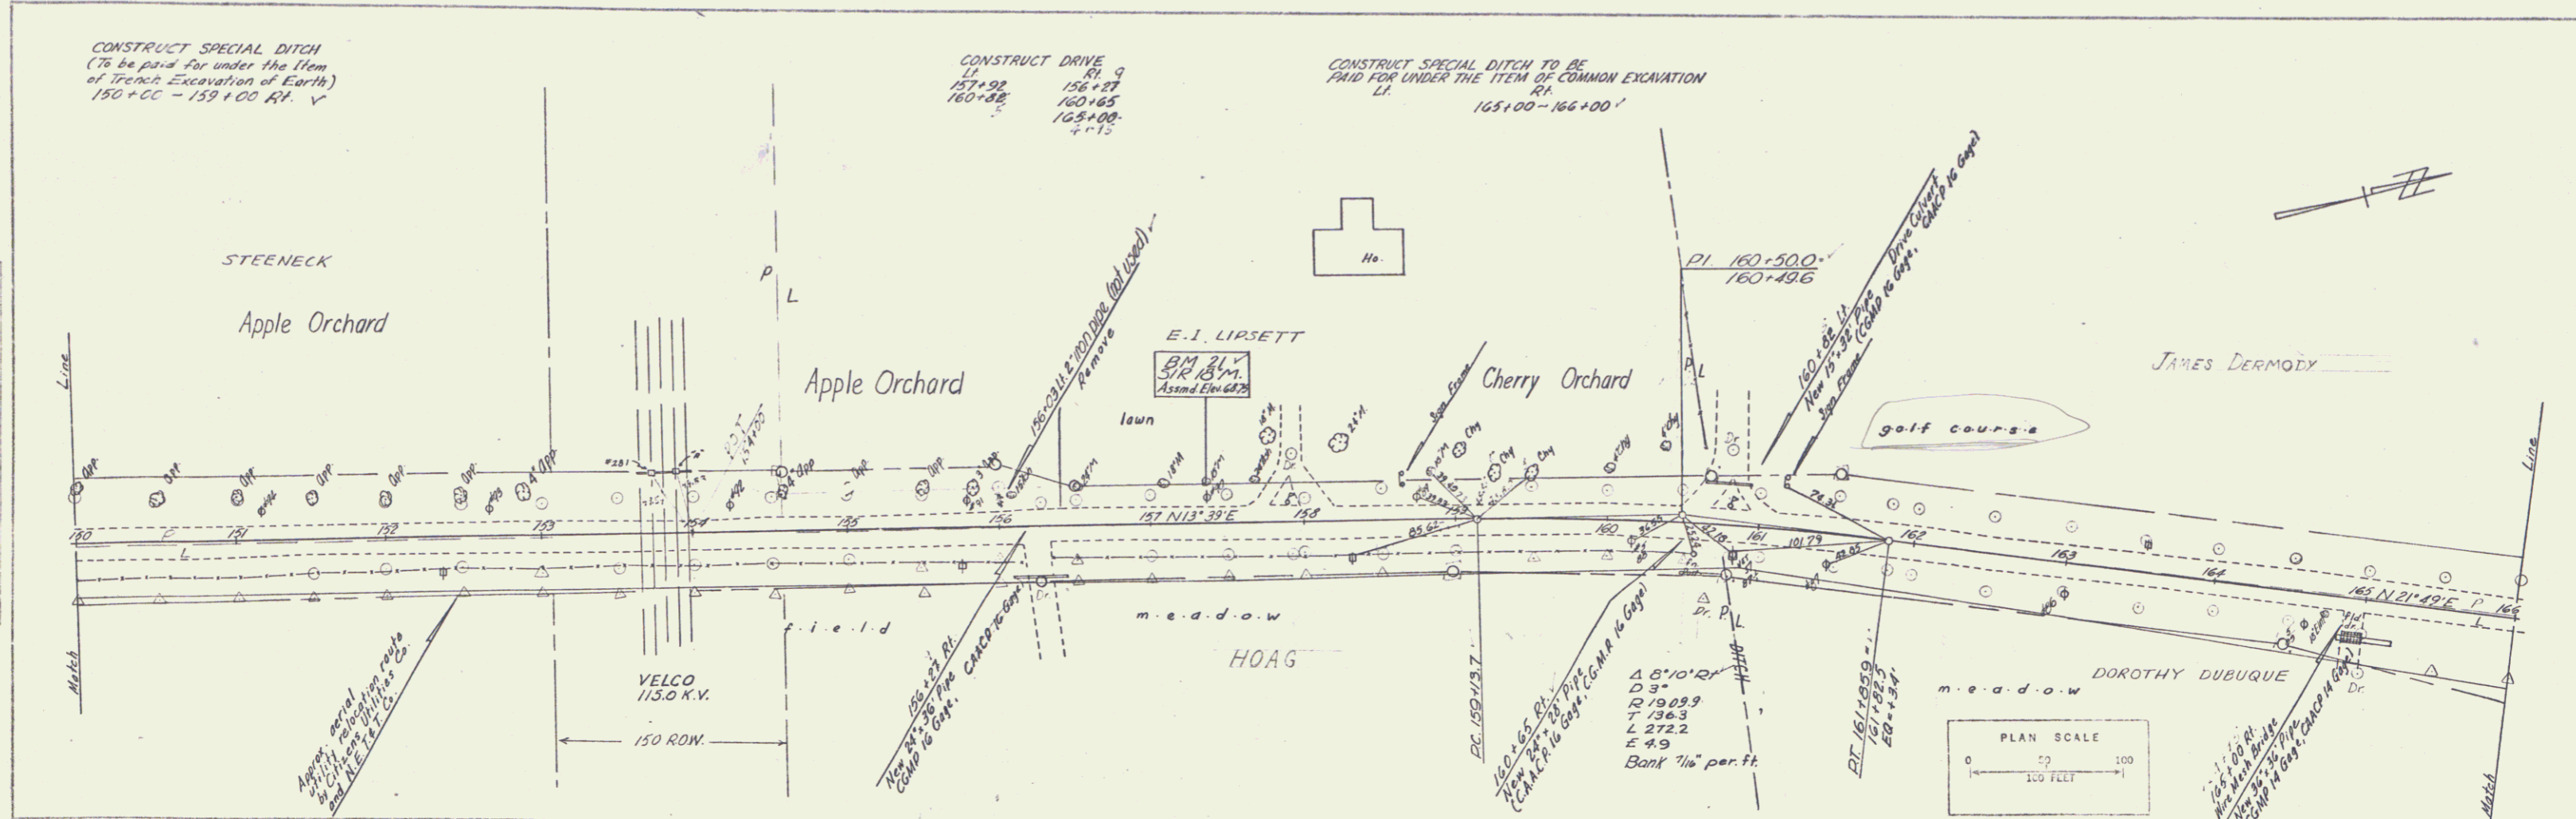

6