


CONSTRUCTION DATE
12/12/64

CONTRACT NO. 100-100-100

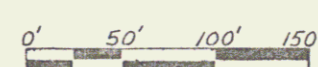

VERMONT DEPARTMENT OF HIGHWAYS
 RIGHT-OF-WAY PLANS
 PROJEC: GRAND ISLE
 NO. 50273(1)
 SHEET 10 OF 23
 Revised 11/12/64