
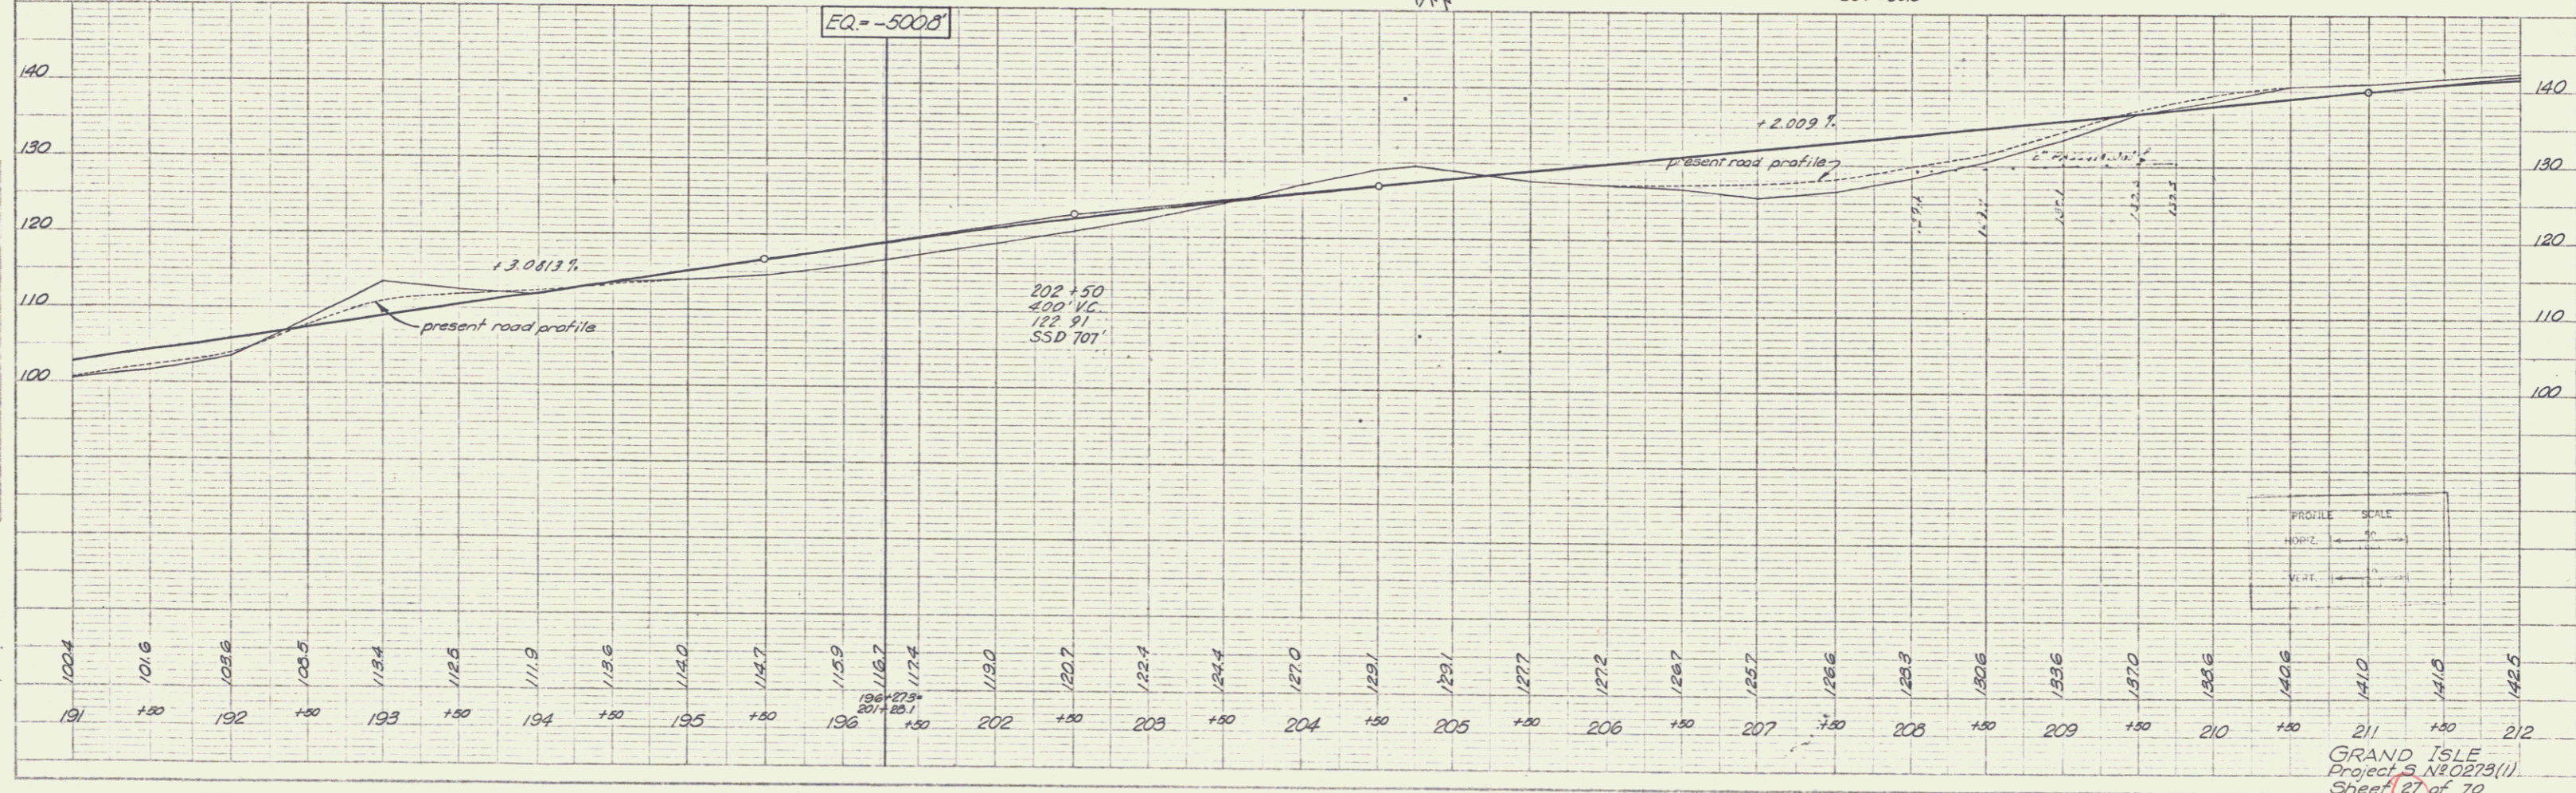


PLAN
 TAYLOR/DALTON
 7/88
 CEH

PROFILE
 TAYLOR/DALTON
 7/88
 CEH

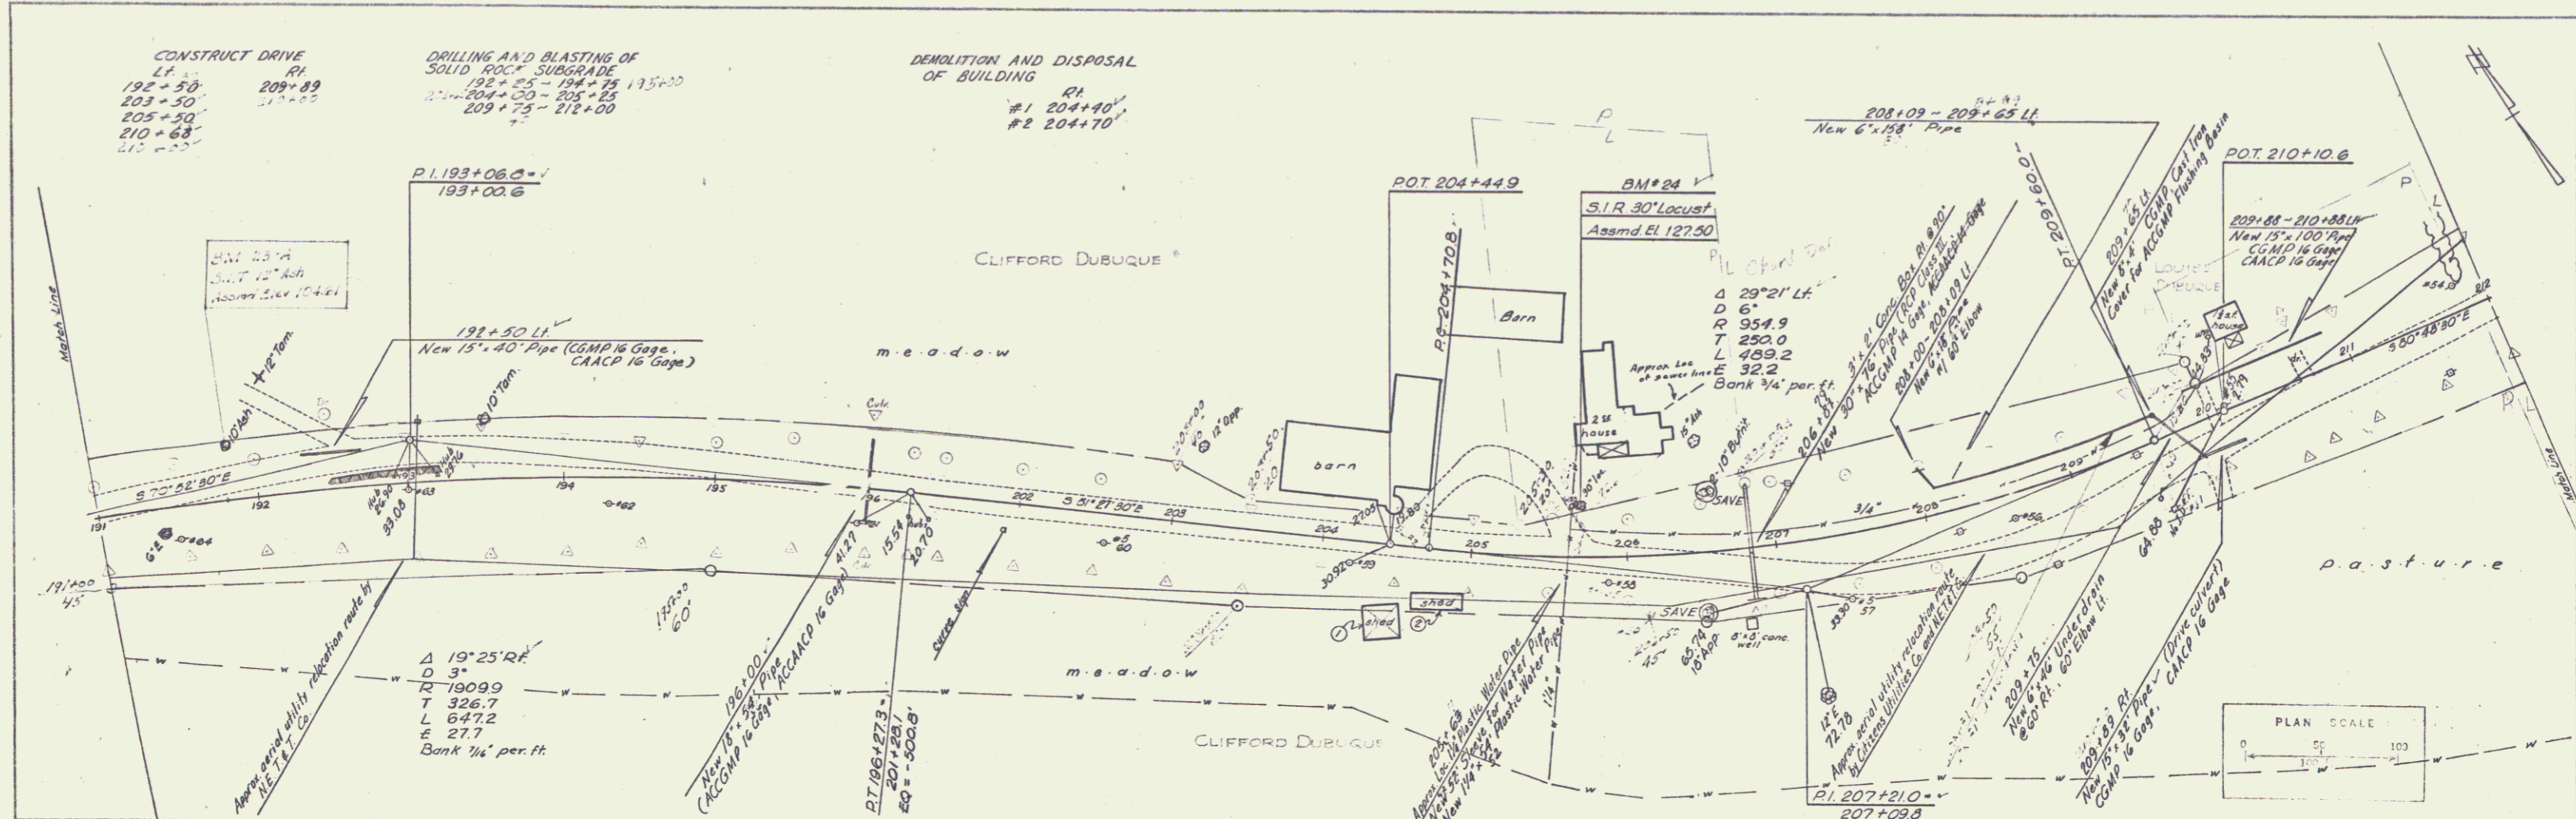

GRAND ISLE
 Project 5 N0273(II)
 Sheet 27 of 70