
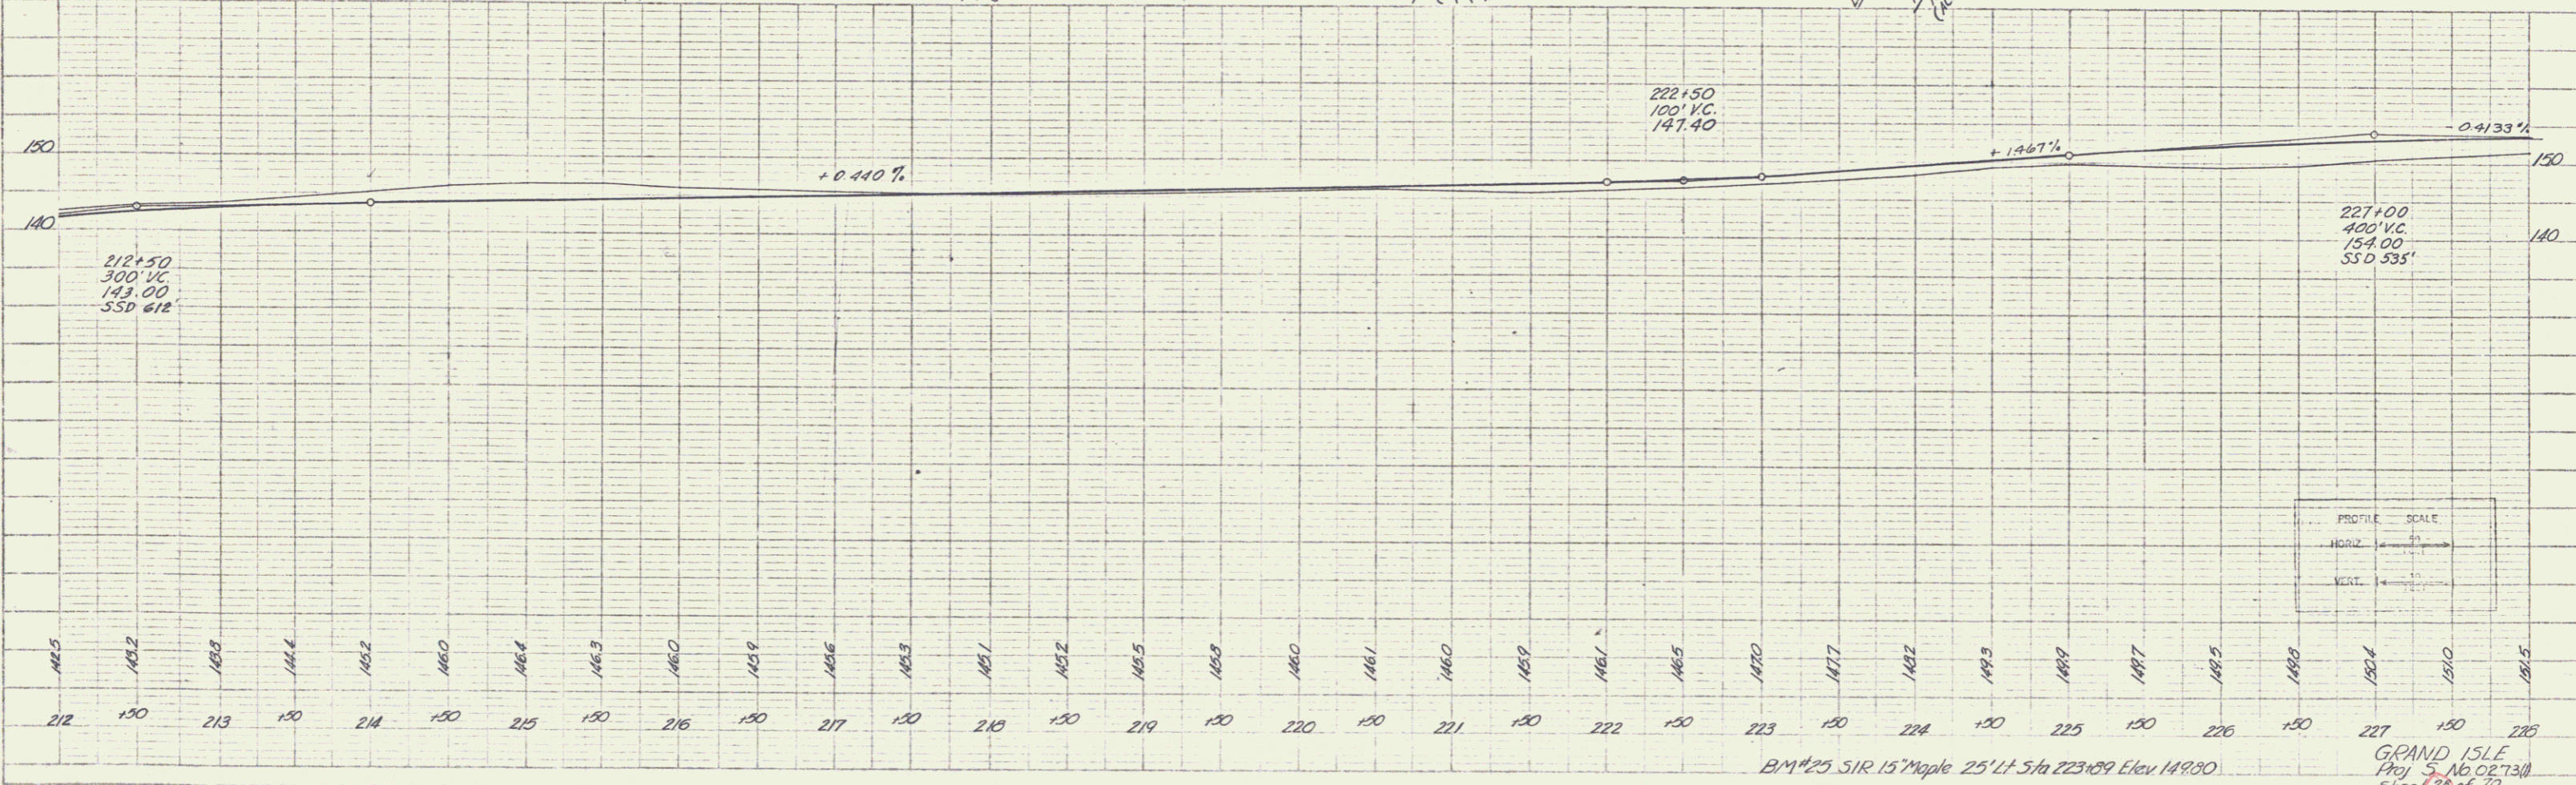


PLAN	DATE	BY
1/15	1/15	1/15
1/15	1/15	1/15
1/15	1/15	1/15

PROFILE	DATE	BY
1/15	1/15	1/15
1/15	1/15	1/15
1/15	1/15	1/15

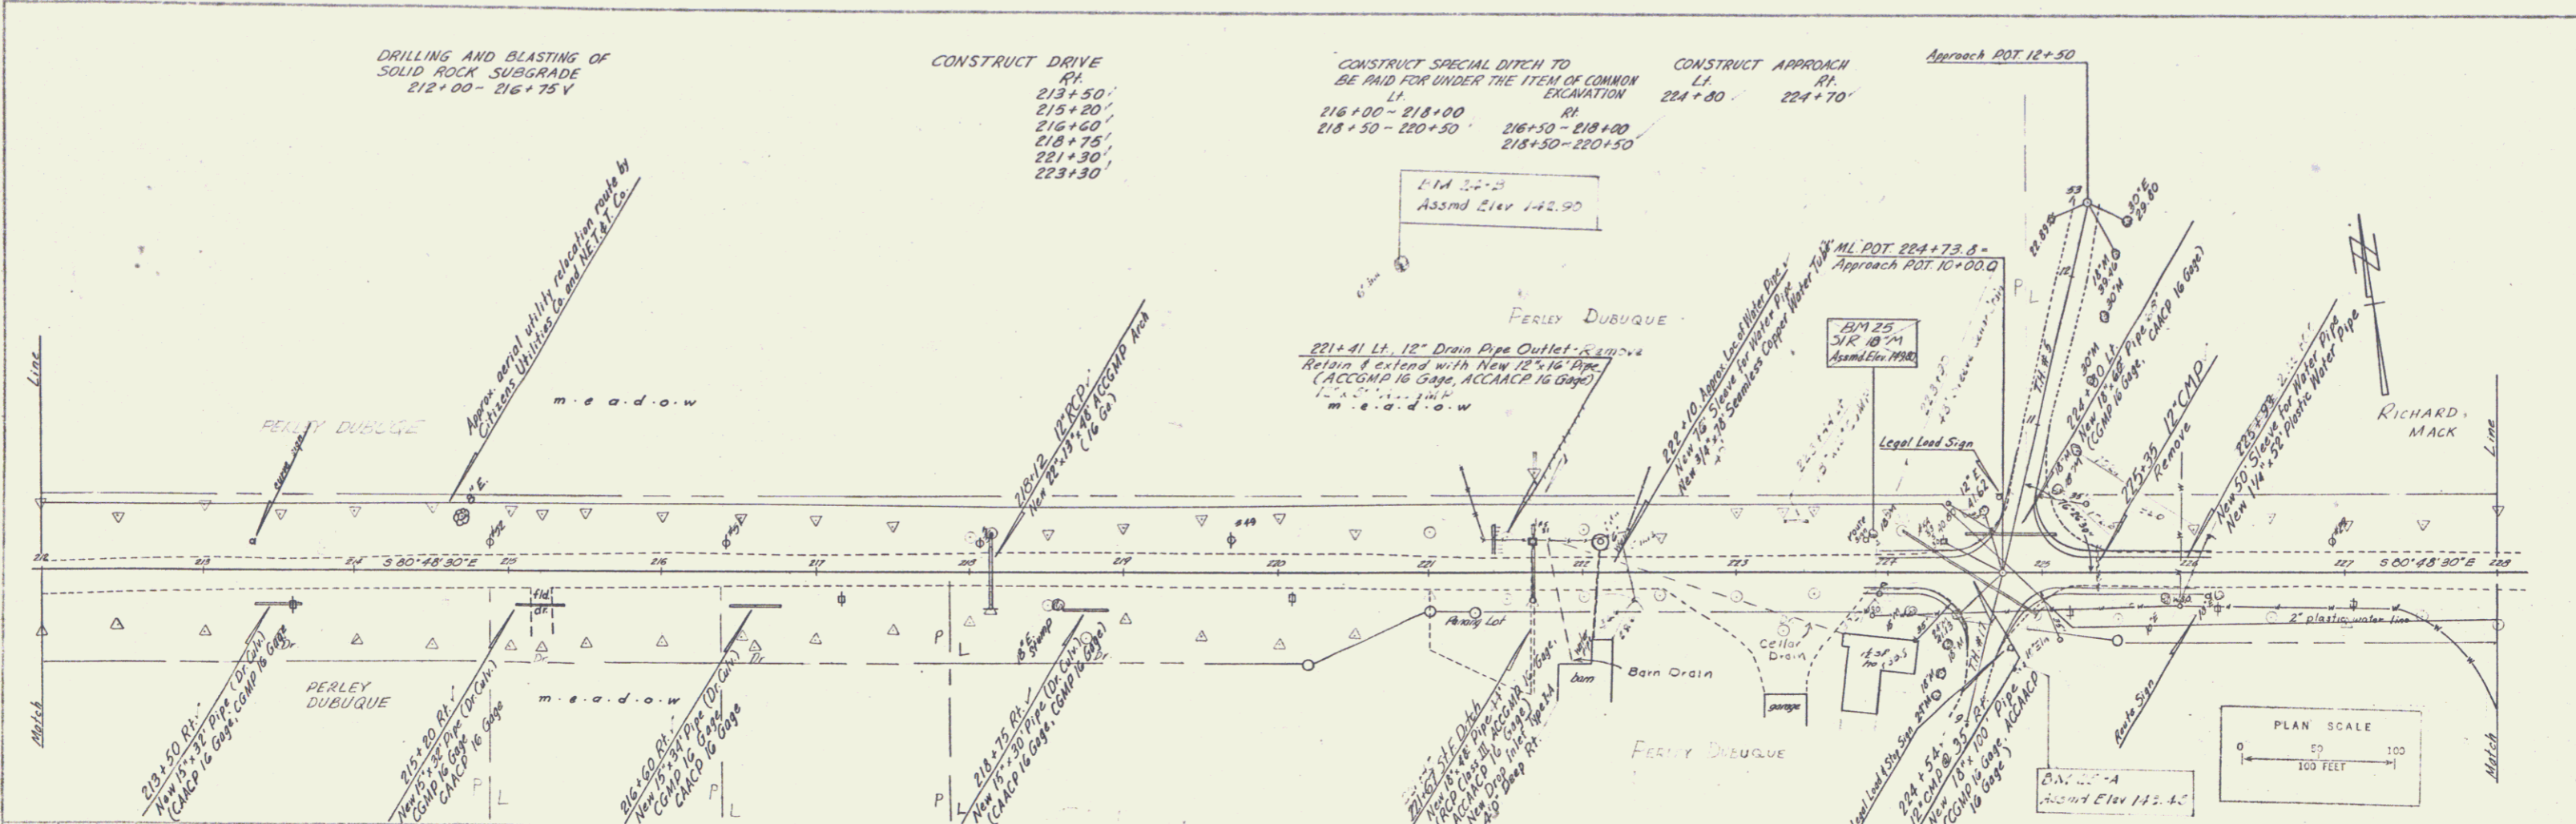

B.M. #25 S1R 15' Maple 25' Lt Sta 223+89 Elev 149.80
 GRAND ISLE
 1901 S. AD. 02730
 Sheet 26 of 75