
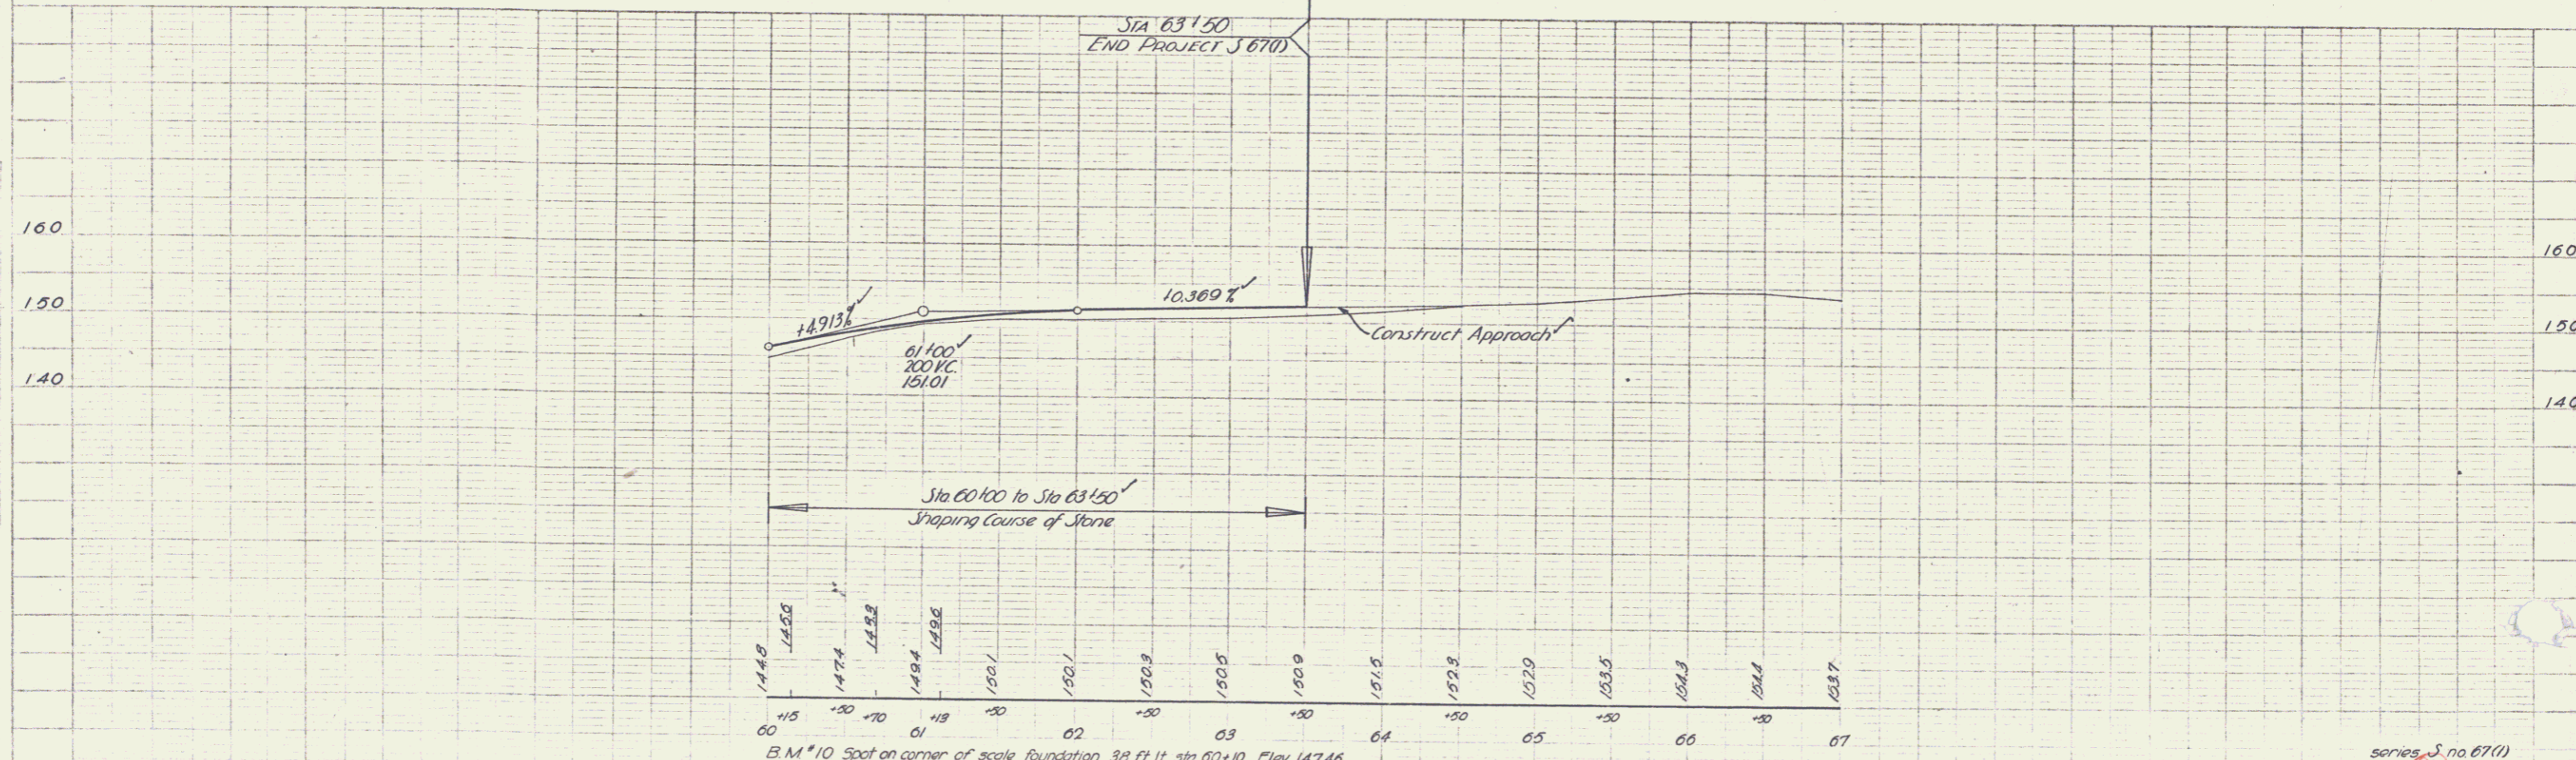


CONSTRUCT DRIVES
 6' Sub base of Gravel
 12" R.L.
 Stationing Sta 60+70 to Sta 61+13'

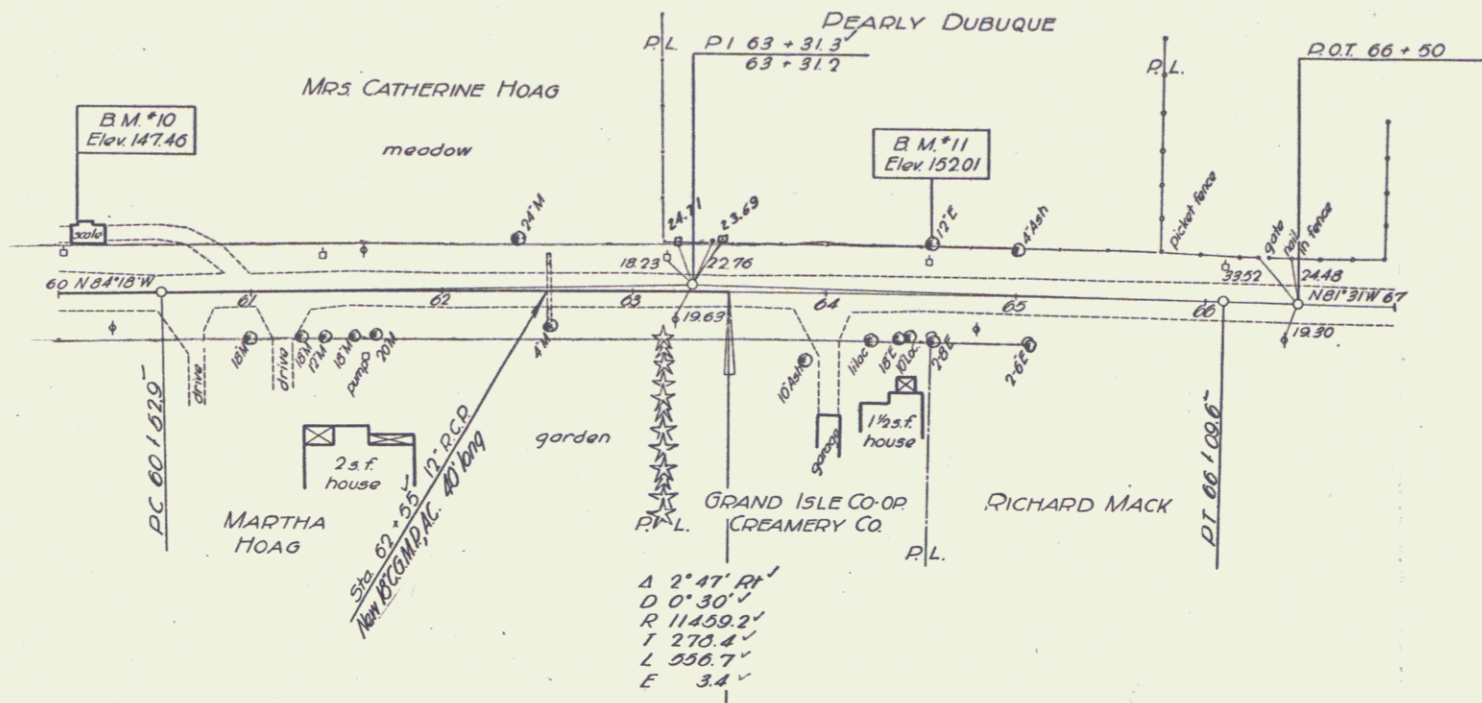

B.M. #10 Spot on corner of scale foundation 38 ft 11 in sta 60+10 Elev 147.46
 B.M. #11 Spike in roof of 12' x 12' 2 1/2 in. ft. sta. 64+54 Elev. 152.01

series J no 67(1)
 sheet 22 of 22 sheets
 GRAND ISLE

PLN
 8-27
 9-27
 9-27

PLN
 8-27
 9-27
 9-27